Frank & Kristine Petralito $175 10

IREDELL COUNTY HEALTH DEPARTMENT

STATESVILLE 704-878-5305 MOORESVILLE 704-664-5281

IMPROVEMENT PERMIT / AUTHORIZATION TO CONSTRUCT / OPERATION PERMIT / EXISTING SYSTEM INSPECTION

PERMIT# 09493 PIN# 4625 94 (684 pt) 4625-53-8072 DATE June 7, 01

OWNER OR CONTRACTOR Crescent Resources Inc / Dienst PHONE: Business Home

ADDRESS P.O. Box 1033 Charlotte NC 28201

LOCATION Brawley Sch. Rd. TR Athlebone 10th on Right

SUBDIVISION The Point I BLOCK / SECTION 7 LOT 703/703A LOT AREA 32958 + 24,600sf SITE CLASS. RS SFE DESIGN FLOW 600gpd L.T.A.R. .3

Septic Tank: 1500 Gallons; STB 338 Date 12-21-02
Pump Tank: 1500 Gallons; PT 338 Date 10-11-02
Pump Make: Model Serial No.
Nitrification Field: No Fields 1 Square Feet 1500 Linear Feet 500
No Lines 6 Trench Width 36" Max Trench Bottom Depth 36" Gravel Depth NA

☑ New System ☐ Repair System Type: I, II, III, IV, V, VI
System Description: Pm - Innovative - 25% Red.
Repair System Description: LP Innovative - 25% Red
Maintenance Agreement Required: ☐ Yes ☑ No initially

☑ House/Mod. Home No. Bedrooms 5
☐ Mobile Home No. Bathrooms 4
☐ Business No. Employees
☐ Other


☐ Slab ☐ Crawl Space ☑ Basement w/plumbing ☐ Basement wo/plumbing

Water Supply: ☐ Individual ☑ Public ☑ Community

Comments:/Conditions: Reviewed building & site plans 8-7-2002, in compliance with Septic permit. Across from #708

Comments:/Conditions: Septic system sized for 5 bedrooms (building plans for 4 Bedrooms) Checked lines 11/20/2002 MD Tanks checked 2/21/03

INITIAL SITE SKETCH

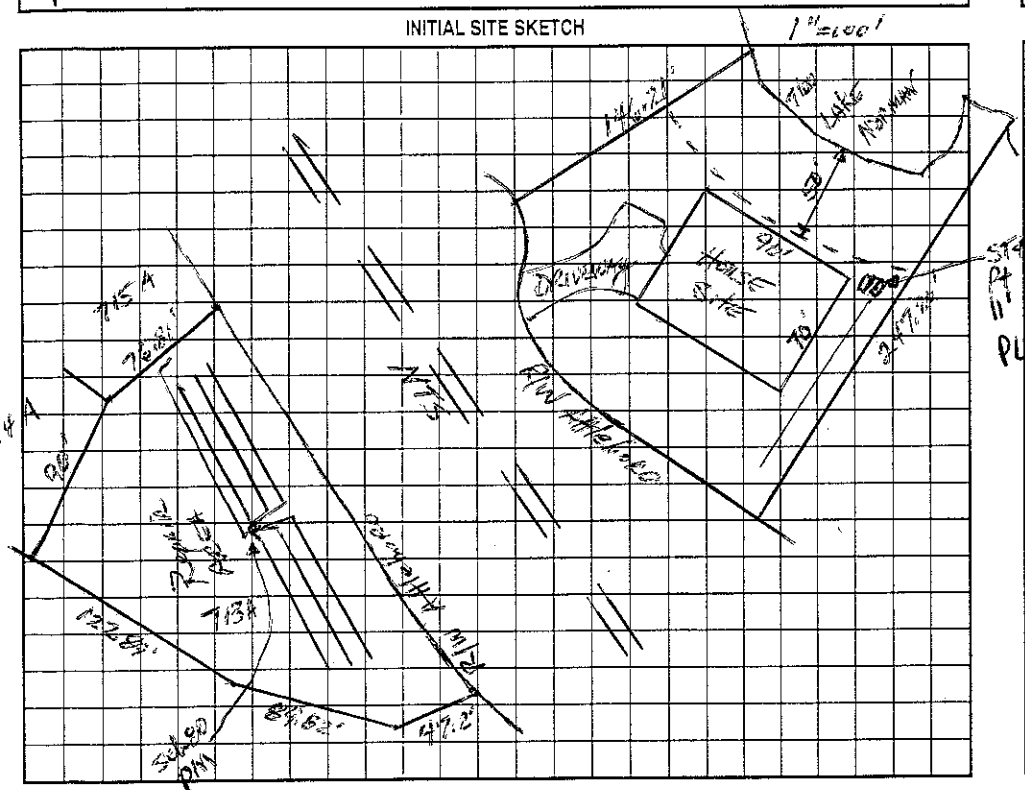

AS BUILT SKETCH Press., elect & alarm

Installed EZ Flow 3/5/2003
Drainfield

Permit can be suspended or revoked if any false information is supplied toward securing the permit/any unauthorized changes are made to the site/any unauthorized changes are made in the installation of the system. Improvement Permit with plat valid without expiration. Improvement Permit with site plan valid for sixty months. Authorization to Construct is valid for a period equal to that of Improvement Permit – not to exceed sixty months.

Signed: date 6-15-01 Installed by: R & H RS

Improvement Permit by: date 6-7-01 Operation Permit by: Maria H. Dotson RS date 3/5/2003

Authorization to Construct by: Maria H. Dotson RS 8-7-02 Existing System Inspection by: date

HEALTH DEPT. COPY: WHITE OWNER COPY (FINAL): YELLOW OWNER COPY (INITIAL): PINK