(3100)

IREDELL COUNTY HEALTH DEPARTMENT Const. Auth. STATESVILLE 704-878-5305 MOORESVILLE 704-664-5281

IMPROVEMENT PERMIT / ~~CERTIFICATE OF COMPLETION~~ / OPERATION PERMIT / EXISTING SYSTEM INSPECTION

PROPERTY DESCRIPTION NO. 25771 DATE May 16, '97 TAX MAP NO. part of 2CA3 4625 56 1821 Watershed: ☑ Yes ☐ No

OWNER OR CONTRACTOR Crescent Resources clnc. PHONE: Business _____ Home _____

ADDRESS P.O Box 1003 Charlotte

LOCATION Brawley Sch Rd. TR Bay Harbours TL Lake Mist on left near end

SUBDIVISION The Harbours BLOCK / SECTION 4 LOT 14, 14A LOT AREA ~ 1Ac. SITE CLASS. PS DESIGN FLOW 480 gpd L.T.A.R. .3

Septic Tank: 1000 Gallons; STB 794 Date 3-12-97

Pump Tank: 1000 Gallons; PT 27 Date 4-4-97

Pump Make: H40RD. Model SHEF50A1 Serial No. 3/99

Nitrification Field: No Fields 1 Square Feet 1200 Linear Feet 400

No Lines 5@80 Trench Width 36" Trench Bottom Depth 36" Gravel Depth N/A

☑ New System ☐ Repair System Type: I, II, (III), IV, V, VI

System Description: pm chambered

Repair System Description: LP Panel Block

Maintenance Agreement Required: ☐ Yes ☑ No

☑ House/Mod. Home No. Bedrooms 4

☐ Mobile Home No. Bathrooms 4

☐ Business No. Employees ____

☐ Other ____

☑ Slab ☐ Crawl Space ☑ Basement w/plumbing ☐ Basement wo/plumbing


Water Supply: ☐ Individual ☑ Community ☐ Public

Comments: * ONE INSPECTION/Observation port per LATERAL


Comments: partial

1" = 100'

INITIAL SITE SKETCH

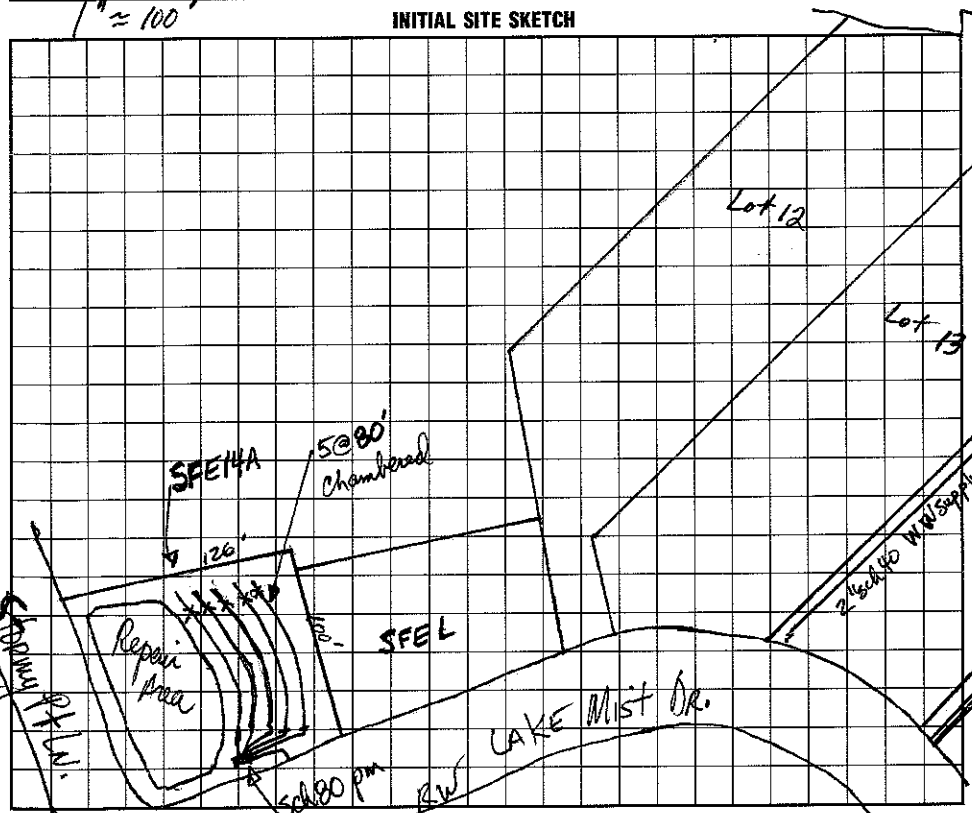

AS BUILT SKETCH

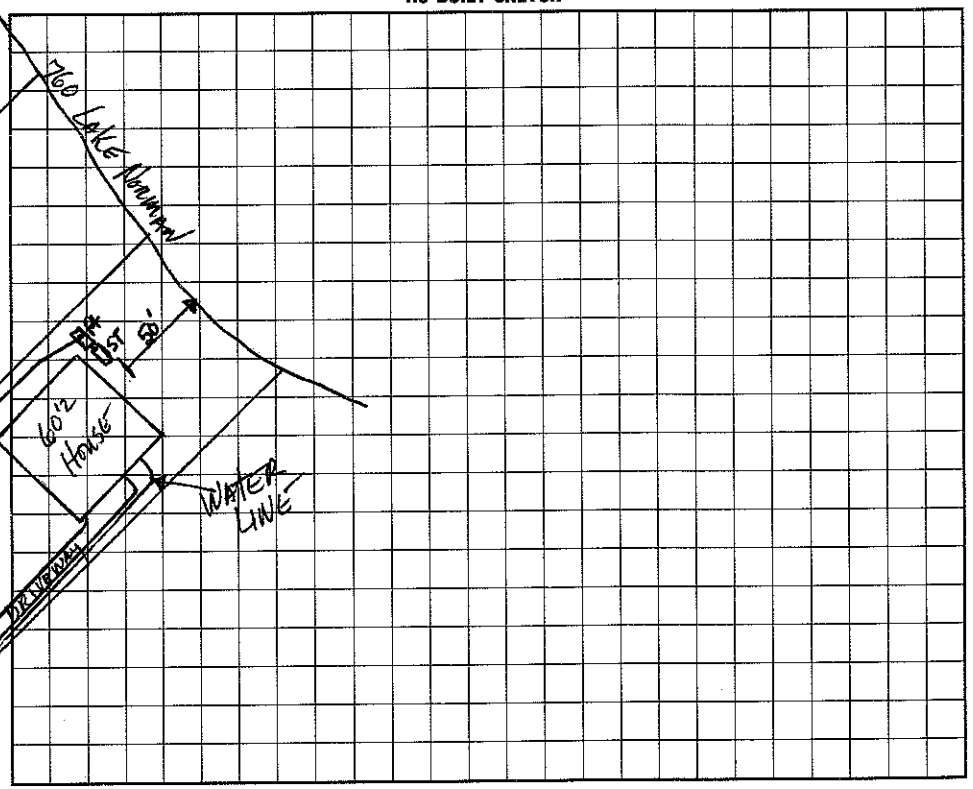

I understand that this permit can be ~~suspended~~ or revoked if any false information is supplied toward securing the permit/any unauthorized changes are made to the site/any unauthorized changes are made in the installation of the system.

Signed: * Paul C. Ross

Improvement Permit by: [illegible] RS date 5-16-97

~~Construction~~ Existing System Inspection by: Marsha H. Dotson RS date 12/29/98

Authorization

Installed by: Macleod Const.

Certificate of Completion by: Wesley Sparks RS. date 8/3/99

Operation Permit by: Wesley Sparks RS date 8/3/99

HEALTH DEPT. COPY: WHITE INSPECTION COPY (FINAL): GREEN OWNER COPY (FINAL): YELLOW INSPECTION COPY (INITIAL): PINK OWNER COPY (INITIAL): GOLD