(2:30)

IREDELL COUNTY HEALTH DEPARTMENT

Const. Auth. STATESVILLE 704-878-5305 MOORESVILLE 704-664-5281

IMPROVEMENT PERMIT / ~~CERTIFICATE OF COMPLETION~~ / OPERATION PERMIT / EXISTING SYSTEM INSPECTION

PROPERTY DESCRIPTION NO. 25756 DATE March 25, 97 TAX MAP NO. part of 2743 4625 562815 Watershed: ☑ Yes ☐ No

OWNER OR CONTRACTOR Crescent Resources Inc. (JOHN WIELAND) PHONE: Business _____ Home _____

ADDRESS PO Box 1003, Charlotte

LOCATION Brawley Sch Rd. TR Bay Harbour Rd. TL Lake Mist Dr. on left near end 271 Lake Mist

SUBDIVISION The Harbour BLOCK / SECTION 4 LOT 13 LOT AREA 20,000 ft² SITE CLASS. RS DESIGN FLOW 480 gpd L.T.A.R. n.25

Septic Tank: 1000 Gallons; STB 794 Date 2/23/98

Pump Tank: 1000 Gallons; PT 27 Date 3/26/99

Pump Make: HYDRO. Model SHEF 50A Serial No. 3/99

Nitrification Field: No Fields 1 Square Feet 1440 Linear Feet 480

No Lines 6 Trench Width 36" Max Trench Bottom Depth 36" Gravel Depth 10"

☑ New System ☐ Repair System Type: I, II, III, IV, V, VI

System Description: pumped in Chamber

Repair System Description: Some

Maintenance Agreement Required: ☐ Yes ☑ No

☑ House/Mod. Home No. Bedrooms 4

☐ Mobile Home No. Bathrooms 4

☐ Business No. Employees ____

☐ Other ____

☐ Slab ☑ Crawl Space ☑ Basement w/plumbing ☐ Basement wo/plumbing


Water Supply: ☐ Individual ☐ Community ☐ Public

Comments:


Comments: (PARTIAL)

INITIAL SITE SKETCH

1" = 50'

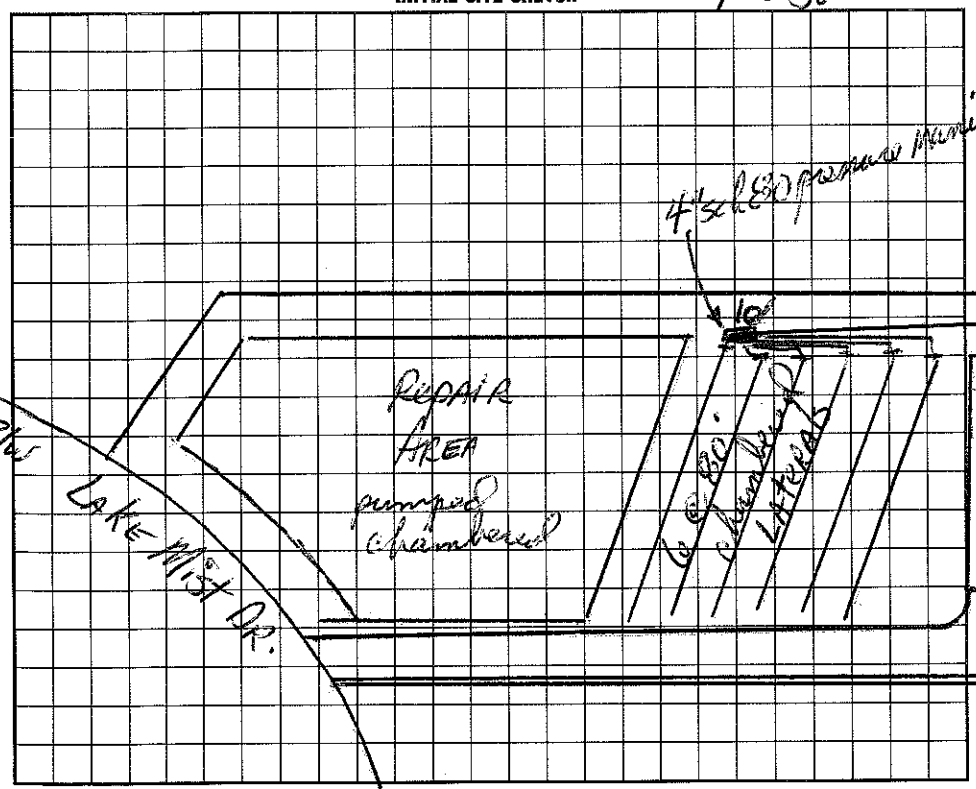

AS BUILT SKETCH

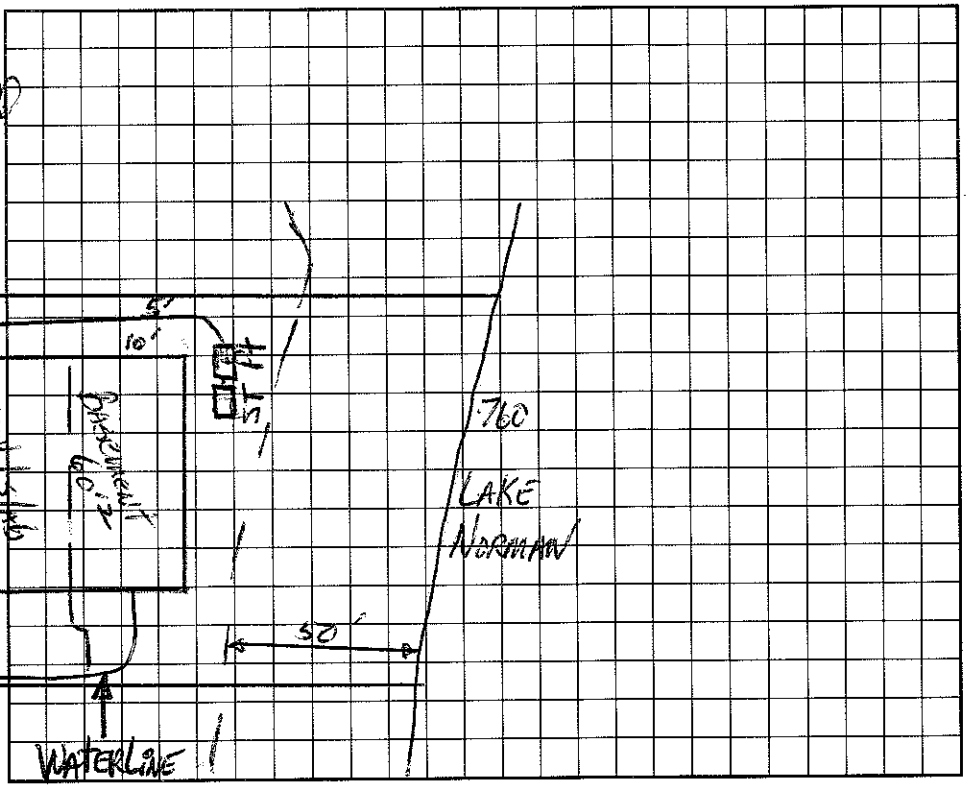

I understand that this permit can be suspended or revoked if any false information is supplied toward securing the permit/any unauthorized changes are made to the site/any unauthorized changes are made in the installation of the system. Improvement Permit is valid for 60 months from date of issuance.

Signed: Paul A. Long

Improvement Permit by: Mark Hamm RS date 3/25/97

~~Construction~~ Existing System Inspection by: Wesley Sparks RS. date 12/1/98

Authorization

Installed by: MacLeod Const.

Certificate of Completion by: Wesley Sparks RS date 8/3/99

Operation Permit by: Wesley Sparks RS date 8/3/99

HEALTH DEPT. COPY: WHITE INSPECTION COPY (FINAL): GREEN OWNER COPY (FINAL): YELLOW INSPECTION COPY (INITIAL): PINK OWNER COPY (INITIAL): GOLD