IREDELL COUNTY HEALTH DEPARTMENT

Const. Auth. STATESVILLE 704-878-5305 MOORESVILLE 704-664-5281

IMPROVEMENT PERMIT / ~~CERTIFICATE OF COMPLETION~~ / OPERATION PERMIT / EXISTING SYSTEM INSPECTION

PROPERTY DESCRIPTION NO. 25755 DATE March 25, '97 (JOHN WIELAND) TAX MAP NO. part of 2CA3 4625 56 3819 Watershed: ☑ Yes ☐ No

OWNER OR CONTRACTOR Concept Corporation Inc PHONE: Business _____ Home _____

ADDRESS PO Box 1003 Charlotte

LOCATION Iredell Quarry S.L. Rd. TR Bay Harbour Rd. TL LAKE Mist on left near end 267 LakeMist

SUBDIVISION The Harbour BLOCK / SECTION 4 LOT 12 LOT AREA > 20,000 ft² SITE CLASS. 15 DESIGN FLOW 460 gpd L.T.A.R. ~.3

Septic Tank: 1000 Gallons; STB 794 Date 11/2/98

Pump Tank: 1000 Gallons; PT 29 Date 8/13/99

Pump Make: HYDROMATIC Model SHEF 50M1 Serial No. 5/99

Nitrification Field: No Fields 1 Square Feet 1200 Linear Feet 400

No Lines 5 Trench Width 36" Max Trench Bottom Depth 36" Gravel Depth N/A

☑ New System ☐ Repair System Type: I, II, III, IV, V, VI

System Description: pumped pressure Manifold

Repair System Description: Same

Maintenance Agreement Required: ☐ Yes ☑ No

☐ House/Mod. Home No. Bedrooms 4

☐ Mobile Home No. Bathrooms 4

☐ Business No. Employees _____

☐ Other _____


☐ Slab ☑ Crawl Space ☑ Basement w/plumbing ☐ Basement wo/plumbing

Water Supply: ☐ Individual ☑ ~~Community~~ ☐ Public


Comments:

Comments: (PARTIAL)

INITIAL SITE SKETCH 1" = 50'

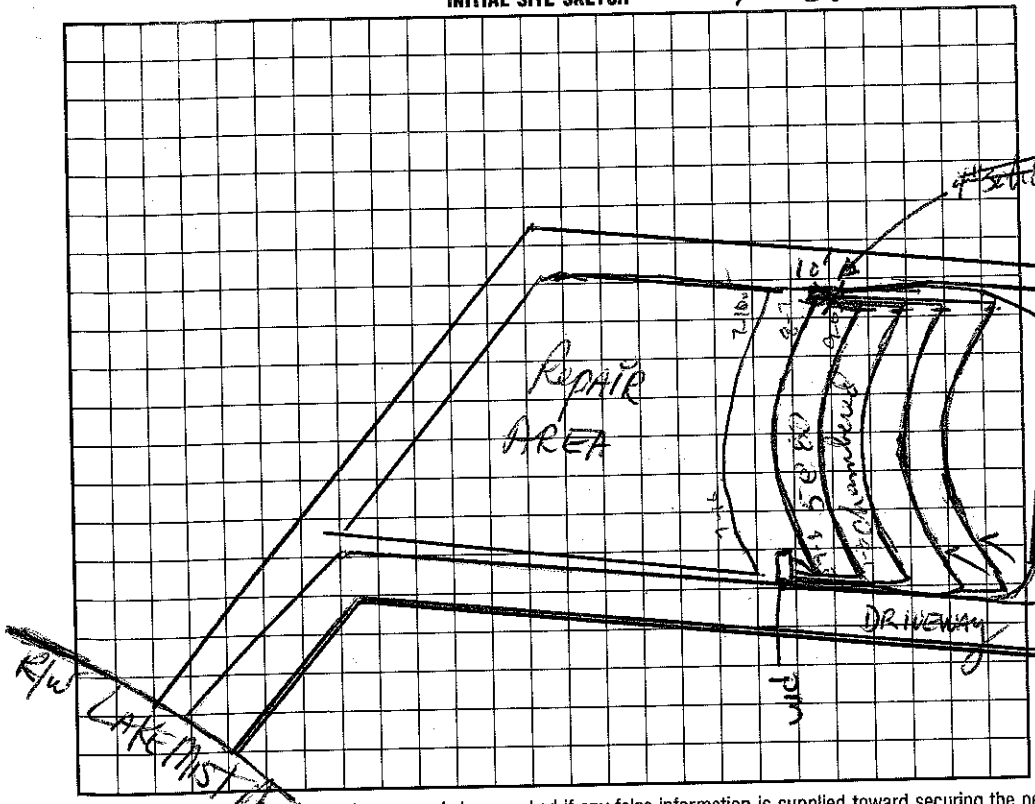

AS BUILT SKETCH

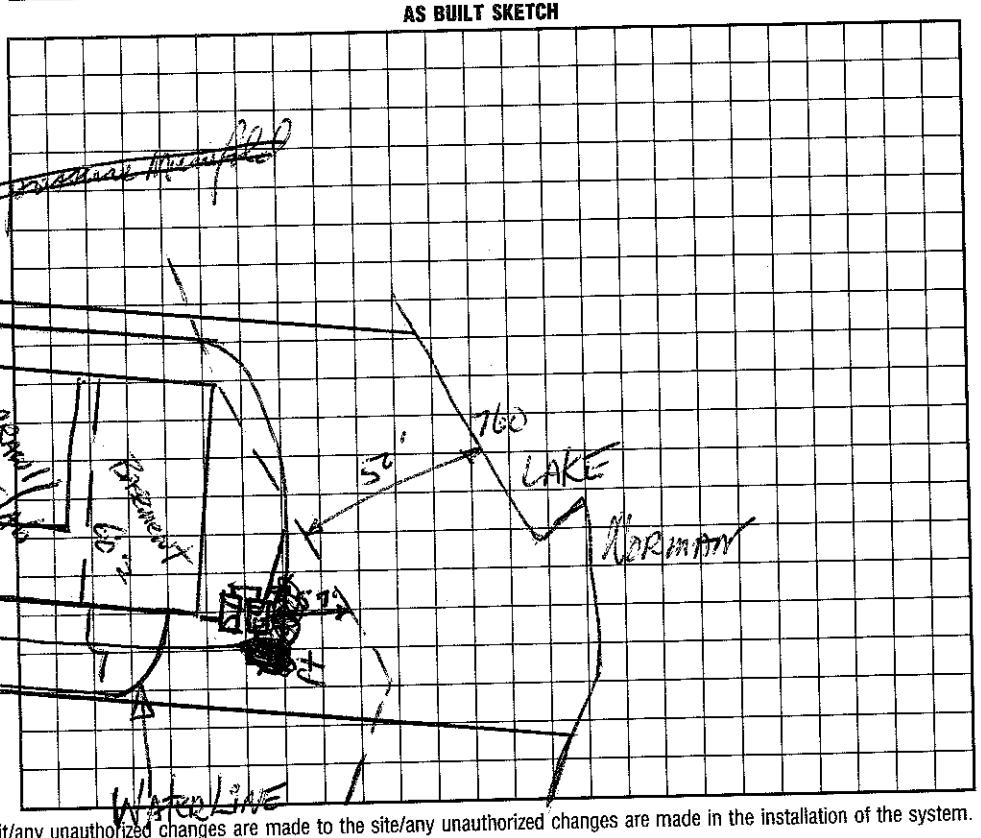

I understand that this permit can be suspended or revoked if any false information is supplied toward securing the permit/any unauthorized changes are made to the site/any unauthorized changes are made in the installation of the system. Improvement Permit is valid for 60 months from date of issuance.

Signed: _____

Improvement Permit by: _____ date 3-25-97

~~Existing System Inspection~~ Construction Authorization by: Wesley Sparks RS. date 11/3/98

Installed by: MacLeod Const. Co.

Certificate of Completion by: Wesley Sparks RS. date 11/15/99

Operation Permit by: Wesley Sparks RS. date 11/15/99

HEALTH DEPT. COPY: WHITE INSPECTION COPY (FINAL): GREEN OWNER COPY (FINAL): YELLOW INSPECTION COPY (INITIAL): PINK OWNER COPY (INITIAL): GOLD