IREDELL COUNTY HEALTH DEPARTMENT

STATESVILLE 704-878-5305 MOORESVILLE 704-664-5281

IMPROVEMENT PERMIT / ~~CERTIFICATE OF COMPLETION~~ / OPERATION PERMIT / EXISTING SYSTEM INSPECTION

PROPERTY DESCRIPTION NO 25754 DATE March 26, 1997 TAX MAP NO. part of 2CA3 4625 56 4903 Watershed: ☑ Yes ☐ No

OWNER OR CONTRACTOR Crescent Resources, Inc. // John Wieland Homes PHONE: Business _____ Home _____

ADDRESS PO Box 1003, Charlotte

LOCATION Brawley Sch Rd. TR Bayharbour TL LAKE MIST TL Stormy Pt Cv. At End

SUBDIVISION The Harbour BLOCK / SECTION 4 LOT 10 LOT AREA > 20,000 ft² SITE CLASS. PS DESIGN FLOW 480 gpd L.T.A.R. ~.3

Septic Tank: 1000 Gallons; STB 794 Date 3/12/99

Pump Tank: 1000 Gallons; PT 271 Date 7/20/99

Pump Make: HYDROMATIC Model SHEF50A1 Serial No. 4/99

Nitrification Field: No Fields 1 Square Feet 1200 Linear Feet 400

No Lines 5@80' Trench Width 36" Max Trench Bottom Depth 36" Gravel Depth N/A

☑ New System ☐ Repair System Type: I, II, III, IV, V, VI

System Description: pumped pin-chambered

Repair System Description: same

Maintenance Agreement Required: ☐ Yes ☑ No

☑ House/Mod. Home ☐ Mobile Home ☐ Business ☐ Other

No. Bedrooms 4 No. Bathrooms 4 No. Employees ____

☐ Slab ☑ Crawl Space ☑ Basement w/plumbing ☐ Basement wo/plumbing


Water Supply: ☐ Individual ☑ Community ☐ Public

Comments: SIZE Pump TO REACH upper repair area Location


3-2-99 Reviewed housed site plan; appears in compliance w/ I.P.

Comments: (PARTIAL)

INITIAL SITE SKETCH 1"=50'

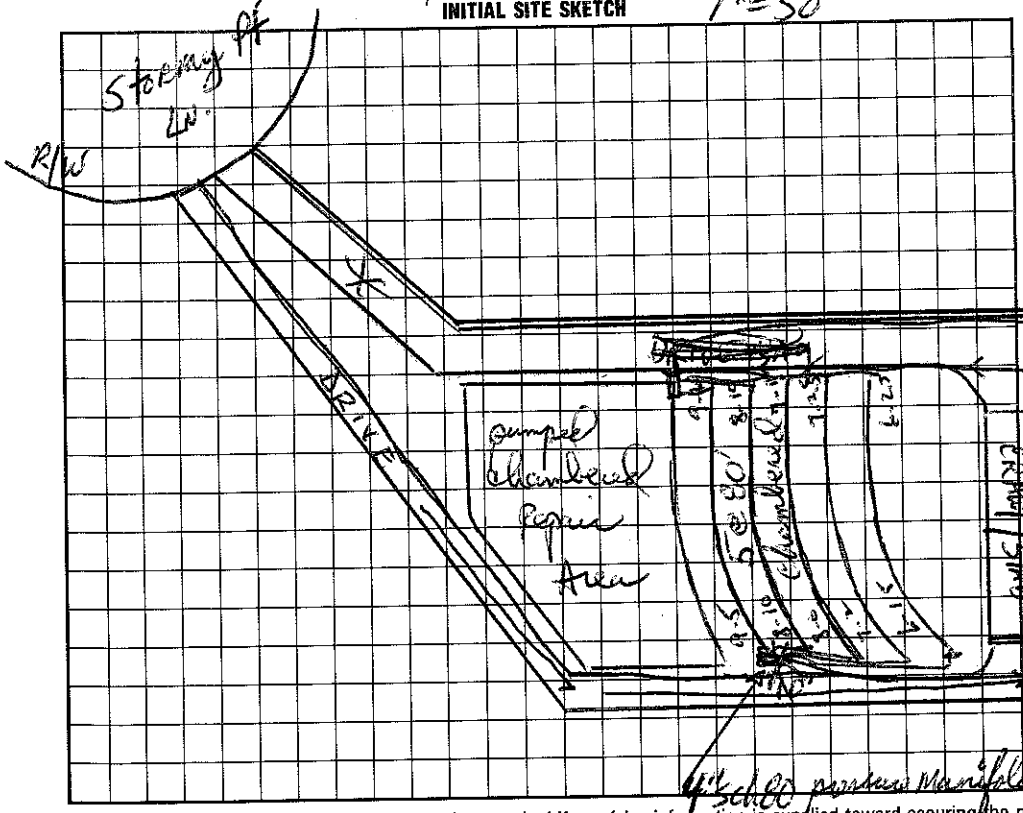

AS BUILT SKETCH

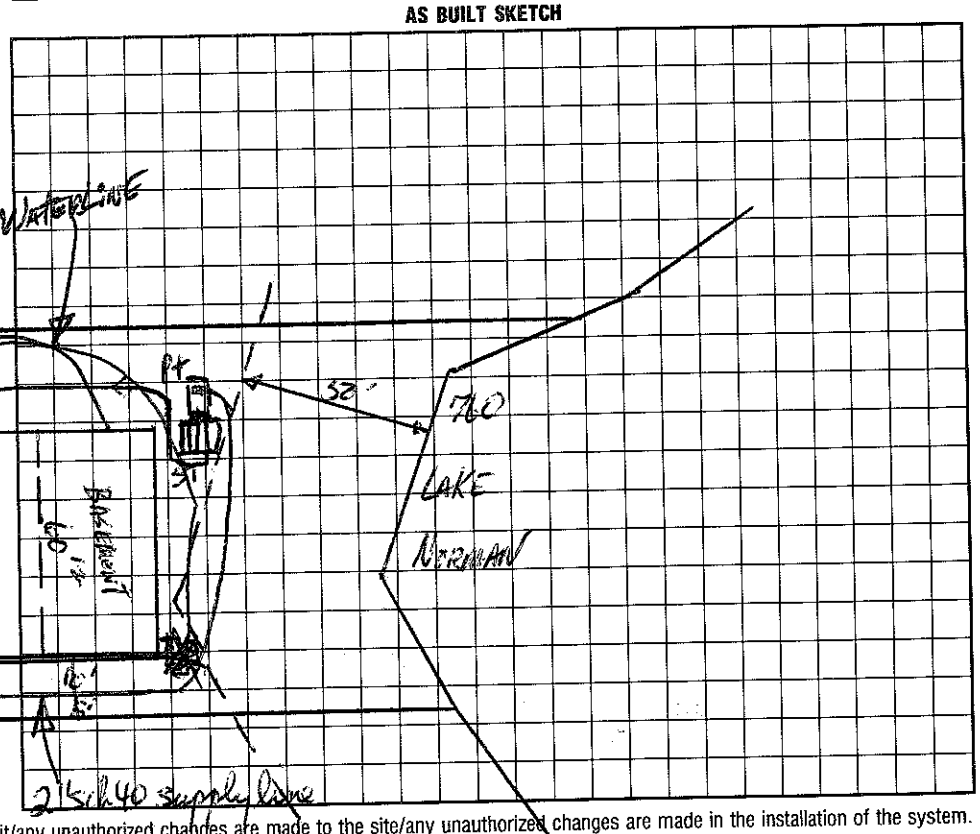

I understand that this permit can be suspended or revoked if any false information is supplied toward securing the permit/any unauthorized changes are made to the site/any unauthorized changes are made in the installation of the system. Improvement Permit is valid for 60 months from date of issuance.

Signed: Paul C. Bryant

Improvement Permit by: Darrell Hinson, RS date 3/26/97

~~Construction~~ ~~Existing System Inspection~~ by: Mark Hinson, RS date 3-2-99

Installed by: MacLeod Const.

Certificate of Completion by: Wesley Sparks R.S. date 10/15/99

Operation Permit by: Wesley Sparks R.S. date 10/15/99

~~Construction~~ Authorization HEALTH DEPT. COPY: WHITE INSPECTION COPY (FINAL): GREEN OWNER COPY (FINAL): YELLOW INSPECTION COPY (INITIAL): PINK OWNER COPY (INITIAL): GOLD