IREDELL COUNTY HEALTH DEPARTMENT Const. Auth. STATESVILLE 704-878-5305 MOORESVILLE 704-664-5281

IMPROVEMENT PERMIT / ~~CERTIFICATE OF COMPLETION~~ / OPERATION PERMIT / EXISTING SYSTEM INSPECTION

PROPERTY DESCRIPTION NO. 25752 DATE May 6 '97 (JOHN WIELAND) TAX MAP NO. part of 2CA3 4625 56 6909 Watershed: ☒ ~~Yes~~ ☐ No

OWNER OR CONTRACTOR Crescent Resources Inc PHONE: Business / Home

ADDRESS PO Box 1003, Charlotte

LOCATION Brawley Sch Rd. TR Bay Harbour, TL Lake Mist TL Stormy Pt. Ln. ATend

SUBDIVISION The Harbour BLOCK / SECTION 4 LOT 8, 8A LOT AREA 1Ac+ SITE CLASS. PS DESIGN FLOW 480gpd L.T.A.R. .3

Septic Tank: 1000 Gallons; STB 794 Date 9/12/97
Pump Tank: 1000 Gallons; PT 27 Date 9/13/99
Pump Make: HYDR. Model SHEF50 Serial No. 7 @ 99
Nitrification Field: No Fields 1 Square Feet 1200 Linear Feet 400
No Lines 4@133' Trench Width 36" Trench Bottom Depth 36" Gravel Depth N/A

☒ New System ☐ Repair System Type: I, II, III, IV, V, VI
System Description: 3cm Chambered
Repair System Description: LP Chamber / Panel Block
Maintenance Agreement Required: ☐ Yes ☐ No

☒ House/Mod. Home No. Bedrooms 4
☐ Mobile Home No. Bathrooms 4
☐ Business No. Employees
☐ Other


☐ Slab ☐ Crawl Space ☒ Basement w/plumbing ☐ Basement wo/plumbing

Water Supply:
☐ Individual
☒ Community
☐ Public

Comments:

Comments:

INITIAL SITE SKETCH 1" x 100'

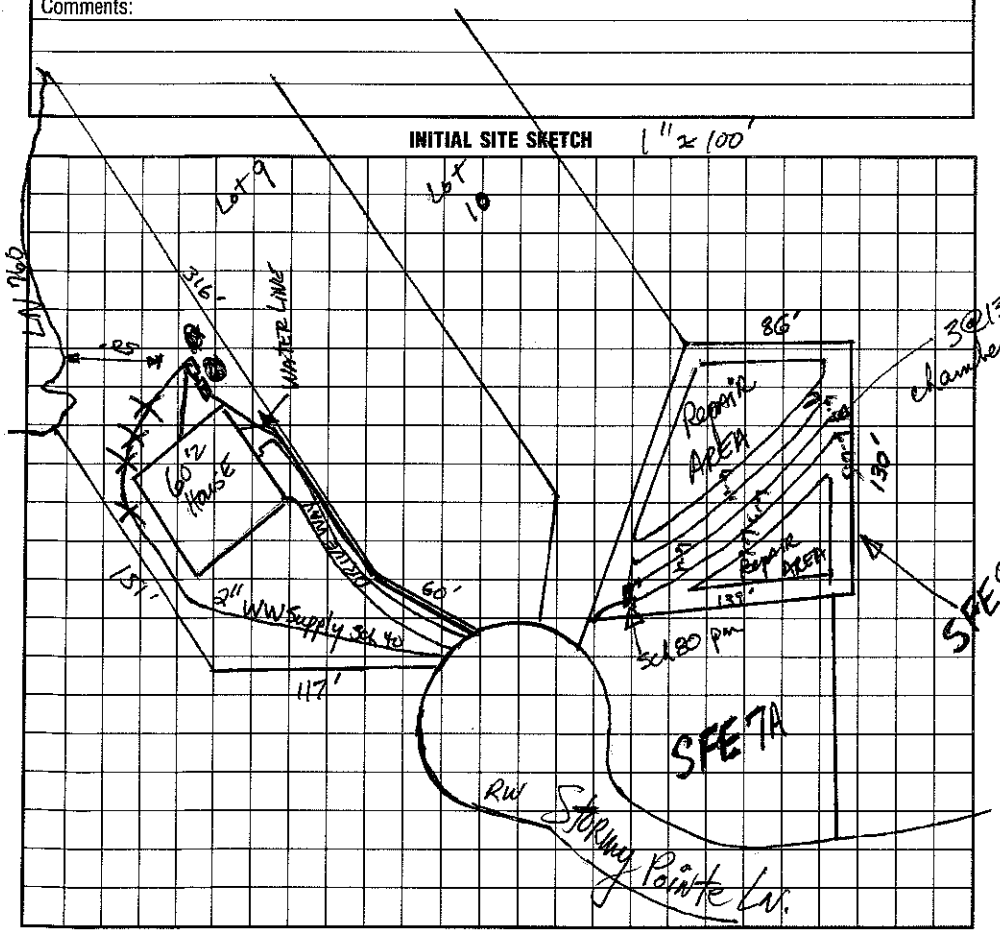

AS BUILT SKETCH

I understand that this permit can be suspended or revoked if any false information is supplied toward securing the permit/any unauthorized changes are made to the site/any unauthorized changes are made in the installation of the system. Improvement Permit is valid for 60 months from date of issuance.

Signed: *

Improvement Permit by: date 5-16-97

~~Existing System Inspection by~~ CONSTRUCTION AUTHORIZATION: Wesley Sparks RS. date 4/14/99

Installed by: MacLeod Const.

Certificate of Completion by: Wesley Sparks RS. date 1/27/00

Operation Permit by: date

HEALTH DEPT. COPY: WHITE INSPECTION COPY (FINAL): GREEN OWNER COPY (FINAL): YELLOW INSPECTION COPY (INITIAL): PINK OWNER COPY (INITIAL): GOLD