___ COUNTY HEALTH DEPARTMENT

STATESVILLE 704-878-5305 MOORESVILLE ...

IMPROVEMENT PERMIT / ~~CERTIFICATE OF COMPLETION~~ / OPERATION PERMIT / EXISTING SYSTEM INSPECTION

PROPERTY DESCRIPTION NO. 26.256 DATE 3/10/97 TAX MAP NO. 4625570747 Watershed: ☑ Yes ☐ No

OWNER OR CONTRACTOR MI HOMES PHONE: Business 663-6905 T JACOBS Home

ADDRESS 1043 E MOREHEAD ST CHARLOTTE NC

LOCATION BRANLEY SCHOOL · TR BAY HARBOUR - TL LAKE MIST · TR HUNTER SPRING LN 2ND ON LT

SUBDIVISION HARBOUR BLOCK / SECTION II LOT 31 LOT AREA 22756 FT² SITE CLASS. RS DESIGN FLOW 480GPD L.T.A.R. .36 GPD/FT²

Septic Tank: 1000 Gallons; STB 794 Date 5/12/98

Pump Tank: ____ Gallons; PT ____ Date ____

Pump Make: ____ Model ____ Serial No. ____

Nitrification Field: No Fields 1 Square Feet 1200 Linear Feet 400

No Lines 5 @ 80' Trench Width 36" Max Trench Bottom Depth 36" Gravel ~~Depth~~ SAND

☑ New System ☐ Repair System Type: I, II, III, IV, V, VI

System Description: GRAVITY CHAMBERED OR SEMI-CH

Repair System Description: PANEL

Maintenance Agreement Required: ☐ Yes ☑ No

☑ House/Mod. Home No. Bedrooms 4

☐ Mobile Home No. Bathrooms 3.5

☐ Business No. Employees ____

☐ Other ____


☐ Slab ☑ Crawl Space ☐ Basement w/plumbing ☐ Basement wo/plumbing

Water Supply:
☐ Individual
☑ Community
☐ Public


Comments:

Comments:

INITIAL SITE SKETCH 1"=30'

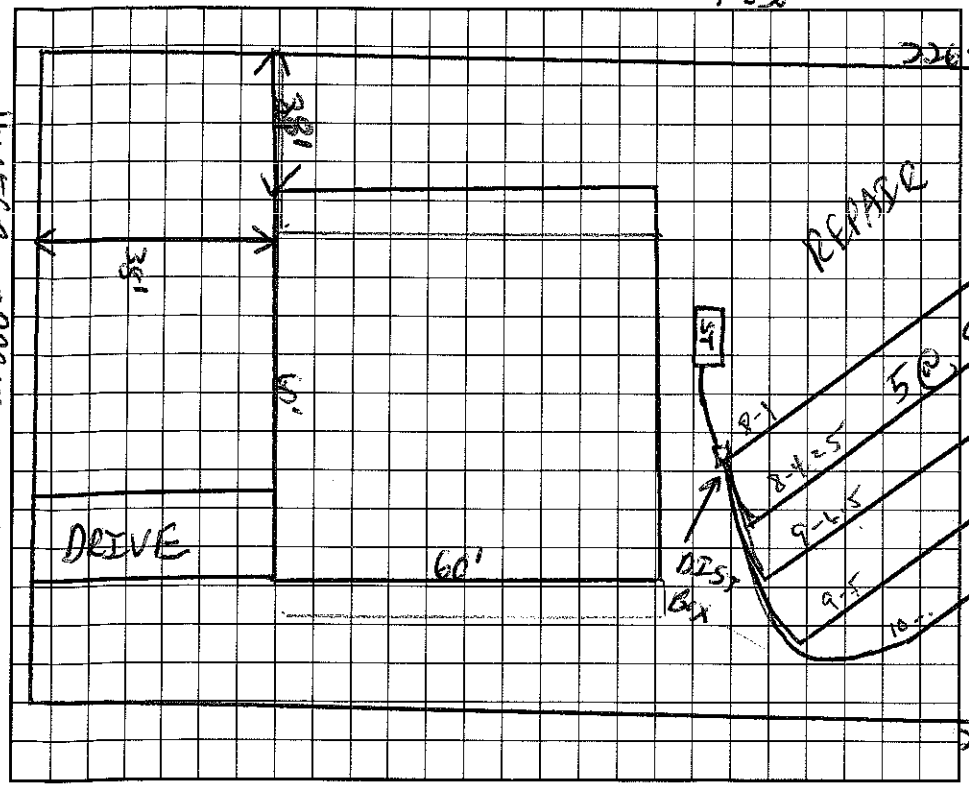

AS BUILT SKETCH

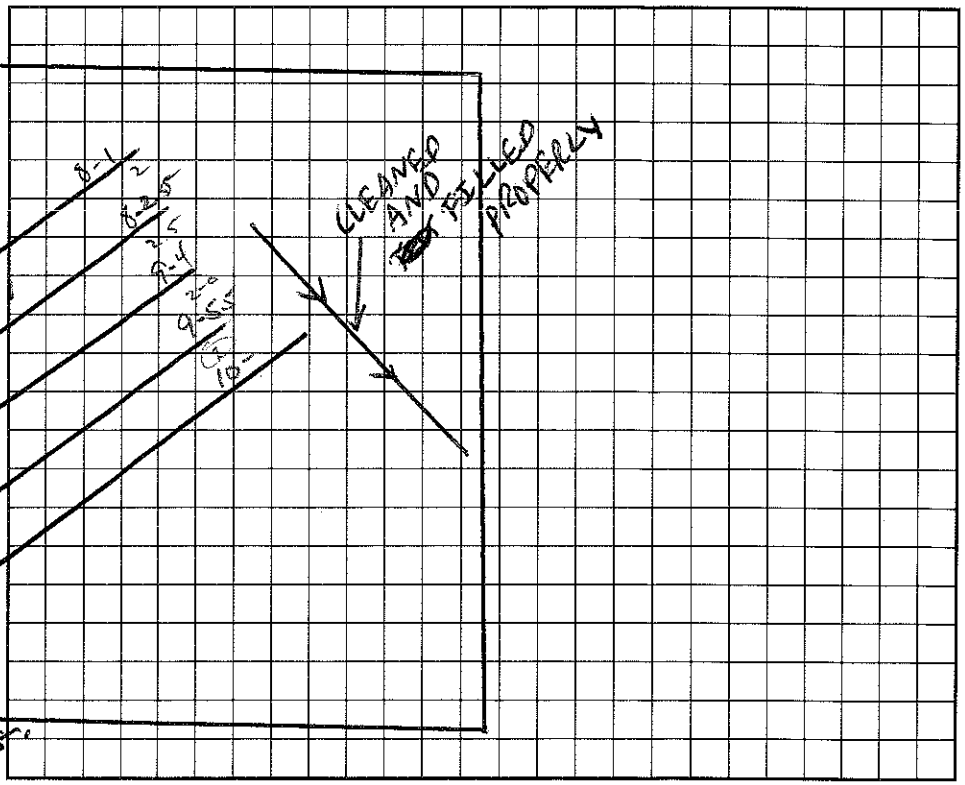

I understand that this permit can be suspended or revoked if any false information is supplied toward securing the permit/any unauthorized changes are made to the site/any unauthorized changes are made in the installation of the system. Improvement Permit is valid for 60 months from date of issuance.

Signed: Paul G. Pum

Improvement Permit by: C RS Keen EHSE date 3/10/97

~~Existing System Inspection by:~~ AUTHORIZATION TO CONSTRUCT C RS Keen EHSE date 3/10/97

Installed by: Mashcoat Const.

Certificate of Completion by: Wesley Sparks, RS. date 8/21/98

Operation Permit by: Wesley Sparks RS date 8/21/98

HEALTH DEPT. COPY: WHITE INSPECTION COPY (FINAL): GREEN OWNER COPY (FINAL): YELLOW INSPECTION COPY (INITIAL): PINK OWNER COPY (INITIAL): GOLD