IREDELL COUNTY HEALTH DEPARTMENT

AUTHORIZATION TO CONSTRUCT

STATESVILLE 704-878-5305 MOORESVILLE 704-664-5281

IMPROVEMENT PERMIT / ~~CERTIFICATE OF COMPLETION~~ / OPERATION PERMIT / EXISTING SYSTEM INSPECTION

PROPERTY DESCRIPTION NO. 26255 DATE 3/10/97 TAX MAP NO. 4625571743 Watershed: ☑ Yes ☐ No

OWNER OR CONTRACTOR MI HOMES PHONE: Business 663-6905 - T. JACOBS Home

ADDRESS 1043 E MOREHEAD ST CHARLOTTE NC

LOCATION BRANLEY SCHOOL RD - TR BAY HARBOUR - TL LAKE MIST - TR HUNTER SPRINGS LN 1ST ON LT

SUBDIVISION HARBOUR BLOCK / SECTION II LOT 30 LOT AREA 26314 SITE CLASS. PS DESIGN FLOW 480 GPD L.T.A.R. .36PD/FT2

Septic Tank: 1000 Gallons; STB 774 Date 4/23/97

Pump Tank: Gallons; PT Date

Pump Make: Model Serial No.

Nitrification Field: No Fields 1 Square Feet 1200 Linear Feet 400

No Lines 4@160' Trench Width 36" Max Trench Bottom Depth 36" ~~Gravel Depth~~ N/A

☑ New System ☐ Repair System Type: I, II, (III) IV, V, VI

System Description: GRAVITY CHAMBERED

Repair System Description: SAME

Maintenance Agreement Required: ☐ Yes ☑ No

☑ House/Mod. Home No. Bedrooms 4

☐ Mobile Home No. Bathrooms 4

☐ Business No. Employees

☐ Other


☐ Slab ☑ Crawl Space ☐ Basement w/plumbing ☐ Basement wo/plumbing

Water Supply: ☐ Individual ☑ Community ☐ Public


Comments:

Comments:

INITIAL SITE SKETCH 1"=30'

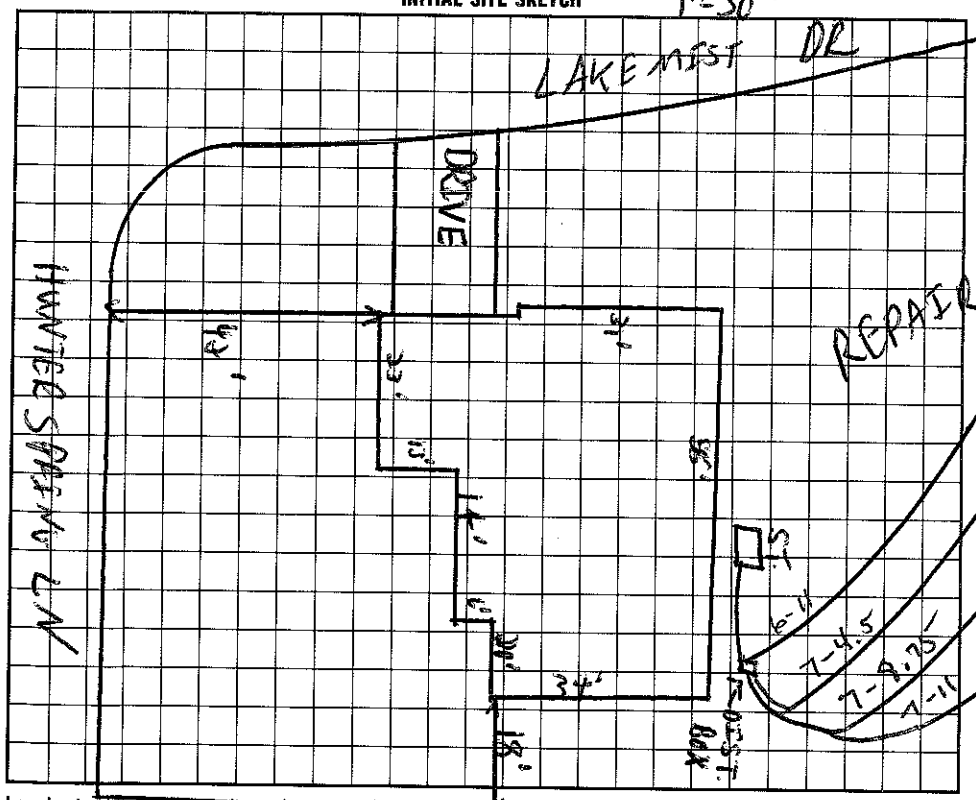

AS BUILT SKETCH

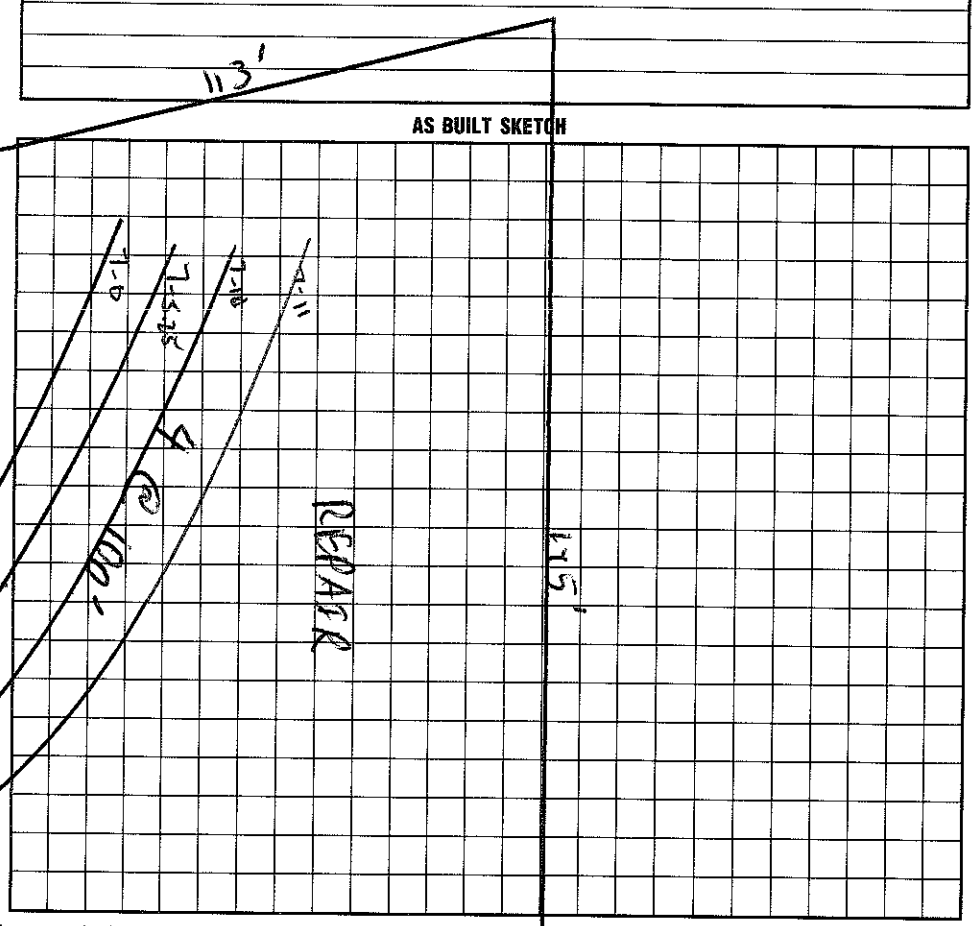

I understand that this permit can be ~~suspended or revoked~~ if any false information is supplied toward securing the permit/any unauthorized changes are made to the site/any unauthorized changes are made in the installation of the system. Improvement ~~Permit~~ is valid for 60 months from date of issuance.

Signed:

Improvement Permit by: date 3/10/97

AUTHORIZATION ~~Existing System Inspection by:~~ date 3/10/97

TO CONSTRUCT

Installed by: Mac Lee & Const. Co.

Certificate of Completion by: Wesley Sparks RS date 7/11/97

Operation Permit by: Wesley Sparks RS. date 7/4/97

HEALTH DEPT. COPY: WHITE INSPECTION COPY (FINAL): GREEN OWNER COPY (FINAL): YELLOW INSPECTION COPY (INITIAL): PINK OWNER COPY (INITIAL): GOLD