IREDELL COUNTY HEALTH DEPARTMENT

AUTHORIZATION TO CONSTRUCT

STATESVILLE 704-878-5305 MOORESVILLE 704-664-5281

IMPROVEMENT PERMIT / ~~CERTIFICATE OF COMPLETION~~ / OPERATION PERMIT / EXISTING SYSTEM INSPECTION

PROPERTY DESCRIPTION NO. 24840 DATE 12/6/96 TAX MAP NO. 2C-A-3 pt of Watershed: ☑ Yes ☐ No

OWNER OR CONTRACTOR JOHN WIELAND HOMES PHONE: Business 663-6905 T. JACOBS ~~Home~~ 4625-57-2697

ADDRESS 8325 ARROWRIDGE BLVD. 28273 CHARLOTTE NC

LOCATION BRAWLEY SCHOOL RD TR B44 HARBOUR - TL LAKE WEST - 1ST LOT AFTER CORNER OF ~~SEA BREEZE~~ IVY HOLLOW LANE ON LEFT

SUBDIVISION HARBOUR BLOCK / SECTION II LOT 29 LOT AREA 22,312 SITE CLASS. PS DESIGN FLOW 480GPD L.T.A.R. .36GPD/FT²

Septic Tank: 1000 Gallons; STB 794 Date 11/25/98

Pump Tank: _____ Gallons; PT _____ Date _____

Pump Make: _____ Model _____ Serial No. _____

Nitrification Field: No Fields 1 Square Feet 810 Linear Feet 270

No Lines 6 Trench Width 24" Max Trench Bottom Depth 36" Gravel Depth N/A

☑ New System ☐ Repair System Type: I, II, III, IV, V, VI

System Description: GRAVITY PANEL

Repair System Description: GRAVITY PANEL

Maintenance Agreement Required: ☐ Yes ☑ No

☑ House/Mod. Home No. Bedrooms 4

☐ Mobile Home No. Bathrooms 4

☐ Business No. Employees _____

☐ Other _____


☐ Slab ☑ Crawl Space ☐ Basement w/plumbing ☐ Basement wo/plumbing

Water Supply:
☐ Individual
☑ Community
☐ Public


Comments:

Comments: installed as drawn.

INITIAL SITE SKETCH

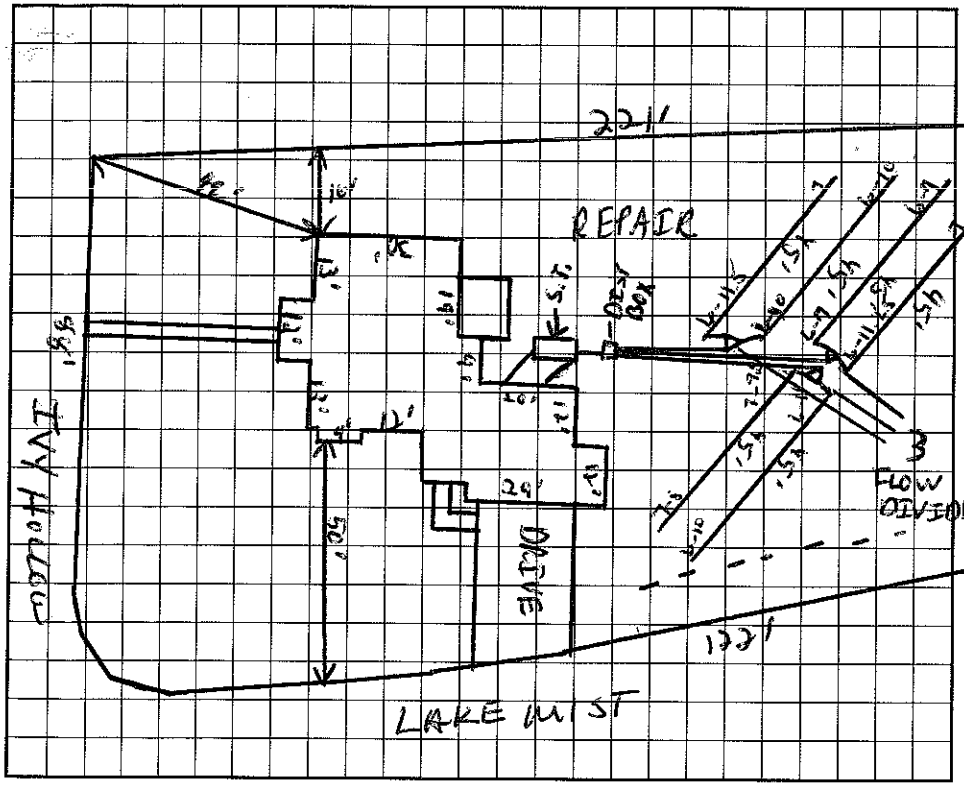

AS BUILT SKETCH

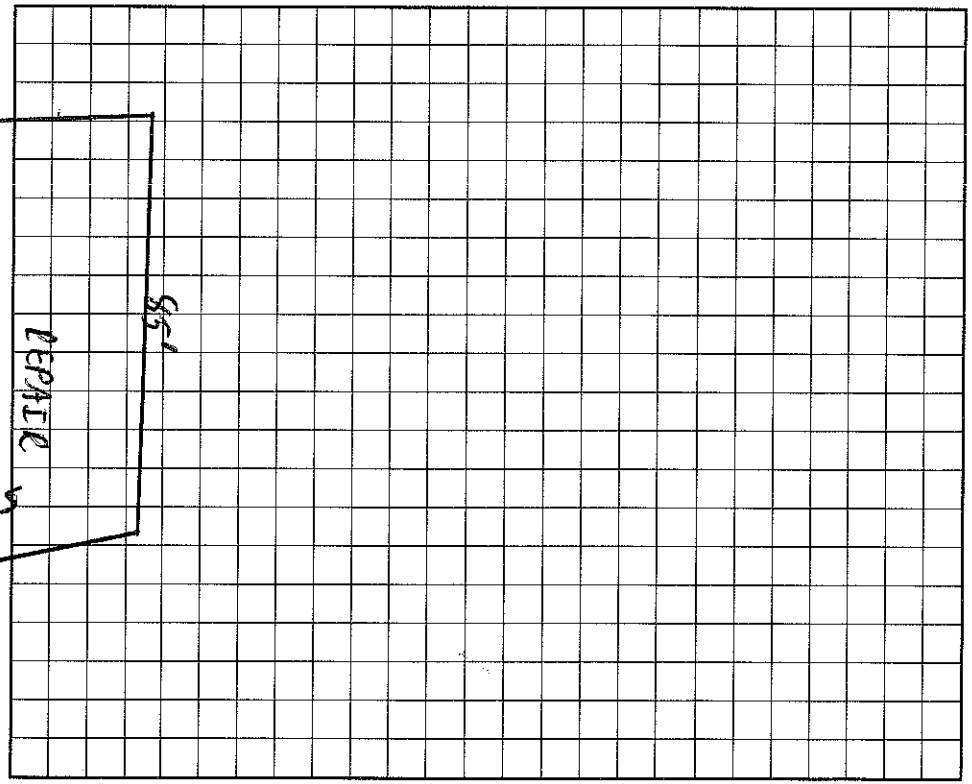

I understand that this permit can be suspended or revoked if any false information is supplied toward securing the permit/any unauthorized changes are made to the site/any unauthorized changes are made in the installation of the system.

Signed: Tony C Jacobs CPSS (B) 12-6-96

Improvement Permit by: C Ray Jones EHSI date 12/6/96

~~Existing System Inspection by:~~ AUTHORIZATION TO CONSTRUCT C Ray Jones EHSI date 12/6/96

Installed by: MacLeod

Certificate of Completion by: _____ date _____

Operation Permit by: Wesley Sparks R.S. date 2/11/99

HEALTH DEPT. COPY: WHITE INSPECTION COPY (FINAL): GREEN OWNER COPY (FINAL): YELLOW INSPECTION COPY (INITIAL): PINK OWNER COPY (INITIAL): GOLD