IREDELL COUNTY HEALTH DEPARTMENT

AUTHORIZATION TO CONSTRUCT

STATESVILLE 704-878-5305 MOORESVILLE 704-664-5281

IMPROVEMENT PERMIT / ~~CERTIFICATE OF COMPLETION~~ / OPERATION PERMIT / EXISTING SYSTEM INSPECTION

PROPERTY DESCRIPTION NO. 069456 DATE 10/23/97 TAX MAP NO. 4625573490 Watershed: ☑ ~~Yes~~ ☐ No

OWNER OR CONTRACTOR JOHN WIELAND PHONE: Business 663-6905 Home

ADDRESS 8325-D ARROWRIDGE RD CHARLOTTE NC 28273

LOCATION BRAWLEY SCHOOL - TR BAY HARBOUR - TL LAKE NIST - TL STONY PT - 2nd ON LT

SUBDIVISION HARBOUR BLOCK / SECTION 4 LOT 7 LOT AREA - SITE CLASS. PS DESIGN FLOW 480 GPD L.T.A.R. .300/FT

Septic Tank: 1000 Gallons; STB 794 Date 6/6/98

Pump Tank: Gallons; PT Date

Pump Make: Model Serial No.

Nitrification Field: No ~~Fields~~ 1 Square Feet 1200 Linear Feet 400

No ~~Lines~~ 5 Trench Width 36" Max Trench Bottom Depth 36" Gravel Depth N/A

☑ New System ☐ Repair System Type: I, II, (III) IV, V, VI

System Description: GRAVITY CHAMBERED OR HDS

Repair System Description: SAME

Maintenance Agreement Required: ☐ Yes ☑ No

☑ House/Mod. Home No. Bedrooms 4

☐ Mobile Home No. Bathrooms 4

☐ Business No. Employees

☐ Other


☐ Slab ☑ Crawl Space ☐ Basement w/plumbing ☐ Basement wo/plumbing

Water Supply: ☐ Individual ☑ Community ☐ Public

Comments:

Comments:

INITIAL SITE SKETCH 1" = 50'

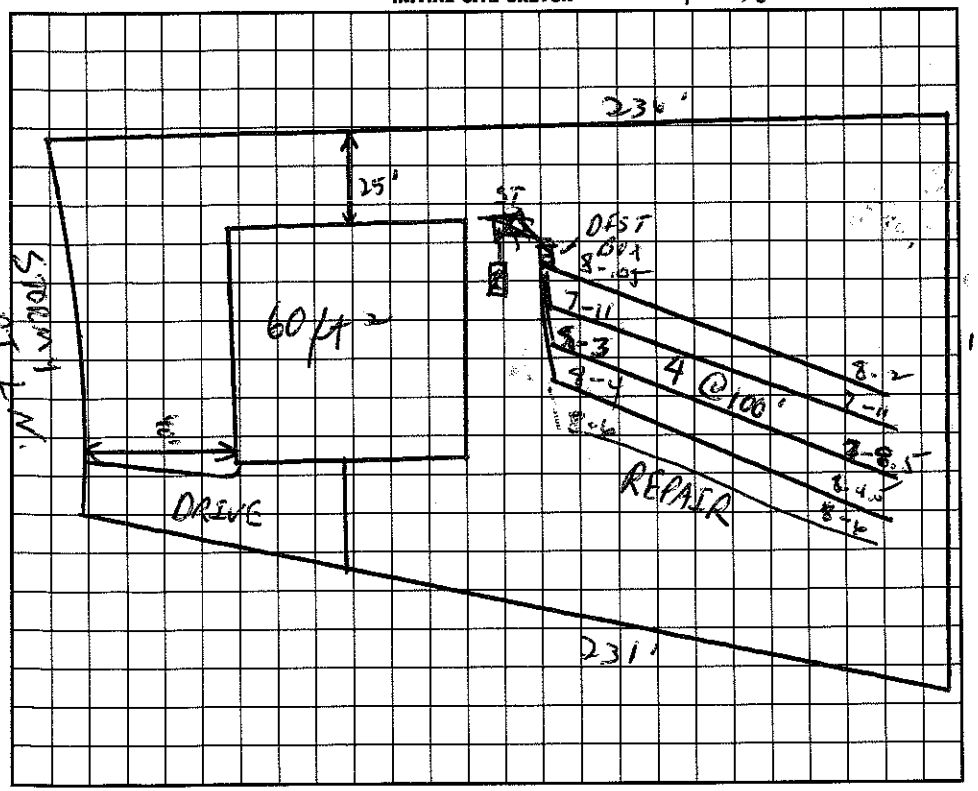

AS BUILT SKETCH

I understand that this permit can be suspended or revoked if any false information is supplied toward securing the permit/any unauthorized changes are made to the site/any unauthorized changes are made in the installation of the system. Improvement Permit is valid for ~~60~~ months from date of issuance.

Signed:

Improvement Permit by: C Buck Freeman RS date 10/23/97

AUTHORIZATION TO CONSTRUCT

~~Existing System Inspection~~ by: C Buck Freeman RS date 10/23/97

Installed by: MacLeod Const. Co.

Certificate of Completion by: date

Operation Permit by: Wesley Sparks R.S. date 10/1/98

HEALTH DEPT. COPY: WHITE INSPECTION COPY (FINAL): GREEN OWNER COPY (FINAL): YELLOW INSPECTION COPY (INITIAL): PINK OWNER COPY (INITIAL): GOLD