IREDELL COUNTY HEALTH DEPARTMENT

AUTHORIZATION TO CONSTRUCT

STATESVILLE 704-878-5305 MOORESVILLE 704-664-5281

IMPROVEMENT PERMIT / ~~CERTIFICATE OF COMPLETION~~ / OPERATION PERMIT / EXISTING SYSTEM INSPECTION

PROPERTY DESCRIPTION NO. 24536 DATE 12/5/96 TAX MAP NO. 2C-A-3 pt of Watershed: ☑ Yes ☐ No

OWNER OR CONTRACTOR JOHN WIELAND HOMES PHONE: Business 663-6405 T. JACOBS ~~Home~~ 462557-3695

ADDRESS 8325 ARROWRIDGE BLVD CHARLOTTE, NC 28273

LOCATION BRAWLEY SCHOOL TR BAY HARBOUR - TL LATE MIST - TL SEA BREEZE - 2nd ON RT

SUBDIVISION HARBOUR BLOCK / SECTION II LOT 25 LOT AREA 22,068 FT² SITE CLASS. PS DESIGN FLOW 480GPD L.T.A.R. .136 GPD/FT²

Septic Tank: 1000 Gallons; STB 794 Date 5/12/98

Pump Tank: ____ Gallons; PT ____ Date ____

Pump Make: ____ Model ____ Serial No. ____

Nitrification Field: No Fields 1 Square Feet 1200 Linear Feet 400

No Lines 5 Trench Width 36" Max Trench Bottom Depth 36" Gravel Depth N/A

☑ New System ☐ Repair System Type: I, II, III, IV, V, VI

System Description: GRAVITY CHAMBERED OR SIMILAR

Repair System Description: PANEL

Maintenance Agreement Required: ☐ Yes ☑ No

☑ House/Mod. Home No. Bedrooms 4

☐ Mobile Home No. Bathrooms 4

☐ Business No. Employees ____

☐ Other ____


☐ Slab ☑ Crawl Space ☐ Basement w/plumbing ☐ Basement wo/plumbing

Water Supply: ☐ Individual ☑ Community ☐ Public


Comments:

Comments:

INITIAL SITE SKETCH

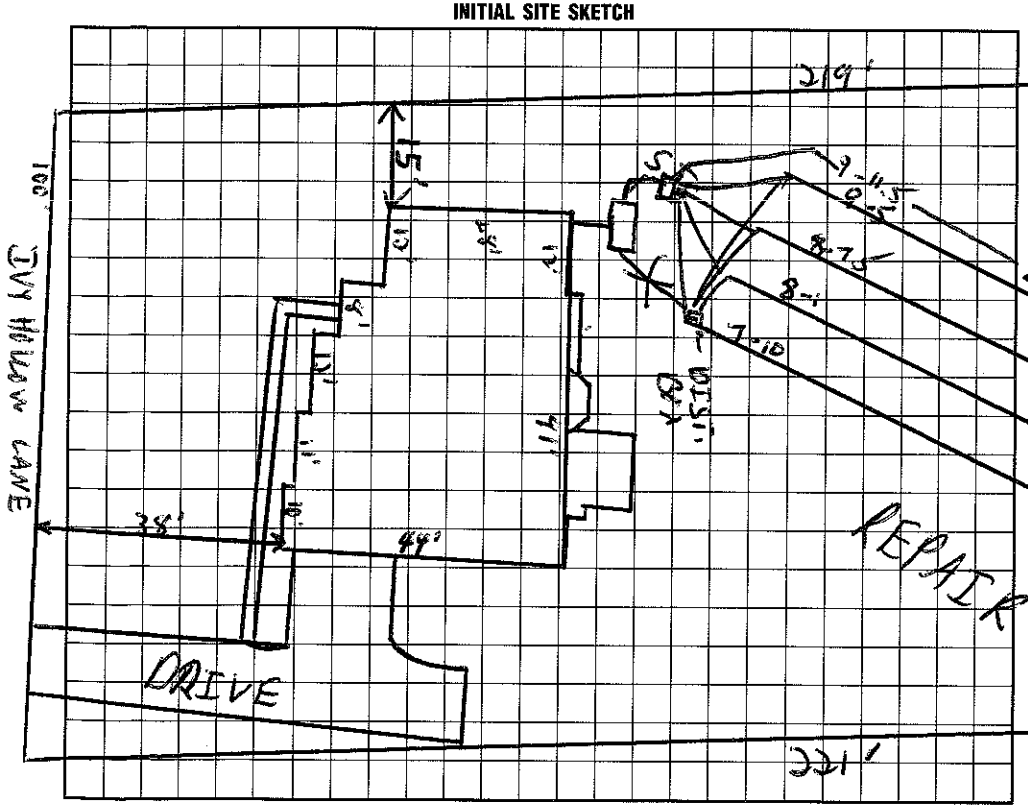

AS BUILT SKETCH

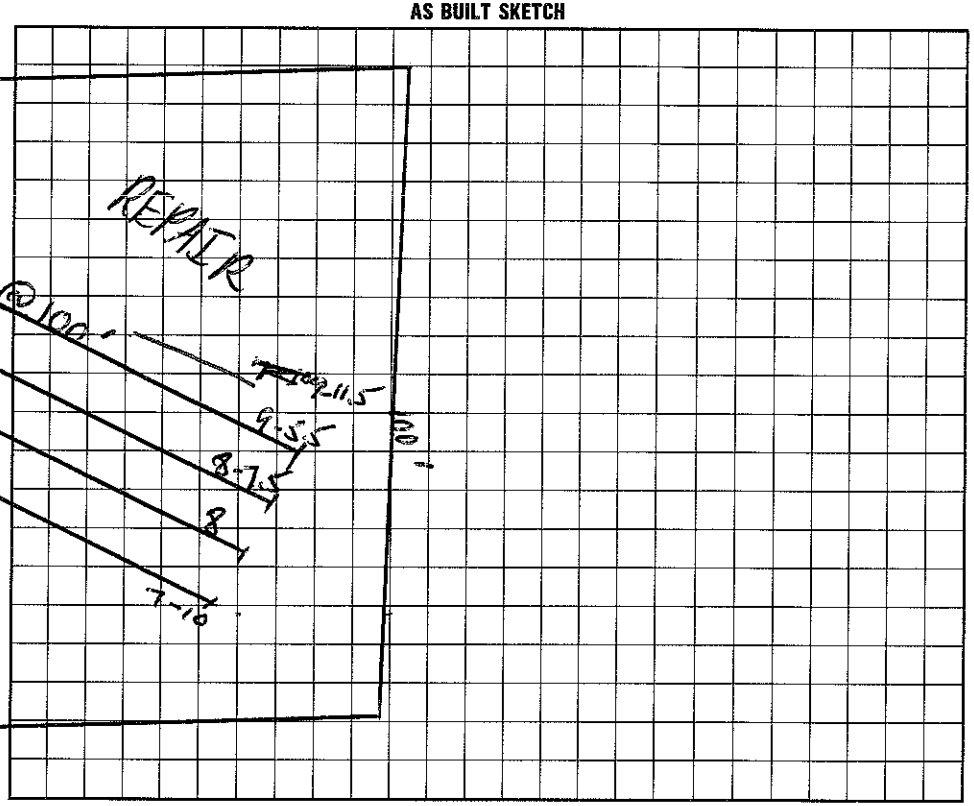

I understand that this permit can be suspended or revoked if any false information is supplied toward securing the permit/any unauthorized changes are made to the site/any unauthorized changes are made in the installation of the system.

Signed: Tony Cyanes CPSS (18) 12-6-96

Improvement Permit by: C. Raby Thomas EHS date 12/5/96

~~Existing System Inspection by:~~ AUTHORIZATION TO CONSTRUCT C. Raby Thomas EHS date 12/5/96

Installed by: MacLeod

Certificate of Completion by: ____ date ____

Operation Permit by: Wesley Sparks RS. date 8/31/98

HEALTH DEPT. COPY: WHITE INSPECTION COPY (FINAL): GREEN OWNER COPY (FINAL): YELLOW INSPECTION COPY (INITIAL): PINK OWNER COPY (INITIAL): GOLD