IREDELL COUNTY HEALTH DEPARTMENT

AUTHORIZATION TO CONSTRUCT

STATESVILLE 704-878-5305 MOORESVILLE 704-664-5281

IMPROVEMENT PERMIT / ~~CERTIFICATE OF COMPLETION~~ / OPERATION PERMIT / EXISTING SYSTEM INSPECTION

PROPERTY DESCRIPTION NO. 069453 DATE 10/23/97 TAX MAP NO. 4625574395 PT Watershed: ☑ Yes ☐ No

OWNER OR CONTRACTOR JOHN WIELAND HOMES PHONE: Business 663-6905 Home

ADDRESS 8325-D ARROWRIDGE RD - CHARLOTTE NC 28273

LOCATION BRAWLEY SCHOOL - TR BAY HARBOUR - TL LAKE MIST - ~~RT~~ LSTORMY - 3RD ON LEFT

SUBDIVISION HARBOUR BLOCK / SECTION 4 LOT 3 LOT AREA SITE CLASS. PS DESIGN FLOW 480 GAD L.T.A.R. .35 GAD/FT²

Septic Tank: 1000 Gallons; STB 794 Date 8/26/98

Pump Tank: 1000 Gallons; PT 29 Date 11/1/98

Pump Make: HYDROMATIC Model SK50A1A Serial No. 11198

Nitrification Field: No Fields 1 Square Feet 1080 Linear Feet 360

No Lines 4 @ 90' Trench Width 36" Max Trench Bottom Depth 36" Gravel Depth N/A

☑ New System ☐ Repair System Type: I, II, III, IV, V, VI

System Description: PUMP CHAMBERED ORIHOS

Repair System Description: PUMP PANEL

Maintenance Agreement Required: ☐ Yes ☑ No

☑ House/Mod. Home No. Bedrooms 4

☐ Mobile Home No. Bathrooms 4

☐ Business No. Employees

☐ Other

☐ Slab ☑ Crawl Space ☐ Basement w/plumbing ☐ Basement wo/plumbing


Water Supply: ☐ Individual ☑ Community ☐ Public

Comments:


Comments:

INITIAL SITE SKETCH

1" = 50'

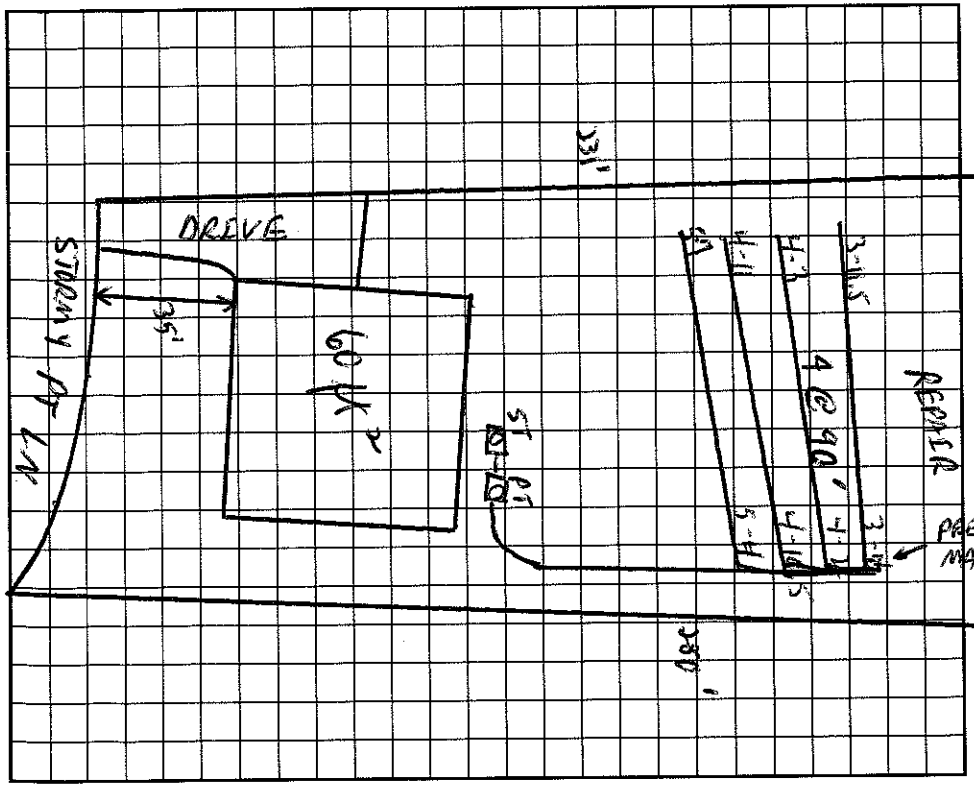

AS BUILT SKETCH

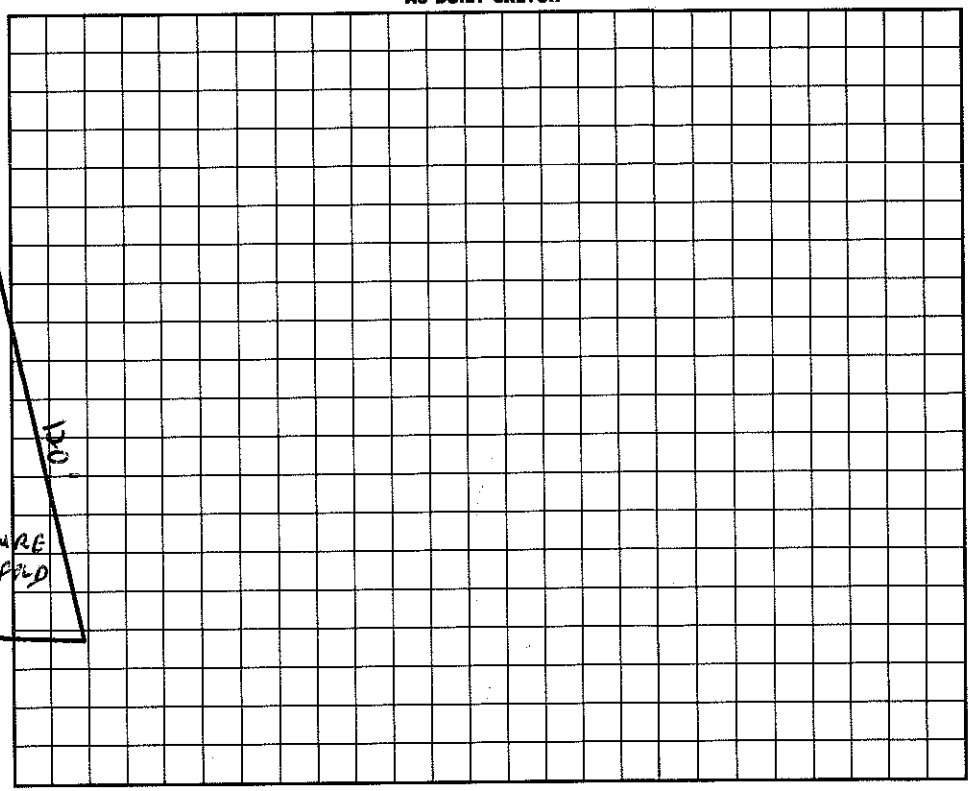

I understand that this permit can be suspended or revoked if any false information is supplied toward securing the permit/any unauthorized changes are made to the site/any unauthorized changes are made in the installation of the system. Improvement Permit is valid ~~for 60~~ months from date of issuance.

Signed:

Installed by: Mackey & Const.

Improvement Permit by: C. Brady Freeman RS date 10/23/97

Certificate of Completion by: W date

AUTHORIZATION TO CONSTRUCT

~~Existing System Inspection~~ by: C. Brady Freeman RS date 10/23/97

Operation Permit by: Wesley Sparks RS date 1/20/99

HEALTH DEPT. COPY: WHITE INSPECTION COPY (FINAL): GREEN OWNER COPY (FINAL): YELLOW INSPECTION COPY (INITIAL): PINK OWNER COPY (INITIAL): GOLD