IREDELL COUNTY HEALTH DEPARTMENT

→ AUTHORIZATION TO CONSTRUCT

STATESVILLE 704-878-5305 MOORESVILLE 704-664-5281

IMPROVEMENT PERMIT / ~~CERTIFICATE OF COMPLETION~~ / OPERATION PERMIT / EXISTING SYSTEM INSPECTION

PROPERTY DESCRIPTION NO. 24835 DATE 12/6/96

OWNER OR CONTRACTOR JOHN WIELAND HOMES TAX MAP NO. 2C-A-3 pt of 4625574682 Watershed: ☑ Yes ☐ No

ADDRESS 8235 ARROWRIDGE BLVD. CHARLOTTE 28278 PHONE: Business 663-6905 - T. JACOBS Home

LOCATION BRAWLEY SCHOOL RD TR BAY HARBOR - TL LAKE MIST - TL ~~SUBDIVISION~~ IVY HOLLOW LANE, - 3RD LOT ON RT.

SUBDIVISION HARBOUR BLOCK / SECTION II LOT 27 LOT AREA 21,914 FT² SITE CLASS. PS DESIGN FLOW 480GPD L.T.A.R. .36 GPD/FT²

Septic Tank: 1000 Gallons; STB 794 Date 7/7/98

Pump Tank: 1000 Gallons; PT ____ Date ____

Pump Make: ____ Model ____ Serial No. ____

Nitrification Field: No. Fields 1 Square Feet 810 Linear Feet 270

No. Lines ~~5~~ 5 Trench Width 24" Max Trench Bottom Depth 36" Gravel Depth N/A

☑ New System ☐ Repair System Type: I, II, III, IV, V, VI

System Description: ~~PUMP PANEL~~ GR. CH PLASTIC

Repair System Description: PUMP PANEL

Maintenance Agreement Required: ☑ Yes ☐ No

☑ House/Mod. Home ☐ Mobile Home ☐ Business ☐ Other

No. Bedrooms 4 No. Bathrooms 4 No. Employees ____


☐ Slab ☑ Crawl Space ☐ Basement w/plumbing ☐ Basement wo/plumbing

Water Supply: ☐ Individual ☑ Community ☐ Public


Comments:

Comments: BF - changed to gravity

INITIAL SITE SKETCH

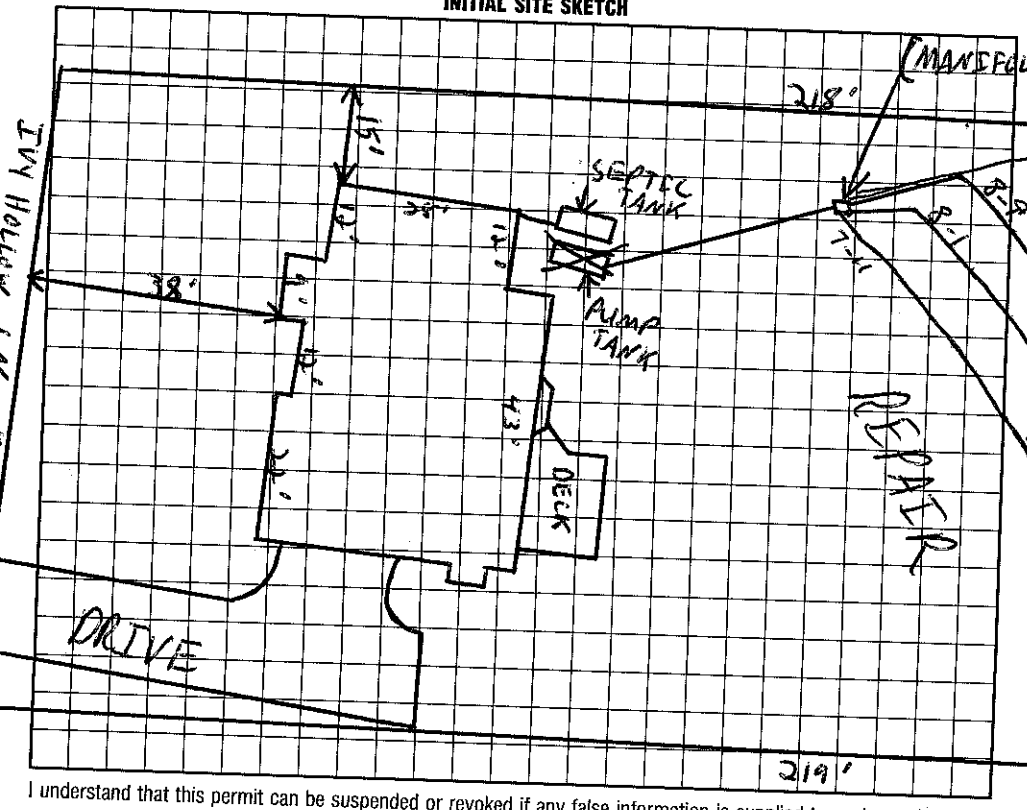

AS BUILT SKETCH

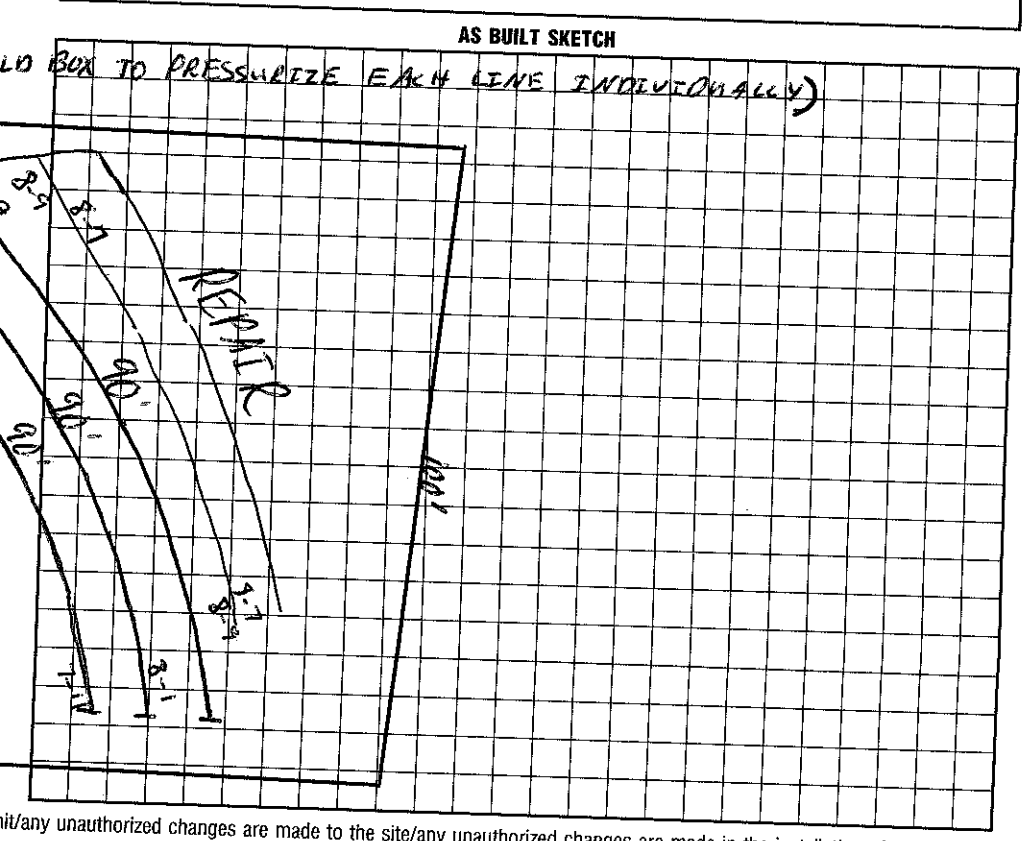

I understand that this permit can be suspended or revoked if any false information is supplied toward securing the permit/any unauthorized changes are made to the site/any unauthorized changes are made in the installation of the system.

Signed: Tonya C Jacobs COSS(R) 12-6-96

Improvement Permit by: C. Baty Tenn EHSF date 12/6/96

~~Existing System Inspection by:~~ AUTHORIZATION TO CONSTRUCT C. Baty Tenn EHSF date 12/6/96

Installed by: MacLeod Const.

Certificate of Completion by: ____ date ____

Operation Permit by: Wesley Sparks RS date 10/2/98

HEALTH DEPT. COPY: WHITE INSPECTION COPY (FINAL): GREEN OWNER COPY (FINAL): YELLOW INSPECTION COPY (INITIAL): PINK OWNER COPY (INITIAL): GOLD