IREDELL COUNTY HEALTH DEPARTMENT

STATESVILLE 704-878-5305 MOORESVILLE 704-664-5281

IMPROVEMENT PERMIT / AUTHORIZATION TO CONSTRUCT / OPERATION PERMIT / EXISTING SYSTEM INSPECTION

PERMIT# No PIN# ~~2CA37Pf~~ of. 4625574889 DATE 11/16/00

OWNER OR CONTRACTOR Tom Bramhall PHONE: Business Home 664-1080

ADDRESS 109 Bay Hollow Lane Mooresville, NC. 28115

LOCATION 1100 TR Bay Harbour TL LakeMist TL Bay Hollow, first home on (L)

SUBDIVISION Harbour BLOCK / SECTION 2 LOT 18 LOT AREA ~23,000Ft² SITE CLASS. PS DESIGN FLOW 480 L.T.A.R. .3

Septic Tank: EXISTING Gallons; STB Date

Pump Tank: EXISTING Gallons; PT Date

Pump Make: Model Serial No.

Nitrification Field: No Fields 1 Square Feet 798 Linear Feet 266

No Lines 4 Trench Width 3' Max Trench Bottom Depth 36 Gravel Depth No

☐ New System ☒ Repair System Type: I, II, III, (IV), V, VI

System Description:

Repair System Description: LPP Dist. 16" PPBS

Maintenance Agreement Required: ☒ Yes ☐ No

☒ House/Mod. Home No. Bedrooms 4

☐ Mobile Home No. Bathrooms 4

☐ Business No. Employees

☐ Other


☐ Slab ☒ Crawl Space ☐ Basement w/plumbing ☐ Basement wo/plumbing

Water Supply: ☐ Individual ☐ Public ☒ Community


Comments:/Conditions:

Comments:/Conditions: 3/2/01 Checked lines 01, and 02

INITIAL SITE SKETCH

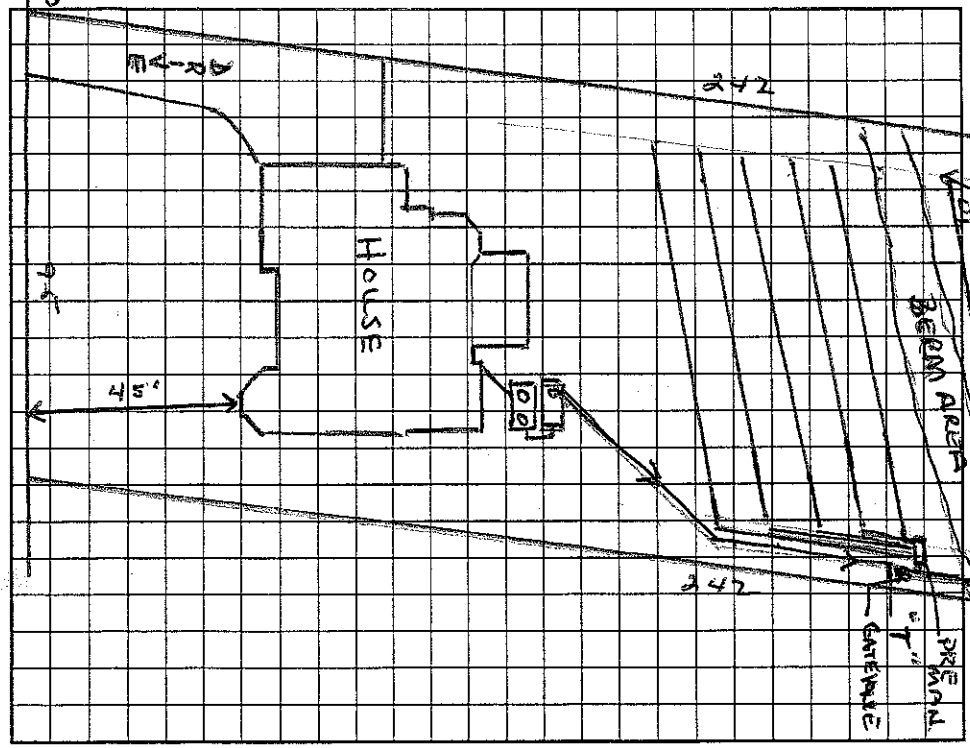

AS BUILT SKETCH

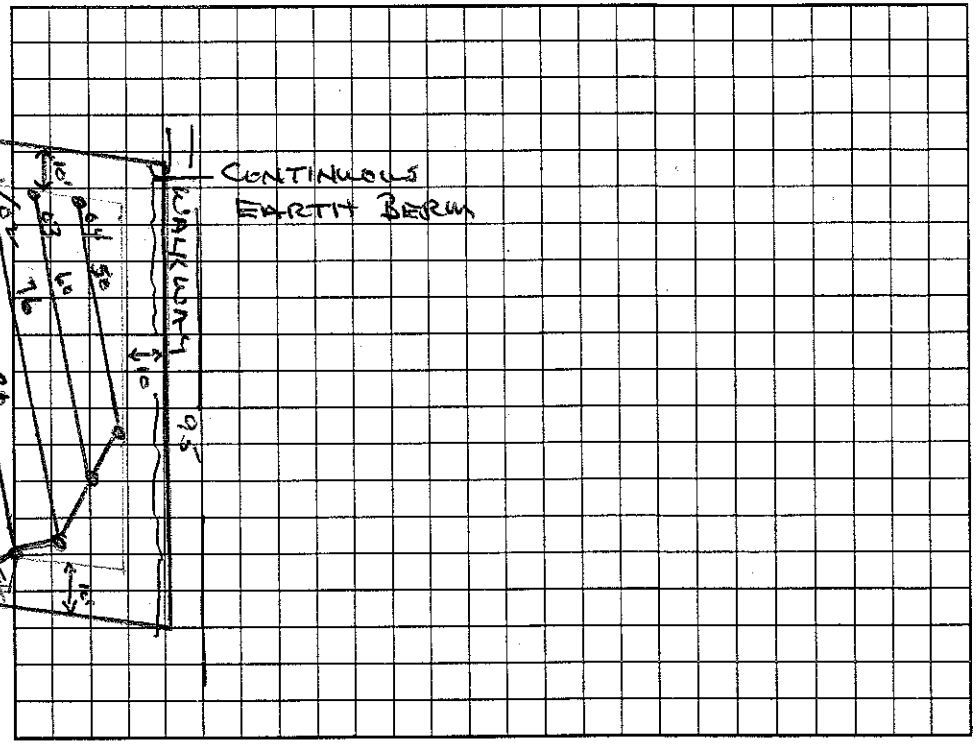

Bay Hollow Lane

Permit can be suspended or revoked if any false information is supplied toward securing the permit/any unauthorized changes are made to the site/any unauthorized changes are made in the installation of the system. Improvement Permit with plat valid without expiration. Improvement Permit with site plan valid for sixty months. Authorization to Construct is valid for a period equal to that of Improvement Permit – not to exceed sixty months.

Signed: * McLeod Const. date 2/20/01 Installed by: Macleod Const.

Improvement Permit by: Wesley Sparks RS. date 11/16/00 Operation Permit by: Wesley Sparks RS date 3/13/01

Authorization to Construct by: Wesley Sparks RS. date 11/16/00 Existing System Inspection by: date

HEALTH DEPT. COPY: WHITE OWNER COPY (FINAL): YELLOW OWNER COPY (INITIAL): PINK