IREDELL COUNTY HEALTH DEPARTMENT

AUTHORIZATION TO CONSTRUCT

STATESVILLE 704-878-5305 MOORESVILLE 704-664-5281

IMPROVEMENT PERMIT / ~~CERTIFICATE OF COMPLETION~~ / OPERATION PERMIT / EXISTING SYSTEM INSPECTION

PROPERTY DESCRIPTION NO. 24830 DATE 10/25/96 TAX MAP NO. 26-A-3 pt of 4625575876 Watershed: ☑ Yes ☐ No

OWNER OR CONTRACTOR JOHN WIELAND HOMES PHONE: Business 663-6405 (CT. JACOBS) Home

ADDRESS 8325 ARROWRIDGE Blvd CHARLOTTE, NC 28273 IVY HOLLOW LN

LOCATION BEAWLEY SCHOOL - TR BAY HARBOUR TL LAKE NOST - TR ~~SEA BREEZE~~ 3RD LOT ON LFT.

SUBDIVISION HARBOUR BLOCK / SECTION II LOT 19 LOT AREA 24220 Ft± SITE CLASS. PS DESIGN FLOW 480GPD L.T.A.R. .3 GAD/Ft±

Septic Tank: 1000 Gallons; STB 794 Date 8/25/97

Pump Tank: 1000 Gallons; PT 27 Date 10/17/97

Pump Make: HYDROMATIC Model SK50A1 Serial No. 9-97

Nitrification Field: No Fields 1 Square Feet 1200 Linear Feet 400

No Lines 4 Trench Width 36" Max Trench Bottom Depth 36" Gravel Depth N/A

☑ New System ☐ Repair System Type: I, II, (III) IV, V, VI

System Description: PUMP CHAMBERED

Repair System Description: PUMP PANEL

Maintenance Agreement Required: ☐ Yes ☑ No

☑ House/Mod. Home No. Bedrooms 4

☐ Mobile Home No. Bathrooms 4

☐ Business No. Employees

☐ Other

☐ Slab ☑ Crawl Space ☐ Basement w/plumbing ☐ Basement wo/plumbing


Water Supply:
☐ Individual
☑ Community
☐ Public

Comments:

Comments:

INITIAL SITE SKETCH

1"=40'

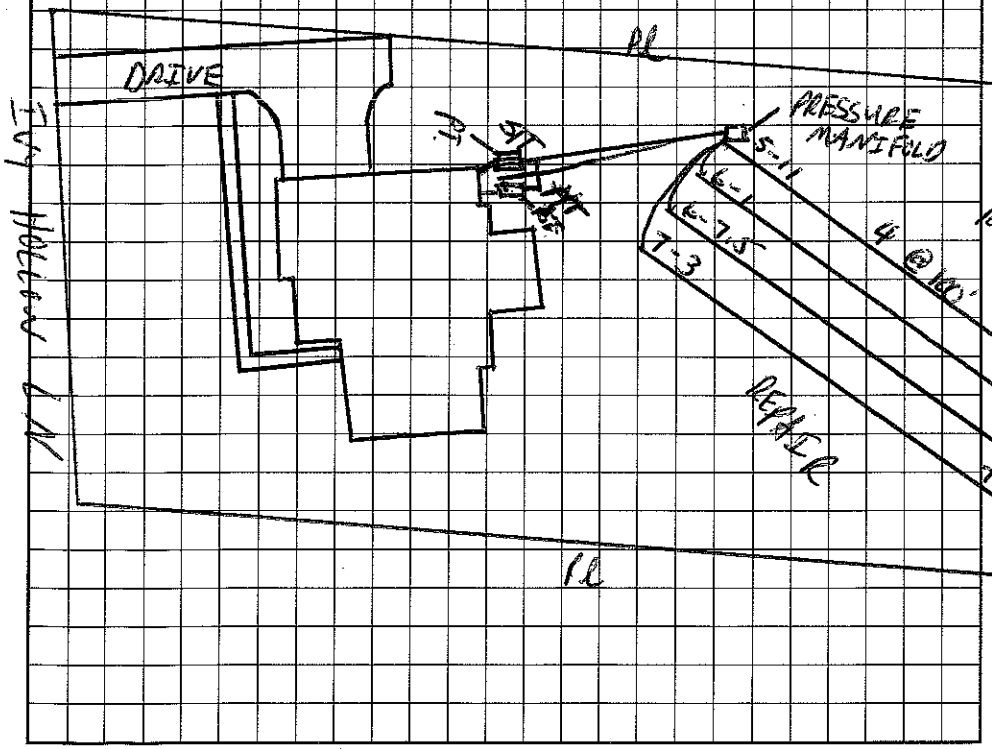

AS BUILT SKETCH

I understand that this permit can be suspended or revoked if any false information is supplied toward securing the permit/any unauthorized changes are made to the site/any unauthorized changes are made in the installation of the system.

Signed: Tommy Jacobs OBO (Agent) Installed by: Macleod Const

Improvement Permit by: C. Baty Ferree EHSI date 10/25/96

Certificate of Completion by: date

Existing System Inspection by: C. Baty Ferree EHSI date 10/28/96

Operation Permit by: Wesley Sparks RS. date 1/28/98

HEALTH DEPT. COPY: WHITE INSPECTION COPY (FINAL): GREEN OWNER COPY (FINAL): YELLOW INSPECTION COPY (INITIAL): PINK OWNER COPY (INITIAL): GOLD