IREDELL COUNTY HEALTH DEPARTMENT

STATESVILLE 704-878-5305 MOORESVILLE 704-664-5281

IMPROVEMENT PERMIT / AUTHORIZATION TO CONSTRUCT / OPERATION PERMIT / EXISTING SYSTEM INSPECTION

PERMIT# 25751 PIN# pt of 2CA3 4625 57 6096 DATE 7/27/98

OWNER OR CONTRACTOR John Wieland Homes PHONE: Business 664-3033 Home

ADDRESS

LOCATION Brawley Sch, TR Bay Harbour TL LakeMist TL Stormy Pointe, at end off cul de sac

SUBDIVISION Harbour BLOCK / SECTION 4 LOT 7+7A LOT AREA ~1 Ac SITE CLASS. PS DESIGN FLOW 480 L.T.A.R. .3 on 7A

Septic Tank: 1000 Gallons; STB 794 Date 9/22/98

Pump Tank: 1000 Gallons; PT 27 Date 12/7/98

Pump Make: Model SHEF 100 A2 Serial No. 9/98

Nitrification Field: No Fields 1 Square Feet 1200 Linear Feet 400

No Lines 4 Trench Width 36" Max Trench Bottom Depth 36" Gravel Depth SAND

☒ New System ☐ Repair System Type: I, II, (III), IV, V, VI

System Description: PM-CH PLASTIC ON LOT 7A

Repair System Description: OFFSITE ON 7A

Maintenance Agreement Required: ☒ Yes ☐ No

☐ Slab ☐ Crawl Space ☐ Basement w/plumbing ☐ Basement wo/plumbing

☒ House/Mod. Home No. Bedrooms 4

☐ Mobile Home No. Bathrooms 4

☐ Business No. Employees


☐ Other

Water Supply:
☐ Individual
☐ Public
☒ Community


Comments:/Conditions:

Comments:/Conditions:

INITIAL SITE SKETCH

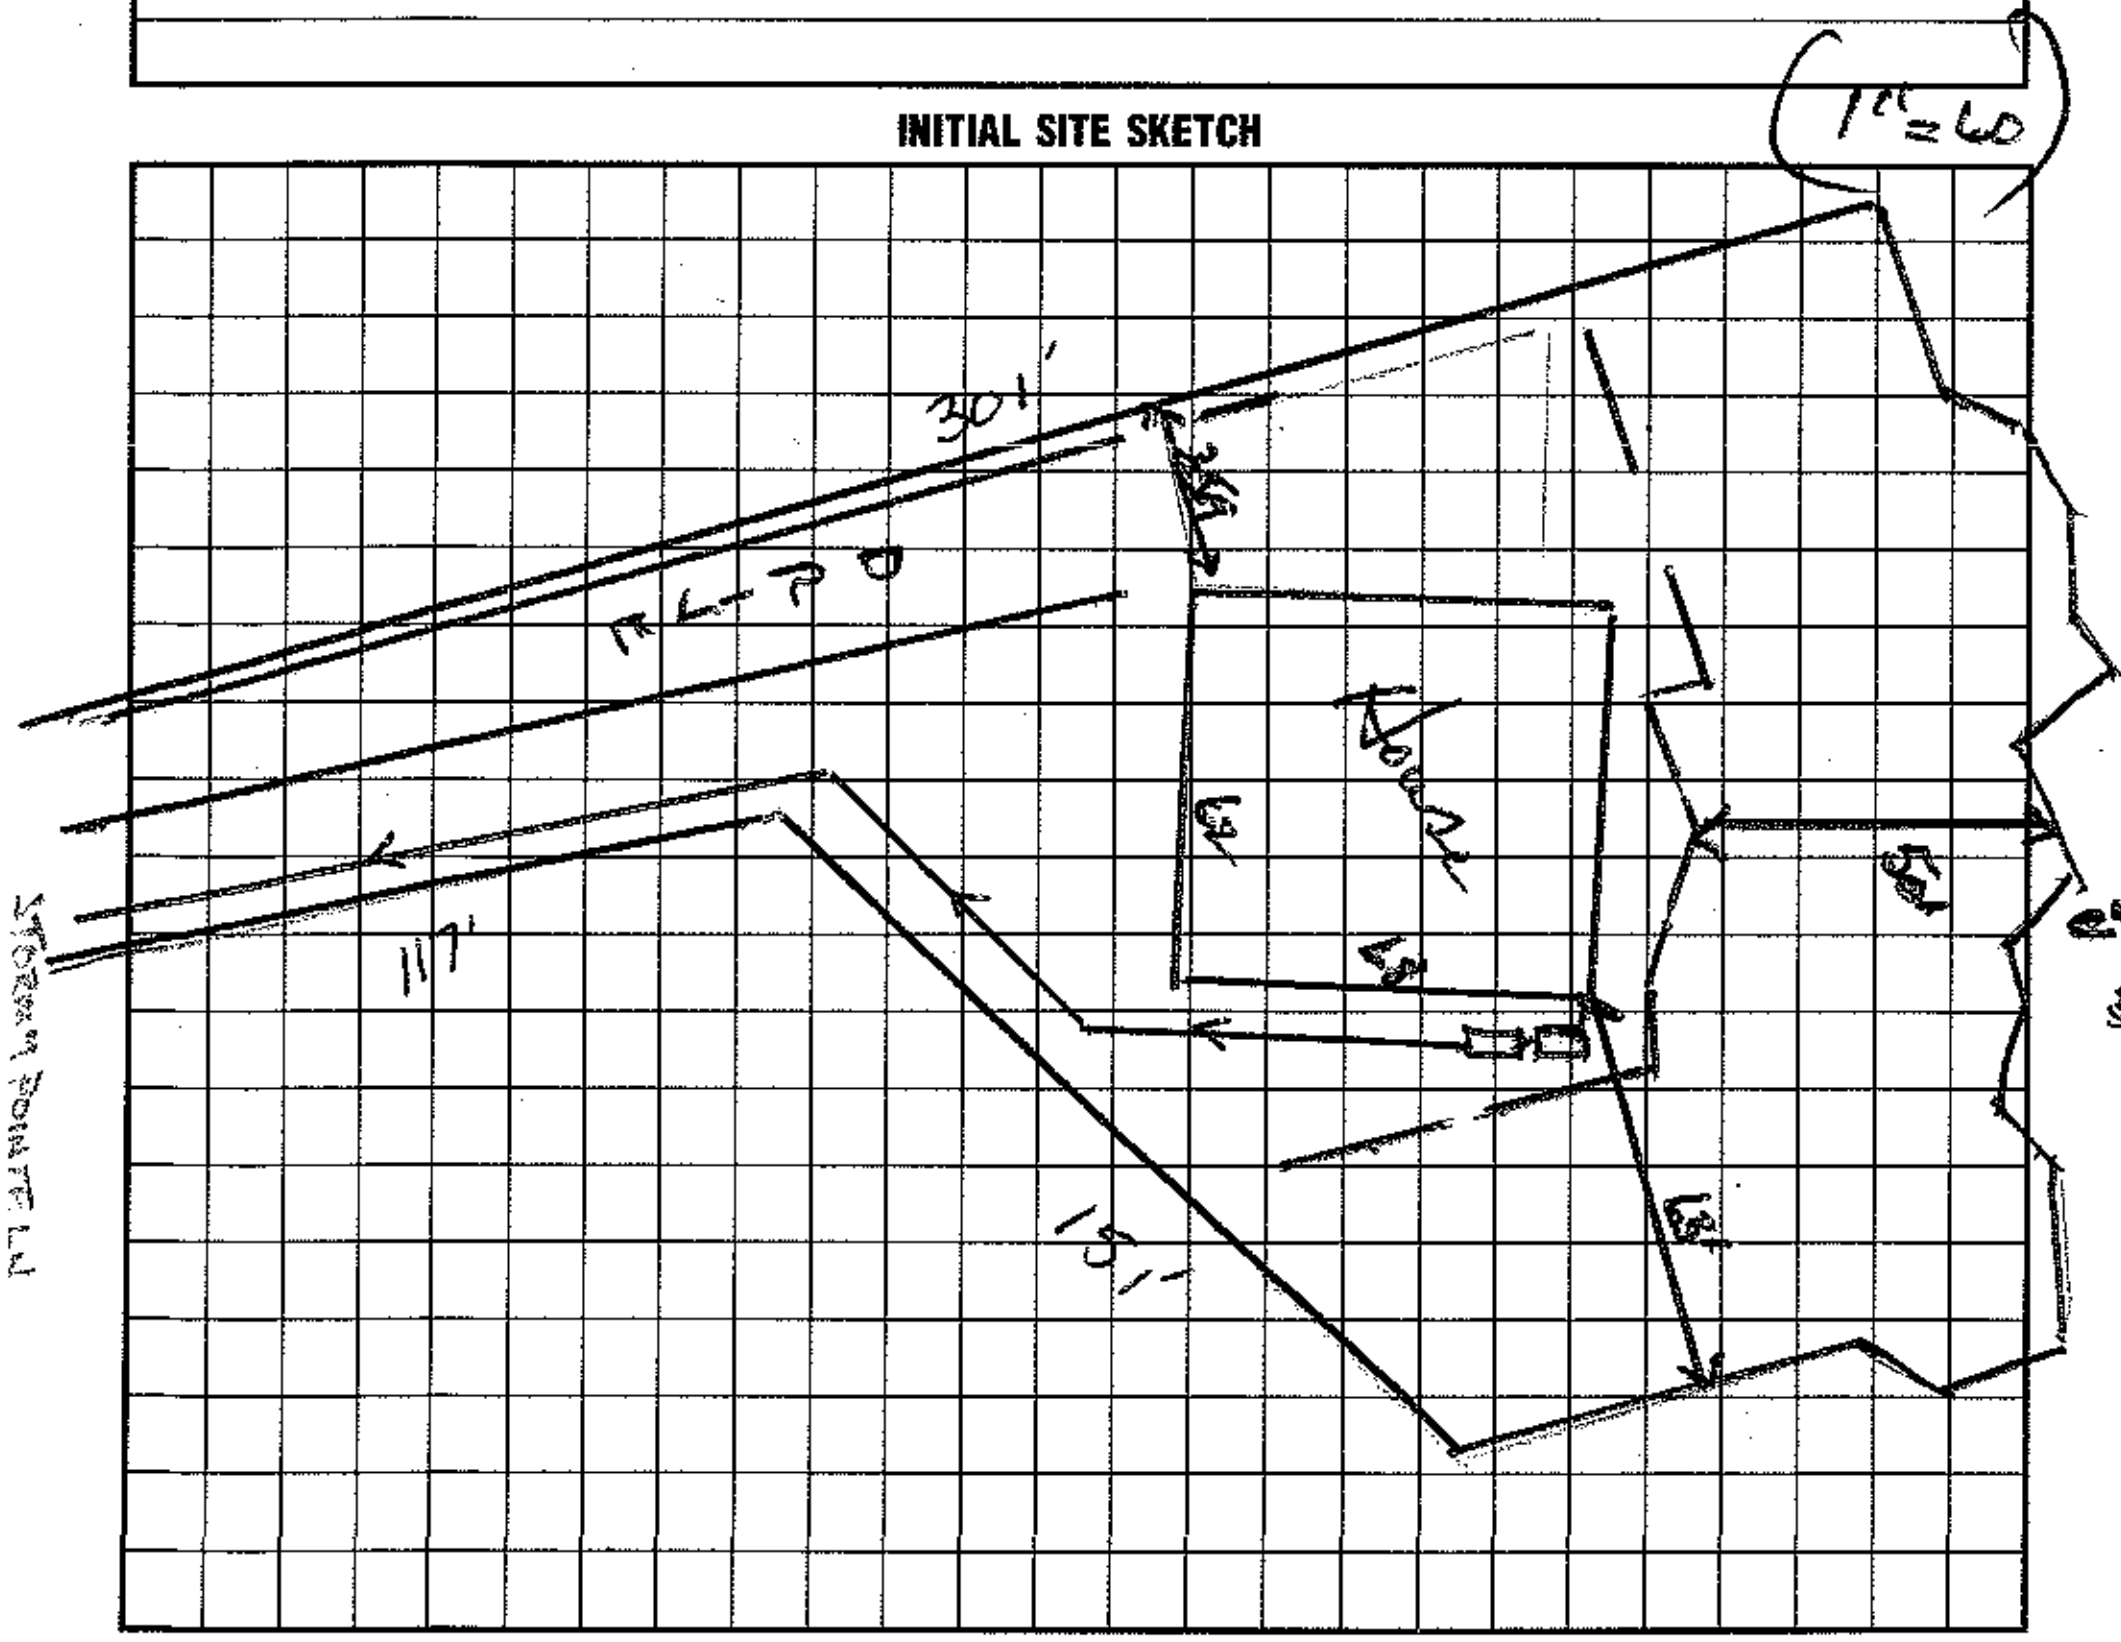

AS BUILT SKETCH

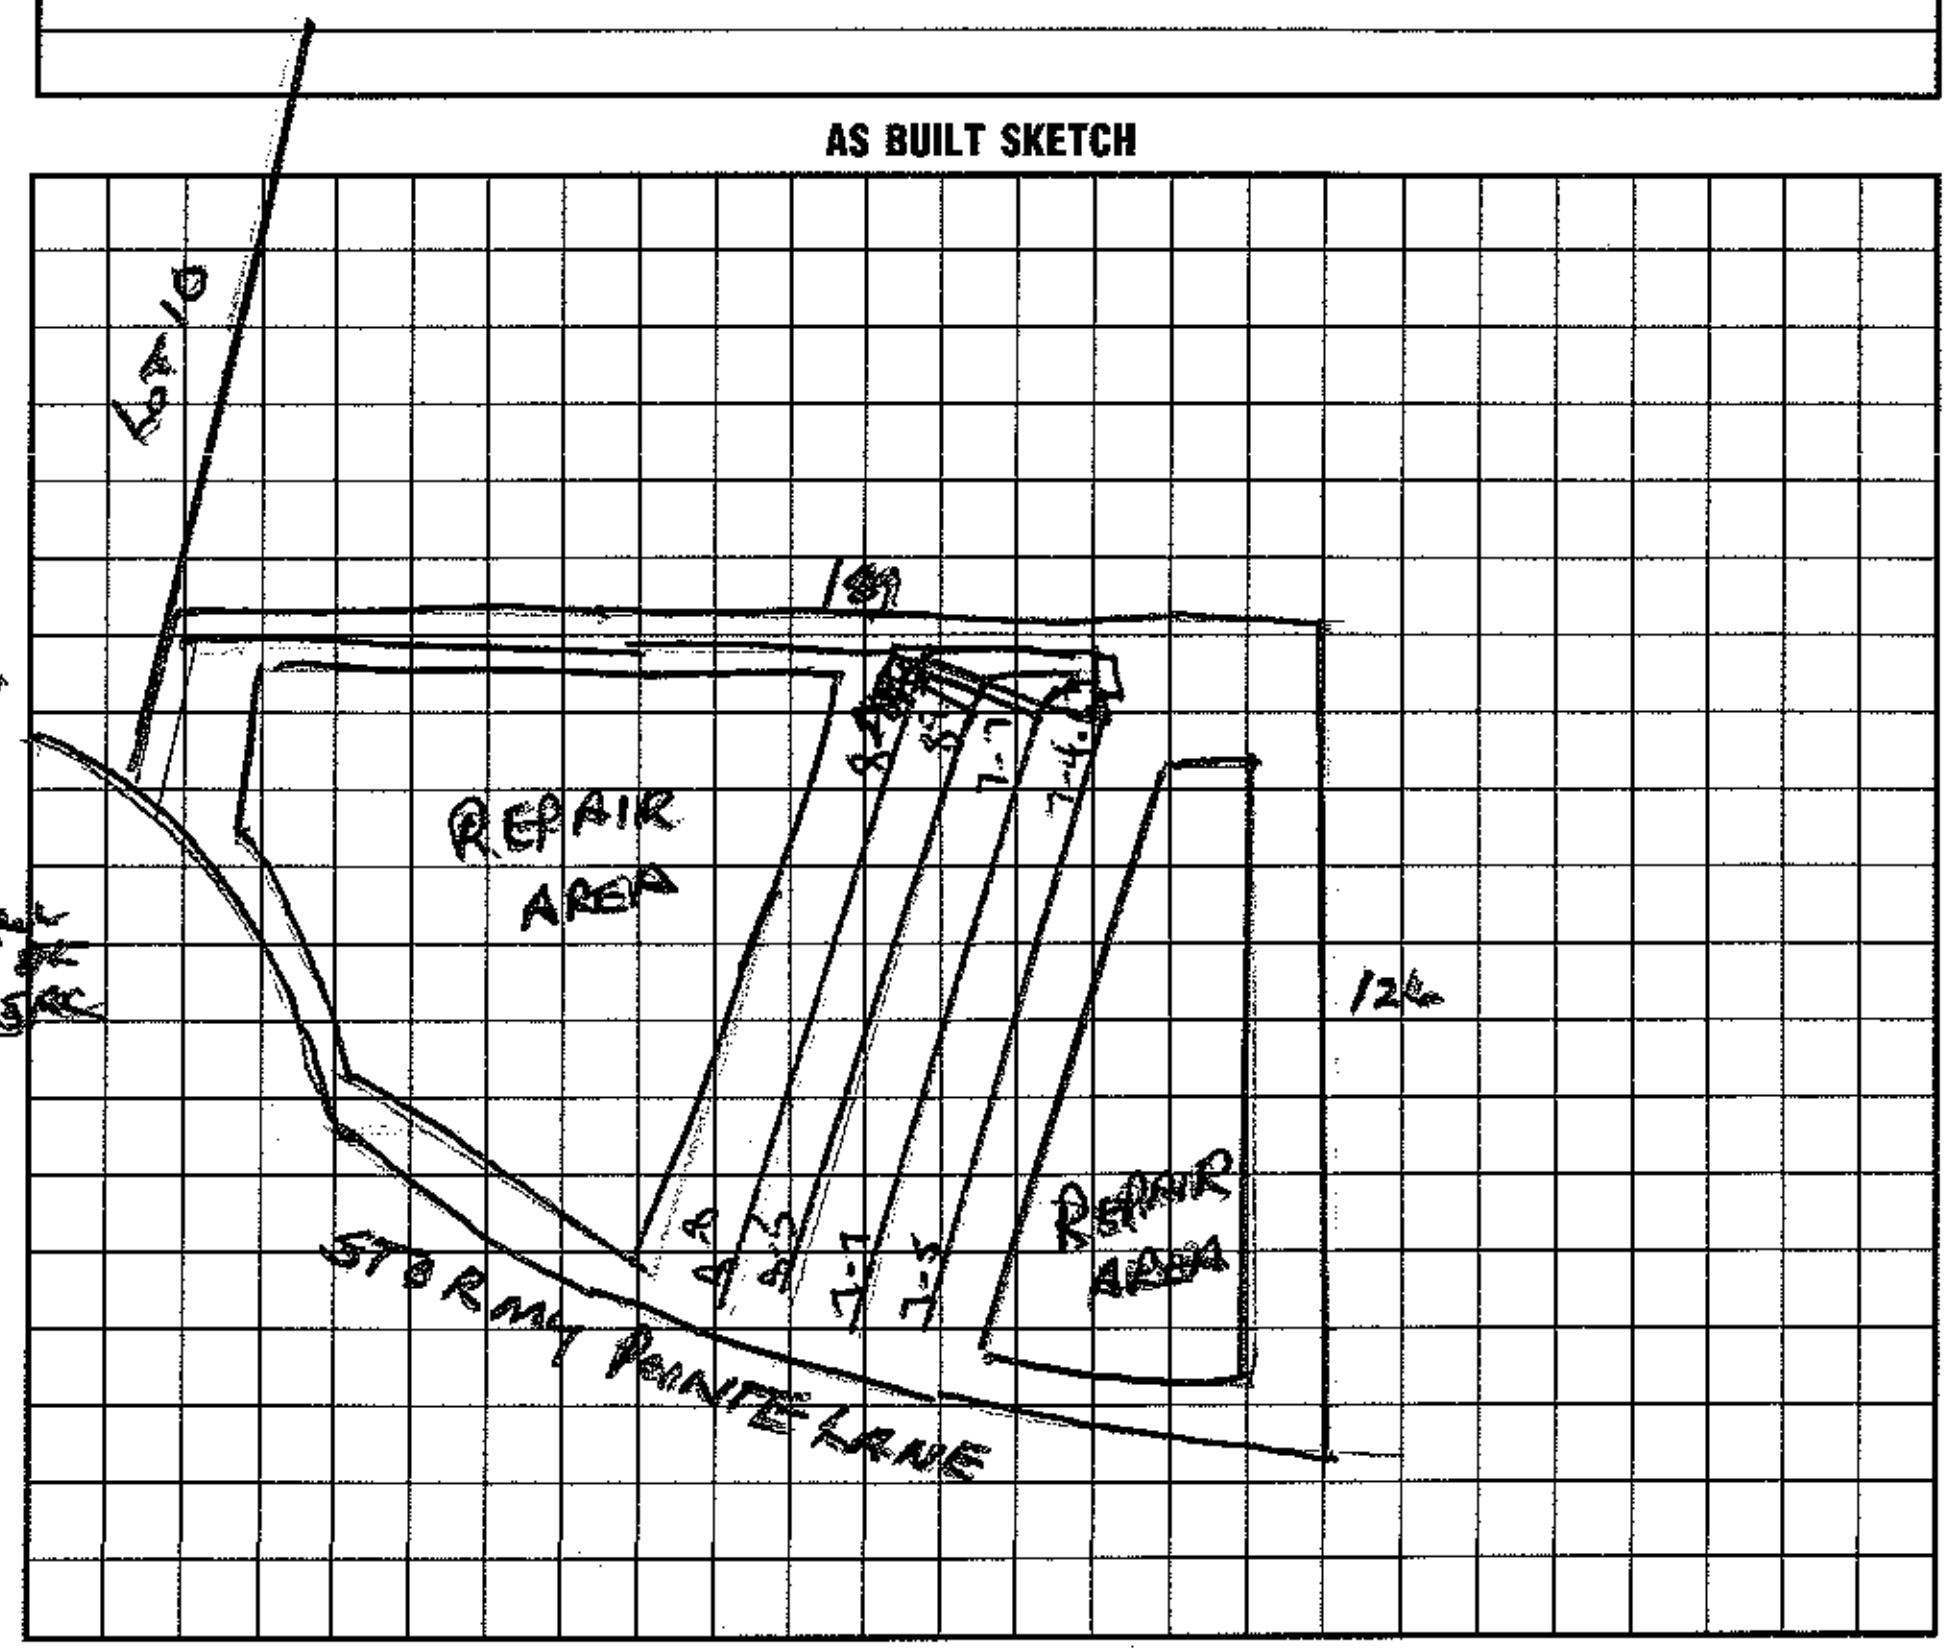

I understand that this permit can be suspended or revoked if any false information is supplied toward securing the permit/any unauthorized changes are made to the site/any unauthorized changes are made in the installation of the system. Improvement Permit with plat valid without expiration. Improvement Permit with site plan valid for sixty months. Authorization to Construct is valid for a period equal to that of Improvement Permit – not to exceed sixty months.

Signed: ✗ J Hall date 7/28/98

Improvement Permit by Wesley Sparks RS date 7/27/98

Authorization to Construct by: Wesley Sparks RS. date 7/27/98

Installed by: MacLeod Const.

Operation Permit by: Wesley Sparks RS date 2/10/99

Existing System Inspection by: date

HEALTH DEPT. COPY: WHITE INSPECTION COPY (FINAL): GREEN OWNER COPY (FINAL): YELLOW INSPECTION COPY (INITIAL): PINK OWNER COPY (INITIAL): GOLD