IREDELL COUNTY HEALTH DEPARTMENT

→ AUTHORIZATION TO CONSTRUCT

STATESVILLE 704-878-5305 MOORESVILLE 704-664-5281

IMPROVEMENT PERMIT / ~~CERTIFICATE OF COMPLETION~~ / OPERATION PERMIT / EXISTING SYSTEM INSPECTION

PROPERTY DESCRIPTION NO. 24831 DATE 10/29/96 TAX MAP NO. 2C-4-3 pt of Watershed: ☑ Yes ☐ No

OWNER OR CONTRACTOR JOHN WIELAND HOMES PHONE: Business 663-6905-(T. JACOBS) ~~Home~~ 4625-57-6862

ADDRESS 8325 ARROWREDGE BLVD. CHARLOTTE 28273

LOCATION BRAWLEY SCHOOL - TL BAY HARBOUR - TL LAKE NEST

SUBDIVISION HARBOUR BLOCK / SECTION II LOT 20 LOT AREA 24,111 FT² SITE CLASS. RS DESIGN FLOW 480 GPD L.T.A.R. .3 GPD/FT²

Septic Tank: 1000 Gallons; STB 794 Date 5/27/97

Pump Tank: _____ Gallons; PT _____ Date _____

Pump Make: _____ Model _____ Serial No. _____

Nitrification Field: No Fields 1 Square Feet 1200 Linear Feet 400

No Lines 4 Trench Width 36" Max Trench Bottom Depth 36" Gravel Depth N/A

☑ New System ☐ Repair System Type: I, II, (III) IV, V, VI

System Description: GRAVITY CHAMBERED ORSENT

Repair System Description: PANEL

Maintenance Agreement Required: ☐ Yes ☑ No

☑ House/Mod. Home No. Bedrooms 4

☐ Mobile Home No. Bathrooms 4

☐ Business No. Employees _____

☐ Other _____


☐ Slab ☑ Crawl Space ☐ Basement w/plumbing ☐ Basement wo/plumbing

Water Supply:
☐ Individual
☑ Community
☐ Public


Comments:

Comments:

INITIAL SITE SKETCH 1"=40'

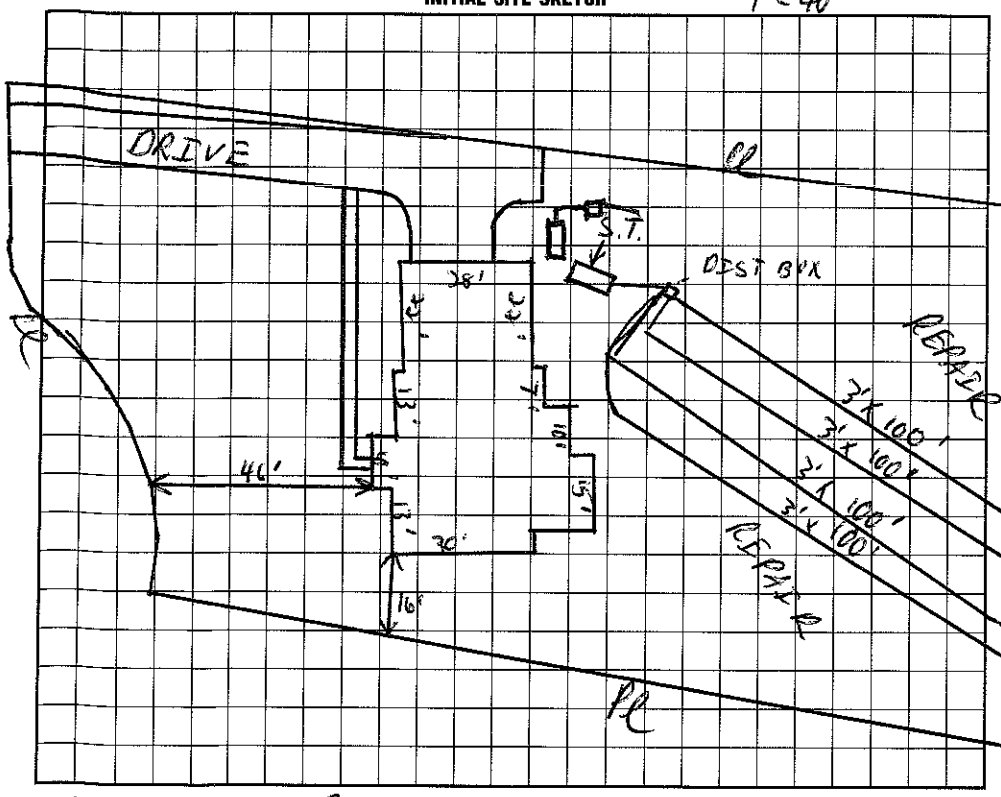

AS BUILT SKETCH

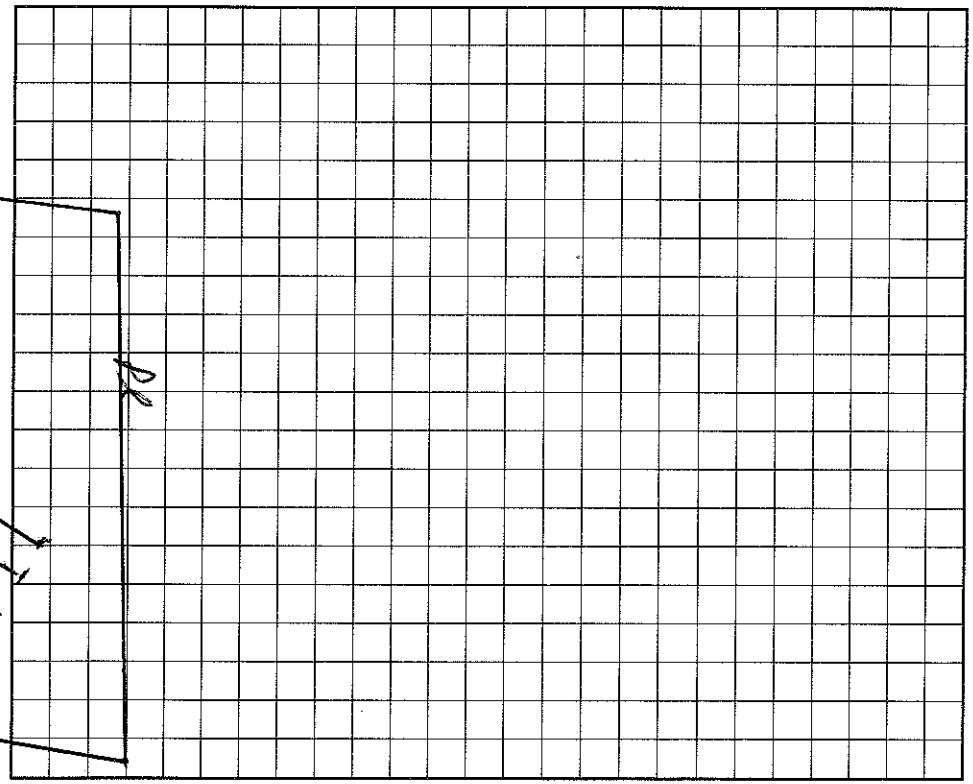

I understand that ~~this permit~~ can be ~~suspended~~ or revoked if any ~~false information~~ is supplied toward securing the permit/any unauthorized changes are made to the site/any unauthorized changes are made in the installation of the system.

Signed: _____ (Applicant)

Improvement Permit by: C. Bob Green EHSI date 10/29/96

~~Existing System Inspection~~ Authorization by: C. Bob Green EHSI date 10/30/96

TO CONSTRUCT

Installed by: NAS Lead Const. Co.

Certificate of Completion by: Wesley Sparks RS. date 8/20/97

Operation Permit by: Wesley Sparks RS. date 8/20/97

HEALTH DEPT. COPY: WHITE INSPECTION COPY (FINAL): GREEN OWNER COPY (FINAL): YELLOW INSPECTION COPY (INITIAL): PINK OWNER COPY (INITIAL): GOLD