IREDELL COUNTY HEALTH DEPARTMENT

↗ AUTHORIZATION TO CONSTRUCT

STATESVILLE 704-878-5305 MOORESVILLE 704-664-5281

IMPROVEMENT PERMIT / ~~CERTIFICATE OF COMPLETION~~ / OPERATION PERMIT / EXISTING SYSTEM INSPECTION

PROPERTY DESCRIPTION NO. 069461 DATE 10/31/97 TAX MAP NO. 4625577107 Watershed: ☑ Yes ☐ No

OWNER OR CONTRACTOR JOHN WIELAND PHONE: Business 663-6905 Home

ADDRESS 8325 - ARROWRIDGE RD - CHARLOTTE NC 28273

LOCATION BRAWLEY - TR B34 HARBOUR - TL LAKE MIST - TL STORMY AT END

SUBDIVISION HARBOUR BLOCK / SECTION ~~X~~ 4 LOT ~~XX~~ 6 LOT AREA - SITE CLASS. PS DESIGN FLOW 450 L.T.A.R. .3

Septic Tank: 1000 Gallons; STB 312 Date 6/29/99

Pump Tank: 1000 Gallons; PT 27 Date 1/4/99

Pump Make: HYDROMATIC Model SHEE50A Serial No. 5/26/99

Nitrification Field: No Fields 1 Square Feet 540 Linear Feet 270

No Lines 6 @ 45' Trench Width 24" Max Trench Bottom Depth 36" Gravel Depth MA

☑ New System ☐ Repair System Type: I, II, III, (IV), V, VI

System Description: PUMP PANEL

Repair System Description: SAME

Maintenance Agreement Required: ☑ Yes ☐ No

☑ House/Mod. Home No. Bedrooms 4

☐ Mobile Home No. Bathrooms 4

☐ Business No. Employees

☐ Other


☐ Slab ☐ Crawl Space ☑ Basement w/plumbing ☐ Basement wo/plumbing

Water Supply: ☐ Individual ☑ Community ☐ Public


Comments:

Comments: PARTIAL BASEMENT

INITIAL SITE SKETCH

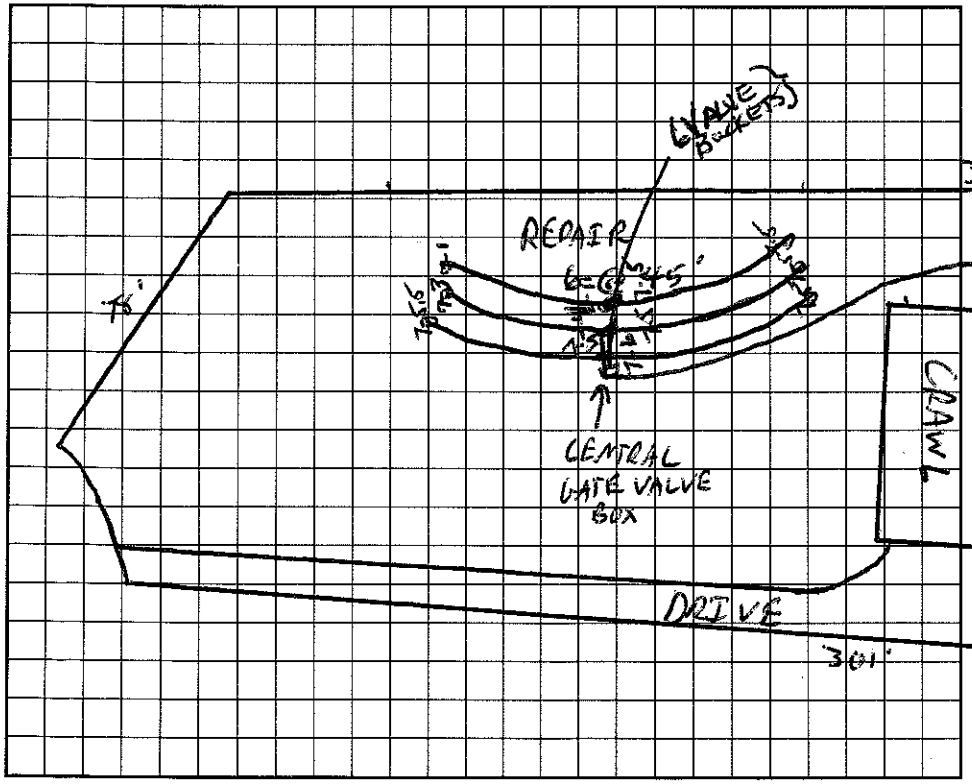

AS BUILT SKETCH

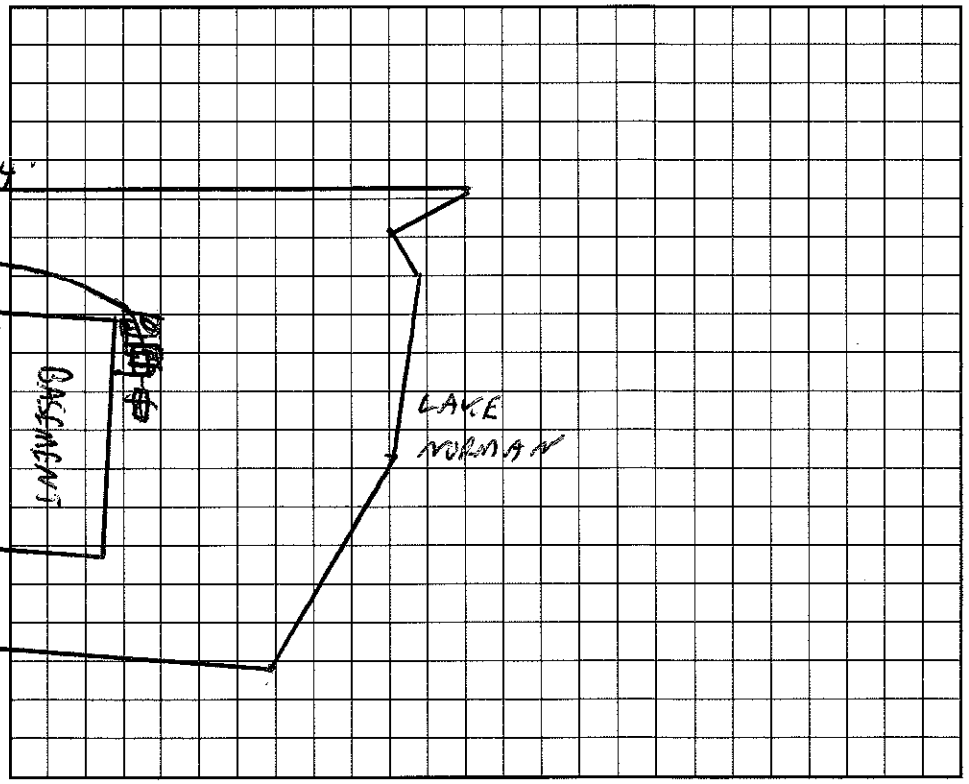

I understand that this permit can be suspended or revoked if any false information is supplied toward securing the permit/any unauthorized changes are made to the site/any unauthorized changes are made in the installation of the system. Improvement Permit is valid ~~for 60 months~~ from date of issuance.

Signed: [signature]

Improvement Permit by: [signature] RS date 10/31/97

Existing System Inspection by: [signature] RS date 10/31/97

Installed by: Macleod Const.

Certificate of Completion by: Wesley Sparks R.S. date 9/23/99

Operation Permit by: Wesley Sparks R.S. date 9/23/99

HEALTH DEPT. COPY: WHITE INSPECTION COPY (FINAL): GREEN OWNER COPY (FINAL): YELLOW INSPECTION COPY (INITIAL): PINK OWNER COPY (INITIAL): GOLD