IREDELL COUNTY HEALTH DEPARTMENT

STATESVILLE 704-878-5305 MOORESVILLE 704-664-5281

IMPROVEMENT PERMIT / AUTHORIZATION TO CONSTRUCT / OPERATION PERMIT / EXISTING SYSTEM INSPECTION

PERMIT# 069459 PIN# 4625 57 7217 DATE 12/3/98

OWNER OR CONTRACTOR John Wieland Homes PHONE: Business JACOBS 663-6905 Home

ADDRESS 8325 D Crownridge Blvd. Charlotte, NC. 28273

LOCATION 1100 TR Bay Harbour TL Lake Misty TL Stormy Pointe Lane, off end of cul de sac

SUBDIVISION HARBOUR BLOCK / SECTION 4 LOT 5 LOT AREA > 32000 FT² SITE CLASS. PS DESIGN FLOW 480 L.T.A.R. .3

Septic Tank: 1000 Gallons; STB 312 Date 5/14/99

Pump Tank: 1000 Gallons; PT 27 Date 5/14/99

Pump Make: HYDROMATIC Model SHEF50A1 Serial No. 5/99

Nitrification Field: No Fields 1 Square Feet 1200* Linear Feet 400*

No Lines 3 Trench Width 36" Max Trench Bottom Depth 36"

[X] New System [ ] Repair System Type: I, II, (III), IV, V, VI

System Description: PRES. MAN. — CH. PLASTIC

Repair System Description: SAME

Maintenance Agreement Required: [X] Yes [ ] No

Gravel Depth. SAND

[X] House/Mod. Home [ ] Mobile Home [ ] Business [ ] Other

No. Bedrooms 4 No. Bathrooms 4 No. Employees


[ ] Slab [ ] Crawl Space [X] Basement w/plumbing [ ] Basement wo/plumbing

Water Supply: [ ] Individual [ ] Public [X] Community


Comments:/Conditions: + 25% reduction figured - should system described on this permit

Comments:/Conditions: Supply line runs across back of house then across front yard to Pres Manifold box.

INITIAL SITE SKETCH

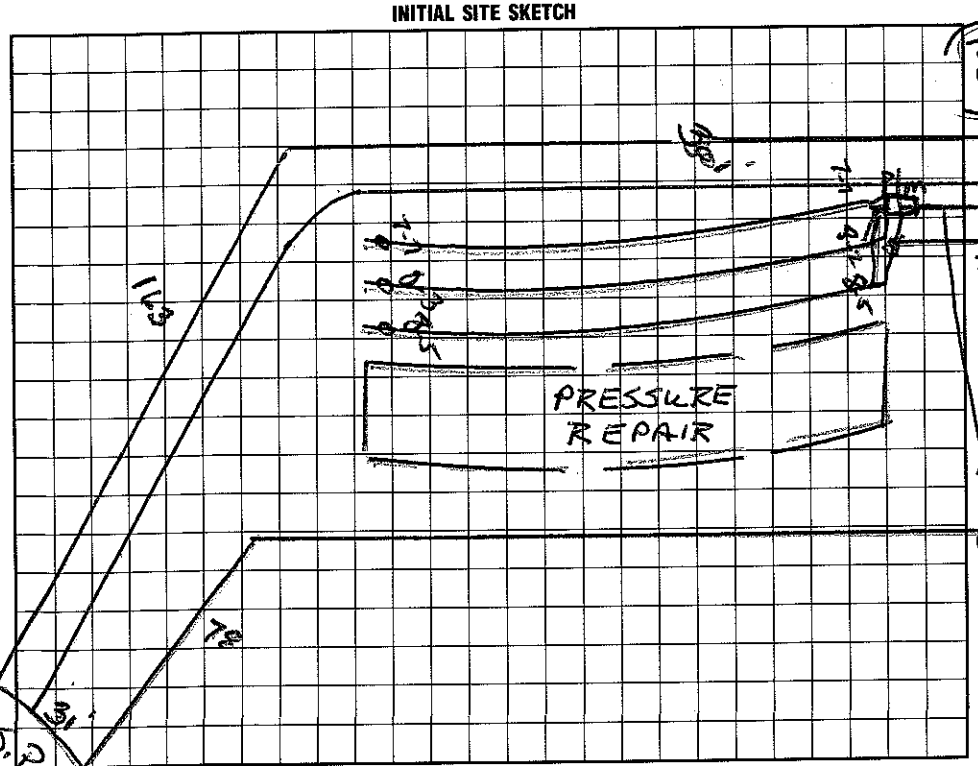

AS BUILT SKETCH

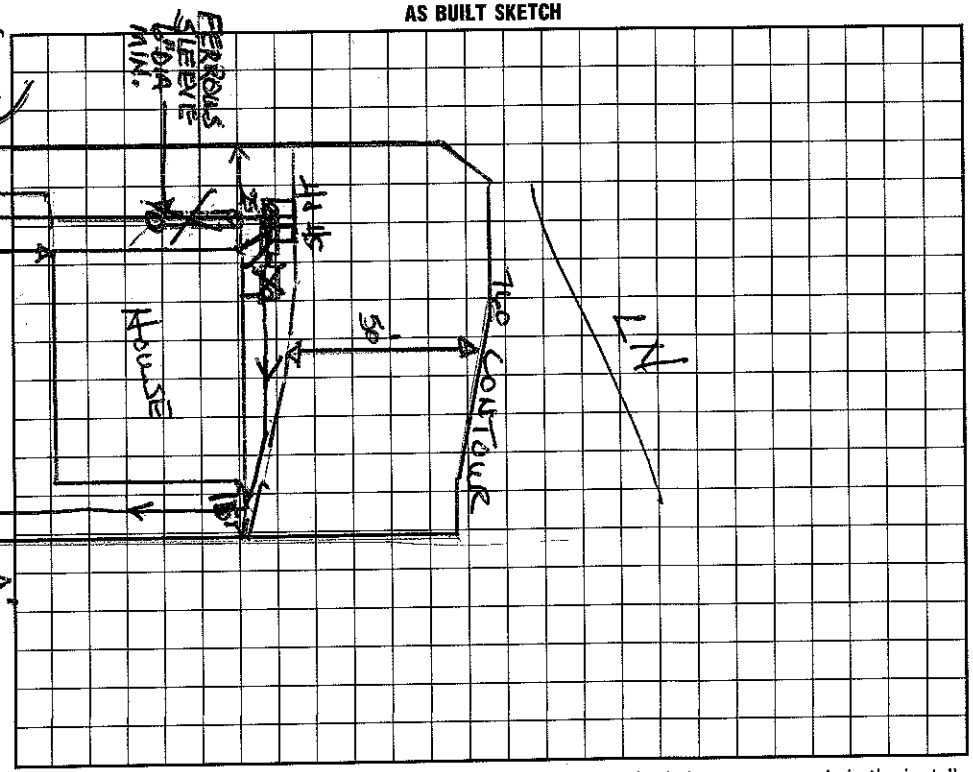

I understand that this permit can be suspended or revoked if any false information is supplied toward securing the permit/any unauthorized changes are made to the site/any unauthorized changes are made in the installation of the system. Improvement Permit with plat valid without expiration. Improvement Permit with site plan valid for sixty months. Authorization to Construct is valid for a period equal to that of Improvement Permit – not to exceed sixty months.

Signed: [signature] date 2-23-99 Installed by: Macleod Const.

Improvement Permit by: date

Authorization to Construct by: Wesley Sparks RS date 12/3/98 Operation Permit by: Wesley Sparks RS. date 8/11/99

Existing System Inspection by: date

HEALTH DEPT. COPY: WHITE INSPECTION COPY (FINAL): GREEN OWNER COPY (FINAL): YELLOW INSPECTION COPY (INITIAL): PINK OWNER COPY (INITIAL): GOLD