IREDELL COUNTY HEALTH DEPARTMENT

AUTHORIZATION TO CONSTRUCT

STATESVILLE 704-878-5305 MOORESVILLE 704-664-5281

IMPROVEMENT PERMIT / ~~CERTIFICATE OF COMPLETION~~ / OPERATION PERMIT / EXISTING SYSTEM INSPEC

PROPERTY DESCRIPTION NO. 069458 DATE 10/23/97 TAX MAP NO. 4625577327 Watershed: ☑ Yes

OWNER OR CONTRACTOR JOHN WIELAND PHONE: Business 663-6905 Home

ADDRESS 8325-D ARROWPOINTE RD CHARLOTTE NC 28273

LOCATION BRAWLEY SCHOOL - TR BAY HARBOUR - TL LAKE WEST - TL STORMY 4TH ON LT. 117 Stormy Pointe Ln

SUBDIVISION HARBOUR BLOCK / SECTION 4 LOT 4 LOT AREA SITE CLASS. PS DESIGN FLOW 450 GPD L.T.A.R. 3 GPD/LTA

Septic Tank: 1000 Gallons; STB 794 Date 7/3/97

Pump Tank: 1000 Gallons; PT 27 Date 7/5/97

Pump Make: SHEF 50A1 Model HYDROMATIC Serial No. 5/99

Nitrification Field: No Fields 1 Square Feet 1200 Linear Feet 400

No Lines 4 @ 100' Trench Width 36" Max Trench Bottom Depth 36" Gravel Depth N/A

☑ New System ☐ Repair System Type: I, II, (III), IV, V, VI

System Description: PUMP CHAMBERED OR HDS

Repair System Description: SAME

Maintenance Agreement Required: ☐ Yes ☑ No

☑ House/Mod. Home No. Bedrooms 4

☐ Mobile Home No. Bathrooms 4

☐ Business No. Employees

☐ Other


☐ Slab ☐ Crawl Space ☑ Basement w/plumbing ☐ Basement wo/plumbing

Water Supply: ☐ Individual ☑ Community ☐ Public


Comments:

Comments: PARTIAL
Soil compacted

INITIAL SITE SKETCH

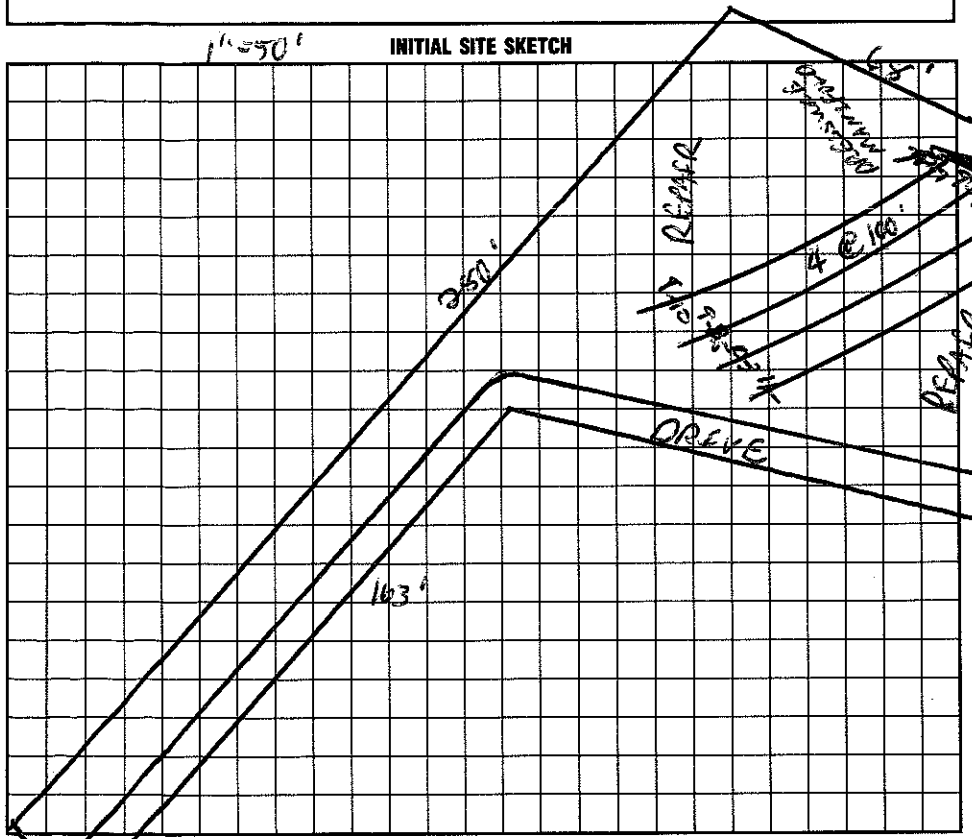

AS BUILT SKETCH

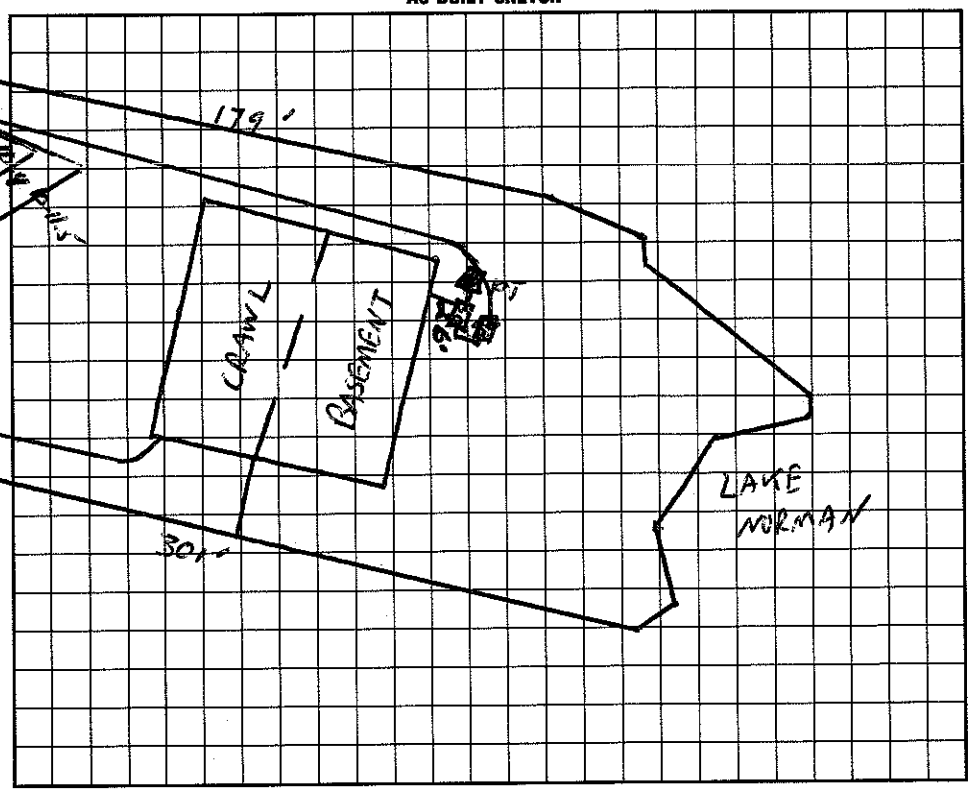

I understand ~~that this~~ permit can be suspended or revoked if any false information is supplied toward securing the permit/any unauthorized changes are made to the site/any unauthorized changes are made in the installation of the system. Improvement Permit is valid for ~~60~~ months from date of issuance.

Signed:

Improvement Permit by: C. Brady Freeman RS date 10/23/97

~~Existing System Inspection by:~~ AUTHORIZATION TO CONSTRUCT C. Brady Freeman RS date 10/23/97

Installed by: MacLeod Const.

Certificate of Completion by: Wesley Hawks RS. date 9/17/99

Operation Permit by: Wesley Hawks RS. date 9/17/99

HEALTH DEPT. COPY: WHITE INSPECTION COPY (FINAL): GREEN OWNER COPY (FINAL): YELLOW INSPECTION COPY (INITIAL): PINK OWNER COPY (INITIAL): GOLD