IREDELL COUNTY HEALTH DEPARTMENT

→ AUTHORIZATION TO CONSTRUCT

STATESVILLE 704-878-5305 MORESVILLE 704-664-5281

$ 400.00 PAID 11-8-96

IMPROVEMENT PERMIT / ~~CERTIFICATE OF COMPLETION~~ / OPERATION PERMIT / EXISTING SYSTEM INSPECTION

PROPERTY DESCRIPTION NO. 24833 DATE 11/4/96 TAX MAP NO. ~~2L A-3 pt of~~ 4625577485 Watershed: ☒ ~~Yes~~ ☐ No

OWNER OR CONTRACTOR JOHN WIELAND PHONE: Business 663-6905 (T. JACOBS) Home

ADDRESS 8325 ARROWRIDGE BLVD. CHARLOTTE 28273

LOCATION BRAWLEY SCHOOL RD - TR BAY HARBOUR - TL LAKE MIST - TL ~~SEA BREEZE~~ IVY HOLLOW LN - 5th LOT ON RT, END OF DRIVEWAY

SUBDIVISION HARBOUR BLOCK / SECTION II LOT 25 LOT AREA 32,179 FT² SITE CLASS. PS DESIGN FLOW 480 GPD L.T.A.R. .3 GPD/FT²

Septic Tank: 1000 Gallons; STB 312 Date 5/10/99
Pump Tank: 1000 Gallons; PT 27 ~~31~~ Date 5/3/99
Pump Make: Model Serial No.
Nitrification Field: No Fields 1 Square Feet 840 Linear Feet 280
No Lines 4 Trench Width ~~3'~~ 36" Max Trench Bottom Depth 36" Gravel Depth N/A

☒ New System ☐ Repair System Type: I, II, III, (IV), V, VI
System Description: PUMP PANEL
Repair System Description: SAME
Maintenance Agreement Required: ☒ Yes ☐ No

☒ House/Mod. Home No. Bedrooms 4
☐ Mobile Home No. Bathrooms 4
☐ Business No. Employees
☐ Other


☐ Slab ☐ Crawl Space ☒ Basement w/plumbing ☐ Basement wo/plumbing

Water Supply:
☐ Individual
☒ Community
☐ Public

Comments: LINES SHALL BE INDIVIDUALLY PRESSURIZED.

Comments:

INITIAL SITE SKETCH 1" = 50'

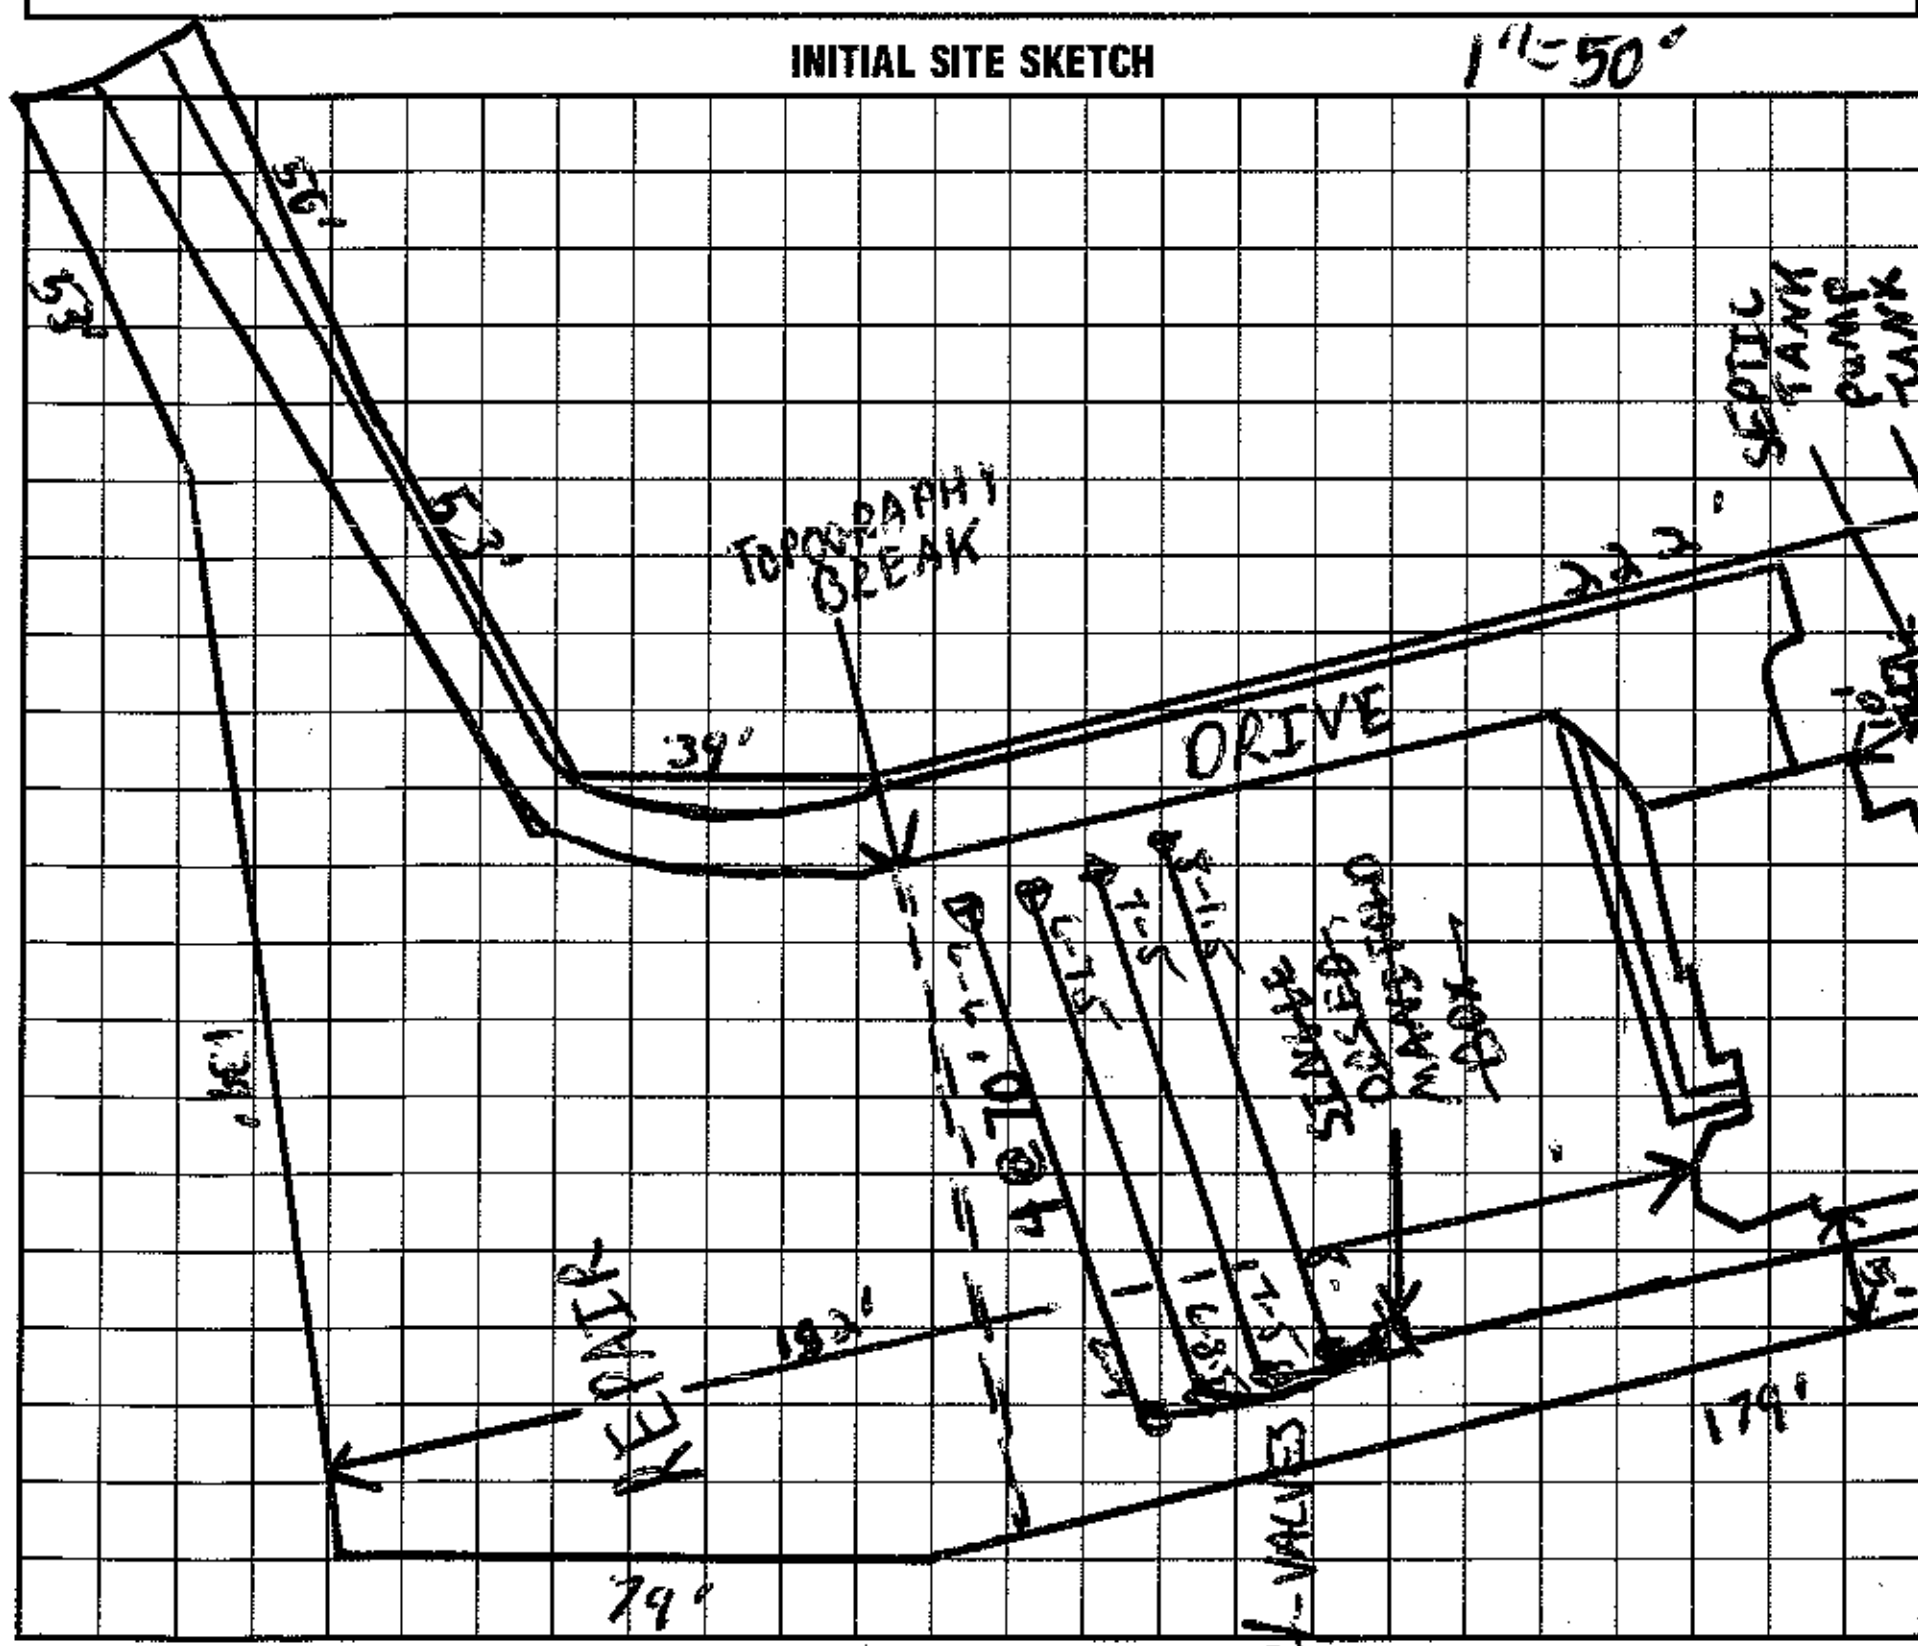

AS BUILT SKETCH

I understand that this permit can be suspended or revoked if any false information is supplied toward securing the permit/any unauthorized changes are made to the site/any unauthorized changes are made in the installation of the system.

Signed: [signature], CPSS 11/8/96
Improvement Permit by: C. [signature] EHSI date 11/4/96
AUTHORIZATION TO CONSTRUCT ~~Existing System Inspection~~ by: C. [signature] EHSI date 11/4/96

Installed by: MacLeod Const.
Certificate of Completion by: Wesley Sparks, R.S. date 9/7/99
Operation Permit by: Wesley Sparks R.S. date 9/7/99

HEALTH DEPT. COPY: WHITE INSPECTION COPY (FINAL): GREEN OWNER COPY (FINAL): YELLOW INSPECTION COPY (INITIAL): PINK OWNER COPY (INITIAL): GOLD