IREDELL COUNTY HEALTH DEPARTMENT

STATESVILLE 704-878-5305 MOORESVILLE 704-664-5281

IMPROVEMENT PERMIT / AUTHORIZATION TO CONSTRUCT / OPERATION PERMIT / EXISTING SYSTEM INSPECTION

PERMIT# 076563 PIN# 4625 57 8526 DATE 10/12/98

OWNER OR CONTRACTOR JOHN WIELAND HOMES PHONE: Business 663-6905 - T JACOBS Home

ADDRESS CHARLOTTE

LOCATION BRAWLEY SCHOOL - TR BAY HARBOUR - TL LAKE MEST - TL IVY HOLLOW CT

SUBDIVISION HARBOUR BLOCK / SECTION II LOT 24 LOT AREA SITE CLASS. RS DESIGN FLOW 480GPD L.T.A.R. .30RD/FT2

Septic Tank: 1000 Gallons; STB 312 Date 7/8/99

Pump Tank: 1000 Gallons; PT 27 Date 7/7/99

Pump Make: ~~HYDROMATIC~~ Model SHEP50A1 Serial No. 8/99

Nitrification Field: No Fields 1 Square Feet 560 Linear Feet 280

No Lines 4@70' Trench Width 24" Max Trench Bottom Depth 36" Gravel Depth N/A

☑ New System ☐ Repair System Type: I, II, III (IV) V, VI

System Description: PUMP PANEL

Repair System Description: SAME

Maintenance Agreement Required: ☑ Yes ☐ No

☑ House/Mod. Home No. Bedrooms 4

☐ Mobile Home No. Bathrooms 4

☐ Business No. Employees

☐ Other


☐ Slab ☑ Crawl Space ☐ Basement w/plumbing ☐ Basement wo/plumbing

Water Supply: ☐ Individual ☐ Public ☑ Community


Comments:/Conditions:

Comments:/Conditions:

INITIAL SITE SKETCH

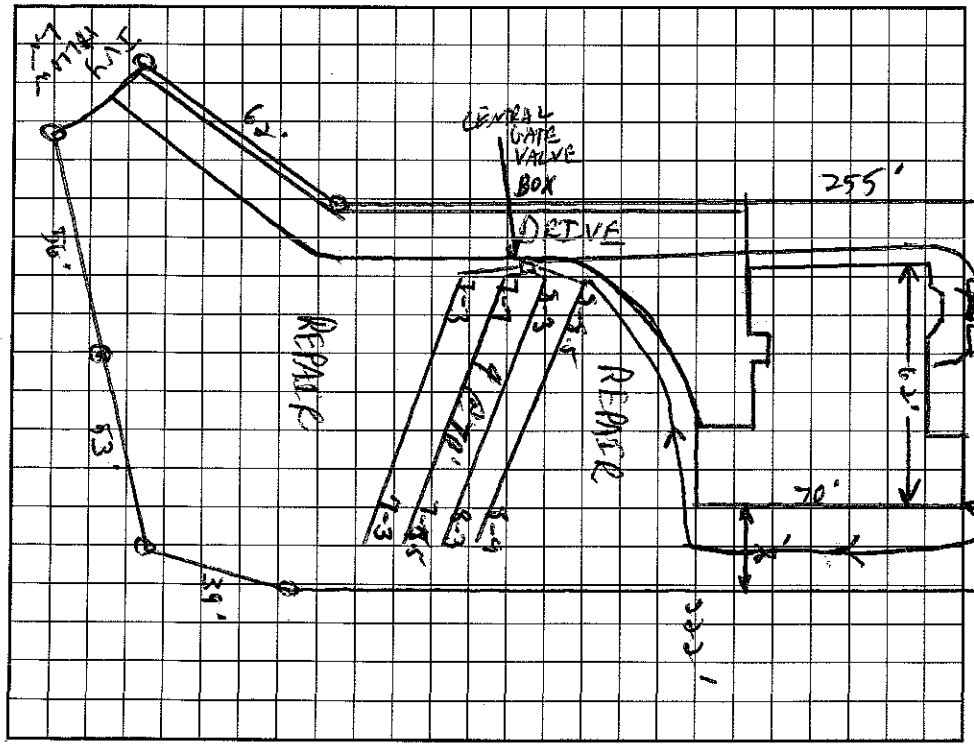

AS BUILT SKETCH

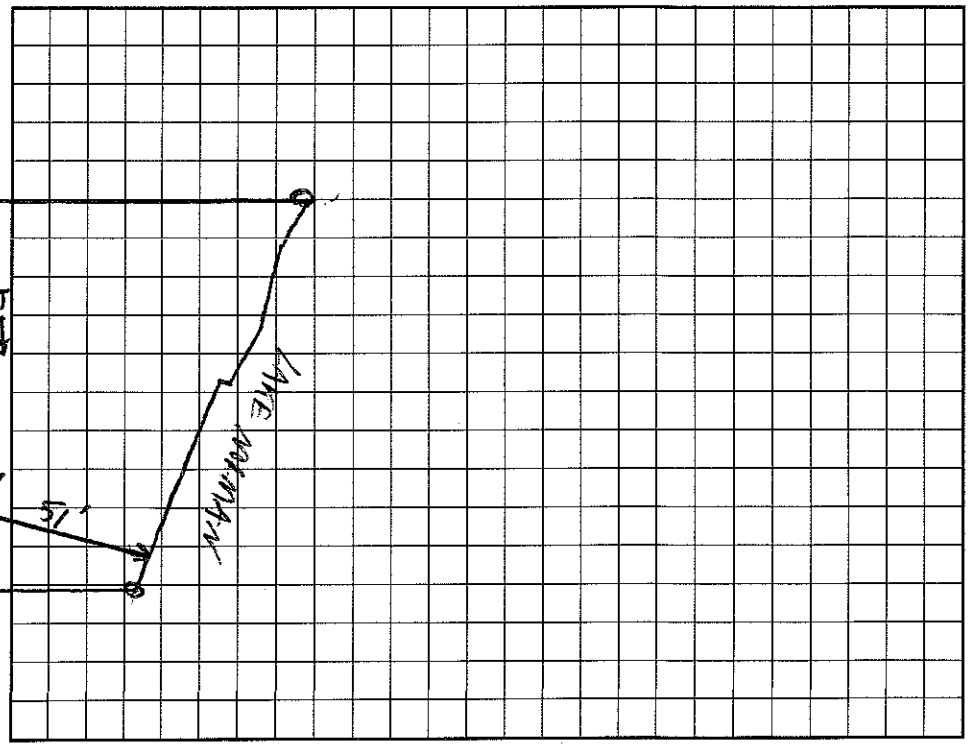

I understand that this permit can be suspended or revoked if any false information is supplied toward securing the permit/any unauthorized changes are made to the site/any unauthorized changes are made in the installation of the system. Improvement Permit with plat valid without expiration. Improvement Permit with site plan valid for sixty months. Authorization to Construct is valid for a period equal to that of Improvement Permit – not to exceed sixty months.

Signed: [signature] date 10/12/98 Installed by: Machaud Const.

Improvement Permit by: [signature] R.S. date 10/12/98 Operation Permit by: Wesley Sparks R.S. date 11/29/99

Authorization to Construct by: [signature] R.S. date 10/12/98 Existing System Inspection by: date

HEALTH DEPT. COPY: WHITE INSPECTION COPY (FINAL): GREEN OWNER COPY (FINAL): YELLOW INSPECTION COPY (INITIAL): PINK OWNER COPY (INITIAL): GOLD