IREDELL COUNTY HEALTH DEPARTMENT

AUTHORIZATION TO CONSTRUCT

STATESVILLE 704-878-5305 MOORESVILLE 704-664-5281

IMPROVEMENT PERMIT / ~~CERTIFICATE OF COMPLETION~~ / OPERATION PERMIT / EXISTING SYSTEM INSPECTION

PROPERTY DESCRIPTION NO. 24832 DATE 11/26/96 TAX MAP NO. 2C-A-3 pt of 4625578 2749 Watershed: ☑ Yes ☐ No

OWNER OR CONTRACTOR JOHN WIELAND HOMES PHONE: Business 663-6905 - T. SAMOS Home

ADDRESS 8325 ARROW RIDGE BLVD. CHARLOTTE

LOCATION BRAWLEY SCHOOL - TR BAY HARBOR - TL LAKE MIST - TL SEA BREEZE - 6TH LOT IN LEFT

SUBDIVISION HARBOR BLOCK / SECTION II LOT 22 LOT AREA 35921 ft² SITE CLASS. PS DESIGN FLOW 450 GPD L.T.A.R. .3 GPD/FT²

Septic Tank: 1000 Gallons; STB 994 Date 4/15/98

Pump Tank: 1000 Gallons; PT 417 Date 2/16/98

Pump Make: HYDROMATIC Model SHEFSOR1 Serial No. 6198

Nitrification Field: No Fields 1 Square Feet 900 Linear Feet 300

No Lines 6@50' Trench Width 24" Max Trench Bottom Depth 36" Gravel Depth N/A

☑ New System ☐ Repair System Type: I, II, III, (IV) V, VI

System Description: PRESSURE PANEL

Repair System Description: SAME

Maintenance Agreement Required: ☑ Yes ☐ No

☑ House/Mod. Home No. Bedrooms 4

☐ Mobile Home No. Bathrooms 4

☐ Business No. Employees

☐ Other

☐ Slab ☐ Crawl Space ☑ Basement w/plumbing ☐ Basement wo/plumbing


Water Supply: ☐ Individual ☑ Community ☐ Public

Comments: INDIVIDUAL PRESSURED LINES.
DO NOT CUT REPAIR AREA WITH SUPPLY LINE.


Comments: LA - 8.25" Drawdown = 145 GAL/DOSE

INITIAL SITE SKETCH

1" = 40'

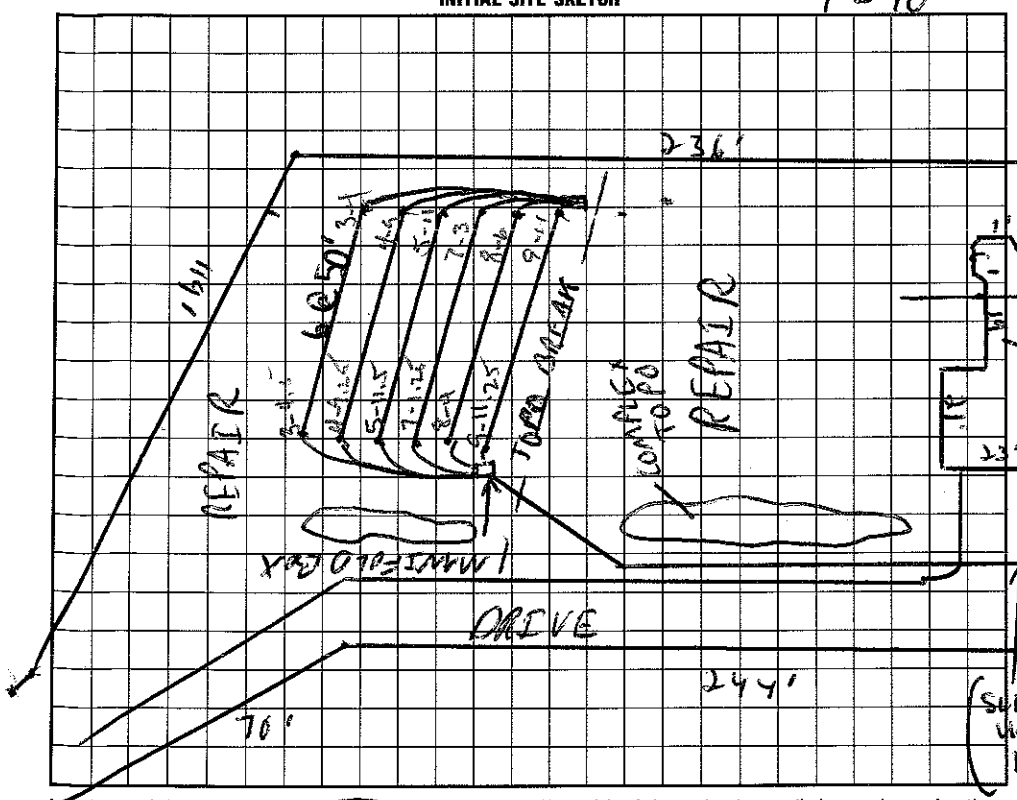

AS BUILT SKETCH

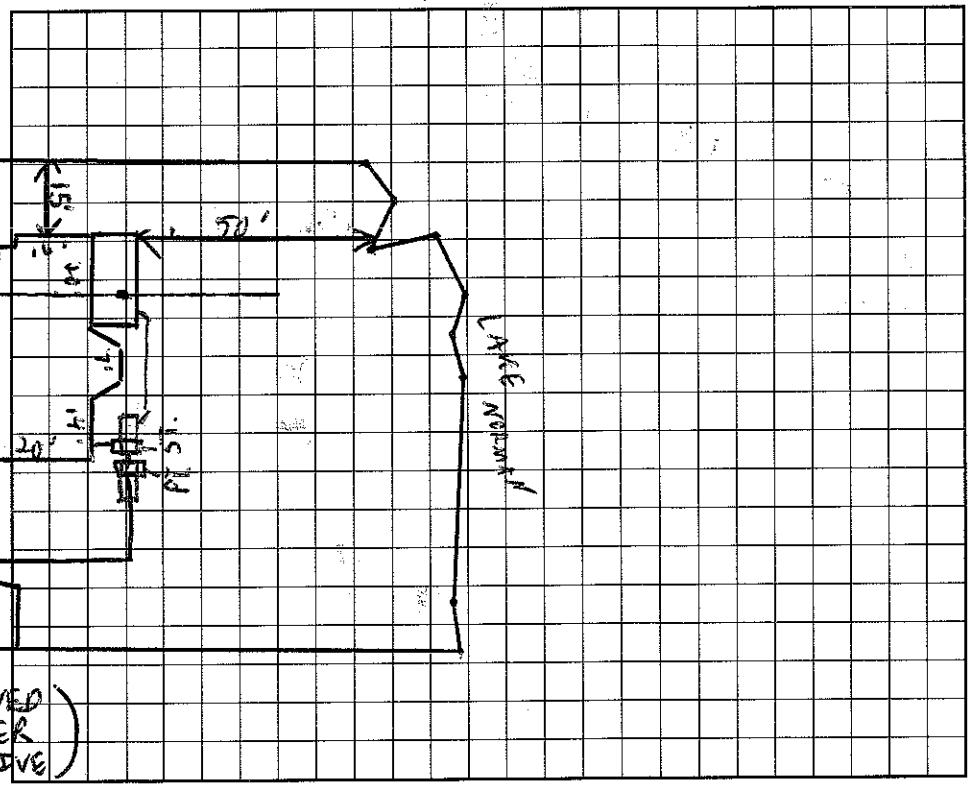

I understand that this permit can be suspended or revoked if any false information is supplied toward securing the permit/any unauthorized changes are made to the site/any unauthorized changes are made in the installation of the system.

Signed: [signature] (agent)

Improvement Permit by: C. Bryson EHS date 11/26/96

AUTHORIZATION TO CONSTRUCT Existing System Inspection by: C. Bryson EHS date 11/26/96

Installed by: Norlock

Certificate of Completion by: _____ date _____

Operation Permit by: C. Bryson date 8/25/98

HEALTH DEPT. COPY: WHITE INSPECTION COPY (FINAL): GREEN OWNER COPY (FINAL): YELLOW INSPECTION COPY (INITIAL): PINK OWNER COPY (INITIAL): GOLD