IREDELL COUNTY HEALTH DEPARTMENT

STATESVILLE 704-878-5305 MOORESVILLE 704-664-5281

IMPROVEMENT PERMIT / CERTIFICATE OF COMPLETION / OPERATION PERMIT / EXISTING SYSTEM INSPECTION

PROPERTY DESCRIPTION NO. 21680 DATE August 28, '95 (JOHN WIELAND) TAX MAP NO. part of 2CA3 4625-57-8896 Watershed: ☑ Yes ☐ No

OWNER OR CONTRACTOR Crescent Resources clo PHONE: Business Home WS4

ADDRESS PO Box 1003, Charlotte

LOCATION Brawley Sch Rd. TR Bay Harbour TL Lake Mist TR Ivy Hollow Lane ~~Set Breeze~~ at end on left

SUBDIVISION Har Bour BLOCK / SECTION J II LOT 21 LOT AREA ≥ 20,000 ft² SITE CLASS. ~~E~~ Sprtfs DESIGN FLOW 480gpd L.T.A.R. .3

Septic Tank: 1000 Gallons; STB 794 Date 3/19/99

Pump Tank: 1000 Gallons; PT 27 Date 4/6/99

Pump Make: Hydromatic Model SHEF50A1 Serial No. 1/99

Nitrification Field: No Fields 1 Square Feet 1200 Linear Feet 400

No Lines 6@67' Trench Width 36" Max Trench Bottom Depth ≈ 36" Gravel Depth N/A

☑ New System ☐ Repair System Type: I, II, III, IV, V, VI

System Description: pumped/on demand/ Infiltrator

Repair System Description: LPP/PBPS

Maintenance Agreement Required: ☐ Yes ☑ No (initial sys)

☑ House/Mod. Home No. Bedrooms 4

☐ Mobile Home No. Bathrooms 4

☐ Business No. Employees

☐ Other

☐ Slab ☑ Crawl Space ☑ Basement w/plumbing ☐ Basement wo/plumbing


Water Supply:
☐ Individual
☑ Community
☐ Public

Comments: Authorization to construct ~~DEVELOPER~~ ~~PERMIT~~


Comments: partial

1"=50'

INITIAL SITE SKETCH

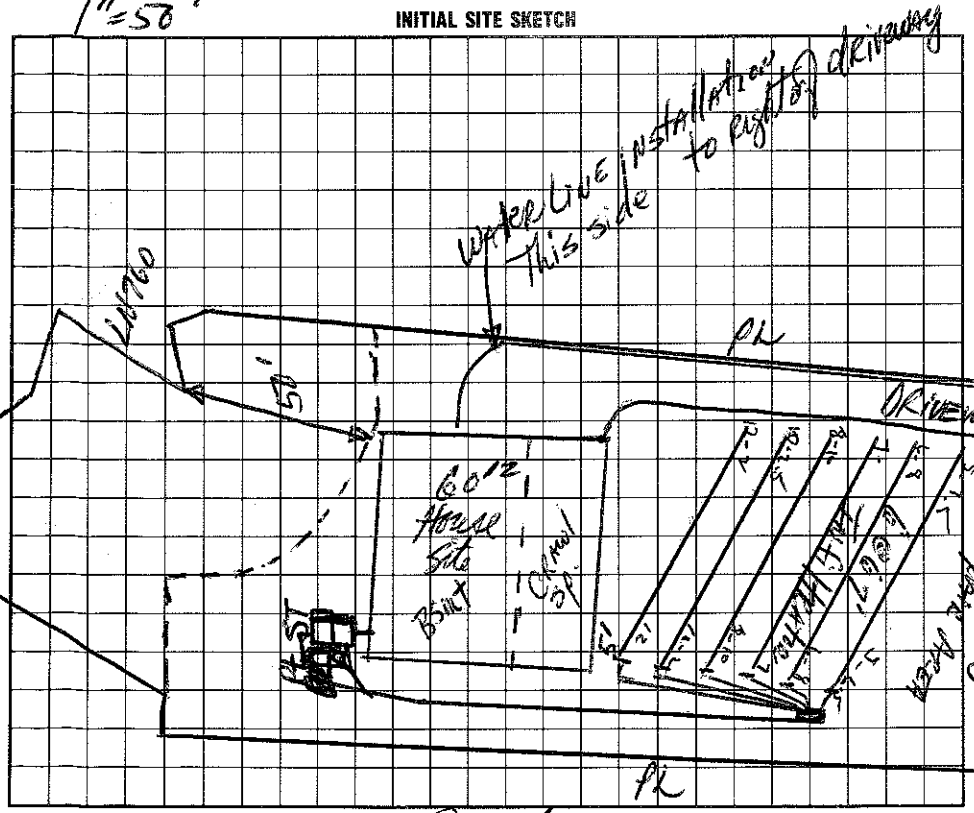

AS BUILT SKETCH

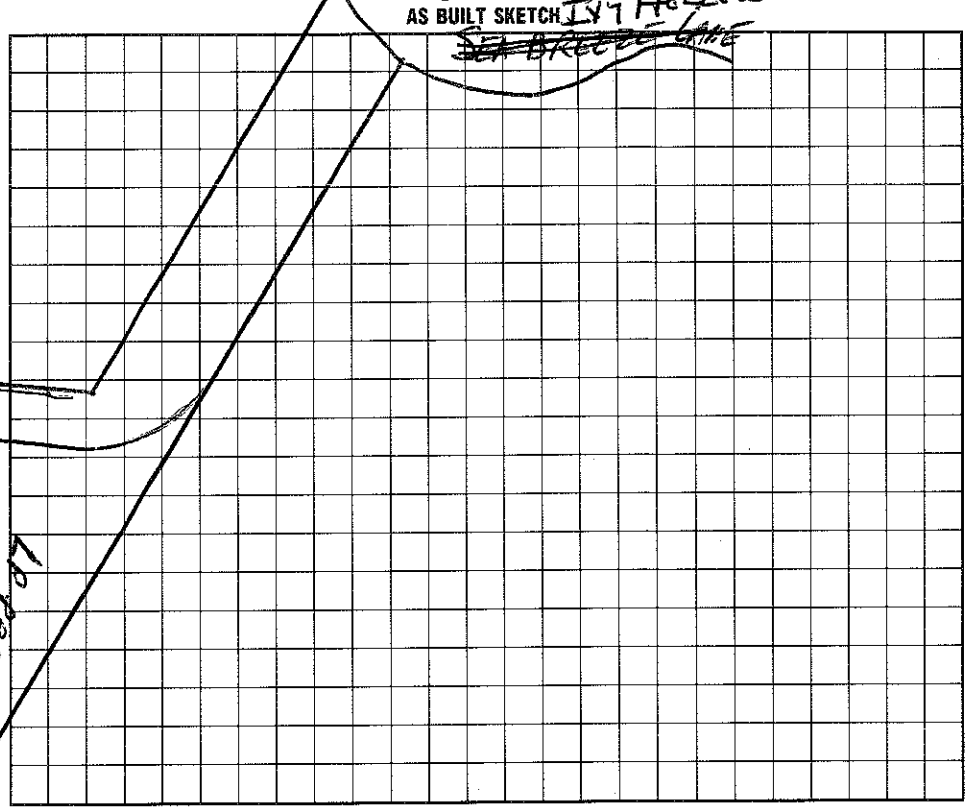

I understand that this permit can be suspended or revoked if any false information is supplied toward securing the permit/any unauthorized changes are made to the site/any unauthorized changes are made in the installation of the system.

Signed: [signature] Agent

Improvement Permit by: [signature] RS date 8/28/95

Authorization to Construct Existing System Inspection by: [signature] RS date 10/19/95

Installed by: MacLeod

Certificate of Completion by: Wesley Sparks RS. date 7/16/99

Operation Permit by: Wesley Sparks RS. date 7/16/99

HEALTH DEPT. COPY: WHITE INSPECTION COPY (FINAL): GREEN OWNER COPY (FINAL): YELLOW INSPECTION COPY (INITIAL): PINK OWNER COPY (INITIAL): GOLD