# IREDELL COUNTY HEALTH DEPARTMENT

STATESVILLE 704-878-5305 MOORESVILLE 704-664-5281

## IMPROVEMENT PERMIT / AUTHORIZATION TO CONSTRUCT / OPERATION PERMIT / EXISTING SYSTEM INSPECTION

PERMIT# 21679 PIN# ~~pt of 2643~~ 4625579926 DATE 3/3/98

OWNER OR CONTRACTOR C JOHN WIELAND PHONE: Business 663-6905- T JACOBS Home

ADDRESS

LOCATION BRAWLEY SCHOOL RD- TR BAY HARBOUR - TL LAKE NEST - TL ~~INDIAN~~ CHINOOK WAY - ON RT

SUBDIVISION HARBOUR BLOCK / SECTION II LOT 14 LOT AREA SITE CLASS. PS DESIGN FLOW 360 GPD L.T.A.R. .3 gpd/ft²

Septic Tank: 1000 Gallons; STB 794 Date 7/19/98

Pump Tank: 1000 Gallons; PT 27 Date 7/14/98

Pump Make: HYDROMATIC Model SHEF50A1 Serial No. 6-98

Nitrification Field: No Fields 1 Square Feet 533 Linear Feet 268

No Lines 6 @ 67' Trench Width 24" Max Trench Bottom Depth ~30" Gravel Depth N/A

☑ New System ☐ Repair System Type: I, II, III (IV) V, VI

System Description: PUMP PANEL

Repair System Description: SAME

Maintenance Agreement Required: ☐ Yes ☑ No

☑ House/Mod. Home No. Bedrooms 4

☐ Mobile Home No. Bathrooms 4

☐ Business No. Employees

☐ Other


☐ Slab ☐ Crawl Space ☑ Basement w/plumbing ☐ Basement wo/plumbing

Water Supply: ☐ Individual ☐ Public ☑ Community

Comments:/Conditions:

Comments:/Conditions:

**INITIAL SITE SKETCH** 1"=50'

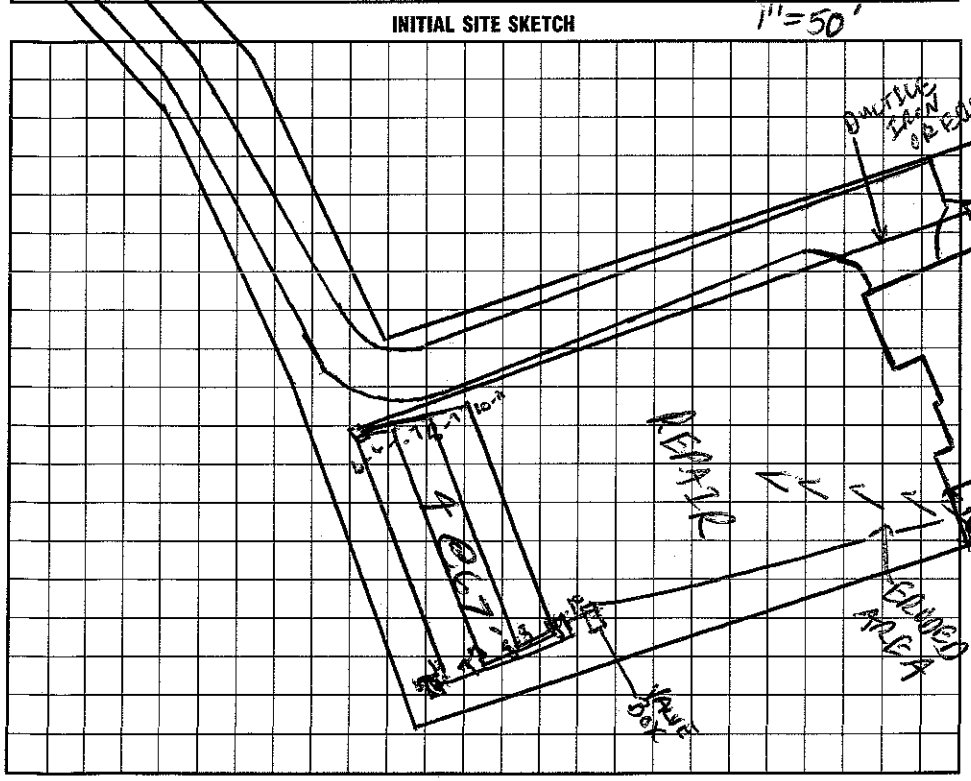


**AS BUILT SKETCH**

I understand that this permit can be suspended or revoked if any false information is supplied toward securing the permit/any unauthorized changes are made to the site/any unauthorized changes are made in the installation of the system. Improvement Permit with plat valid without expiration. Improvement Permit with site plan valid for sixty months. Authorization to Construct is valid for a period equal to that of Improvement Permit – not to exceed sixty months.

Signed: _____ date 3/6/98

Improvement Permit by: _____ RS date 3/3/98

Authorization to Construct by: _____ RS date 3/3/98

Installed by: Muhleod Const Co.

Operation Permit by: Wesley Sparks RS date 11/2/98

Existing System Inspection by: _____ date _____

HEALTH DEPT. COPY: WHITE INSPECTION COPY (FINAL): GREEN OWNER COPY (FINAL): YELLOW INSPECTION COPY (INITIAL): PINK OWNER COPY (INITIAL): GOLD