IREDELL COUNTY HEALTH DEPARTMENT

AUTHORIZATION TO CONSTRUCT

STATESVILLE 704-878-5305 MOORESVILLE 704-664-5281

IMPROVEMENT PERMIT / ~~CERTIFICATE OF COMPLETION~~ / OPERATION PERMIT / EXISTING SYSTEM INSPECTION

PROPERTY DESCRIPTION NO. 26370 DATE 3/25/97 TAX MAP NO. 4625941684 pt Watershed: ☑ Yes ☐ No

OWNER OR CONTRACTOR M.I. HOMES PHONE: Business 663-6905 - T JACOBS Home 4625 58 0044

ADDRESS 104 E MOREHEAD ST, CHARLOTTE NC

LOCATION BRAWLEY SCHOOL RD - TR BAY HARBOUR - TL LAKE MIST - TR HUNTER SPRING LANE (2ND ON R)

SUBDIVISION HARBOUR BLOCK / SECTION II LOT 40 LOT AREA 1.5AC SITE CLASS. PS DESIGN FLOW 480GPD L.T.A.R. 300GPD/FT²

Septic Tank: 1000 Gallons; STB 799 Date 4/28/97

Pump Tank: 1000 Gallons; PT Date

Pump Make: HYDROMATIC Model SK50A1 Serial No.

Nitrification Field: No Fields 1 Square Feet 1200 Linear Feet 400

No Lines ~~4 @ 50'~~ 3 Trench Width 36" Max Trench Bottom Depth 36"

☑ New System ☐ Repair System Type: I, II, (III), IV, V, VI

System Description: PUMP CHAMBERED OR SIMILAR

Repair System Description: PUMP PANEL

Maintenance Agreement Required: ☐ Yes ☑ No

~~Gravel Depth~~ SAND

☑ House/Mod. Home ☐ Mobile Home ☐ Business ☐ Other

No. Bedrooms 4 No. Bathrooms 3.5 No. Employees


☐ Slab ☑ Crawl Space ☐ Basement w/plumbing ☐ Basement wo/plumbing

Water Supply: ☐ Individual ☑ Community ☐ Public


Comments: SYSTEM IS PUMPED UNLESS OTHERWISE SHOWN A GRAVITY SYSTEM MAY BE INSTALLED AND STILL MAINTAIN MAX TRENCH BOTTOM DEPTH OF 36".

Comments: Installed w/ 2 Pressure - Upper → 2 Laterals Rope, 24" Pipe, Box above grade Lower → 3 Laterals

INITIAL SITE SKETCH 1"=30'

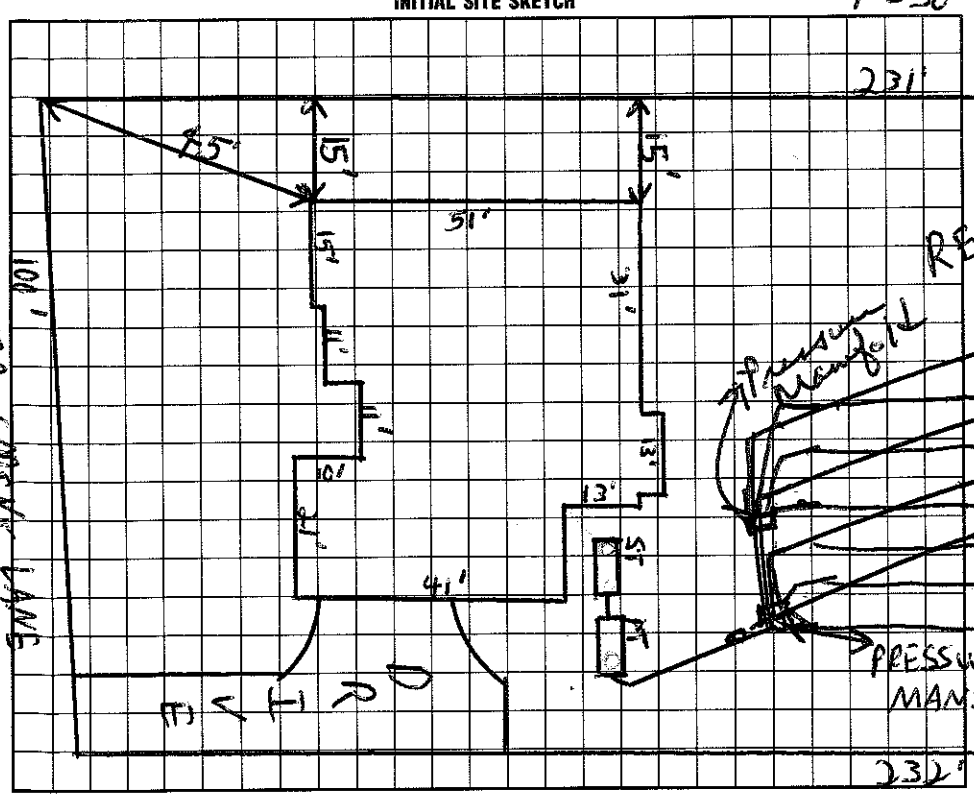

AS BUILT SKETCH

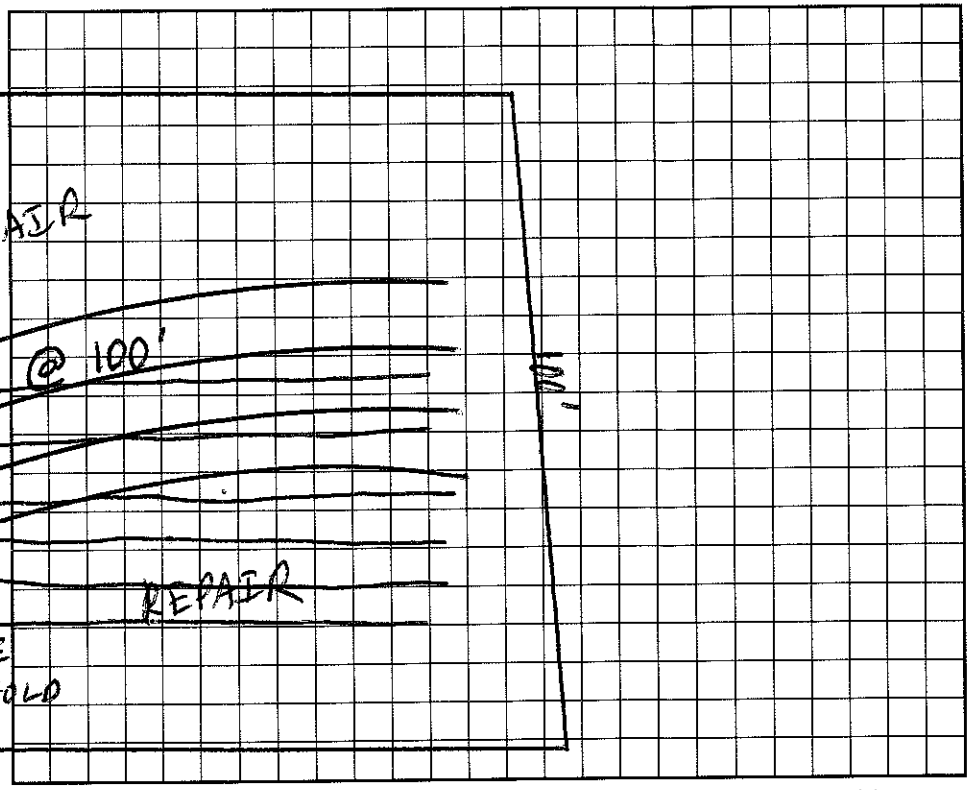

I understand that this permit can be suspended or revoked if any false information is supplied toward securing the permit/any unauthorized changes are made to the site/any unauthorized changes are made in the installation of the system. Improvement Permit is valid for 60 months from date of issuance.

Signed: Torrey C Jacobs CPSS 3-26-97

Improvement Permit by: C. Robert Freeman EHSI date 3/25/97

AUTHORIZATION TO ~~Existing System Inspection~~ by: C. Robert Freeman EHSI date 3/25/97

Installed by: Macleod Const. Co.

Certificate of Completion by: Wesley Sparks R.S. date 8/13/97

Operation Permit by: Wesley Sparks R.S. date 8/13/97

HEALTH DEPT. COPY: WHITE INSPECTION COPY (FINAL): GREEN OWNER COPY (FINAL): YELLOW INSPECTION COPY (INITIAL): PINK OWNER COPY (INITIAL): GOLD