IREDELL COUNTY HEALTH DEPARTMENT

STATESVILLE 704-878-5305 MOORESVILLE 704-664-5281

IMPROVEMENT PERMIT / ~~CERTIFICATE OF COMPLETION~~ / OPERATION PERMIT / EXISTING SYSTEM INSPECTION

AUTHORIZATION TO CONSTRUCT

PROPERTY DESCRIPTION NO. 19006 DATE 3/4/97 TAX MAP NO. 2FC5 pt of Watershed: ☐ Yes ☐ No

OWNER OR CONTRACTOR MI HOMES PHONE: Business 663-6905 T. JACOBS ~~Home~~ 4625-58-0353

ADDRESS PO Box 1003, CHARLOTTE

LOCATION BEAMEY School - TL LAKE MIST - TR SUNSHINE - ON RT

SUBDIVISION HARBOUR BLOCK / SECTION 2 LOT 46 LOT AREA 25,000 Ft± SITE CLASS. PS DESIGN FLOW 480 GPD L.T.A.R. .3 GPD/FT

Septic Tank: 1000 Gallons; STB 794 Date 6/16/97 ✗

Pump Tank: ____ Gallons; PT ____ Date ____

Pump Make: ____ Model ____ Serial No. ____

Nitrification Field: No Fields 1 Square Feet 1200 Linear Feet 400

No Lines 4 Trench Width 36" Max Trench Bottom Depth 36" Gravel Depth N/A

☑ New System ☐ Repair System Type: I, II, III, IV, V, VI

System Description: GRAVITY CHANNELED

Repair System Description: Off Site LPP BPS

Maintenance Agreement Required: ☐ Yes ☑ No

☑ House/Mod. Home No. Bedrooms 4

☐ Mobile Home No. Bathrooms 3

☐ Business No. Employees ____

☐ Other ____


☐ Slab ☑ Crawl Space ☐ Basement w/plumbing ☐ Basement wo/plumbing

Water Supply: ☐ Individual ☑ Community ☐ Public


Comments:

Comments: Poly Lok not used - S/T location changed due to location of plumbing stub-out. - RWS

INITIAL SITE SKETCH

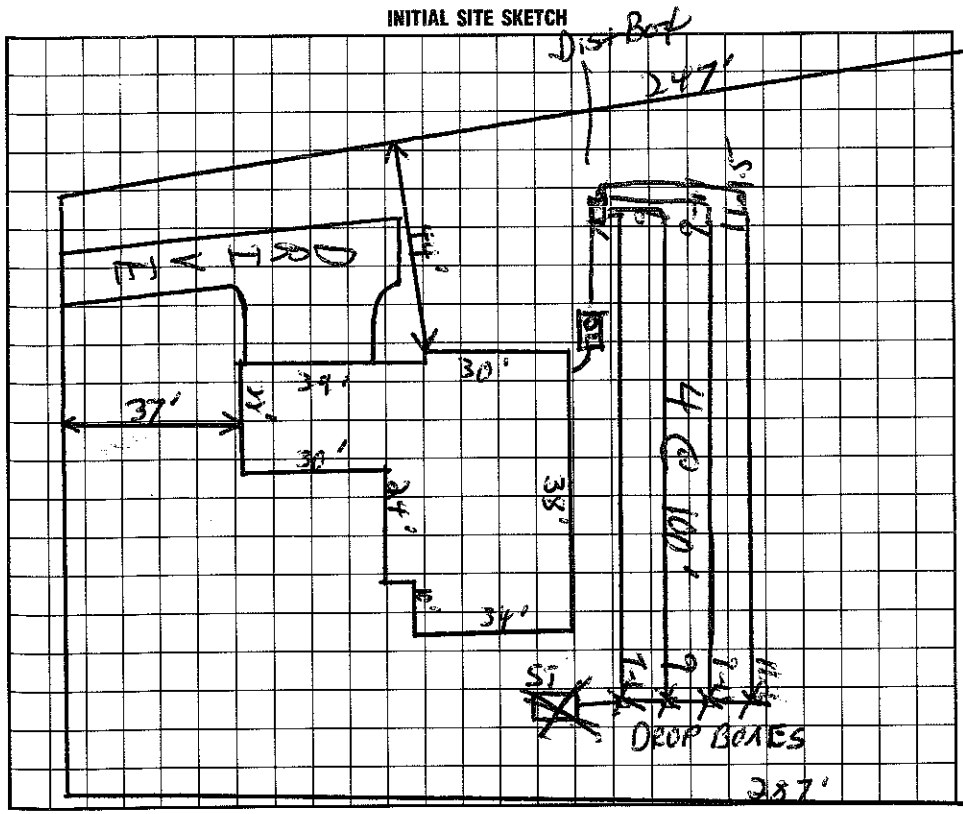

AS BUILT SKETCH

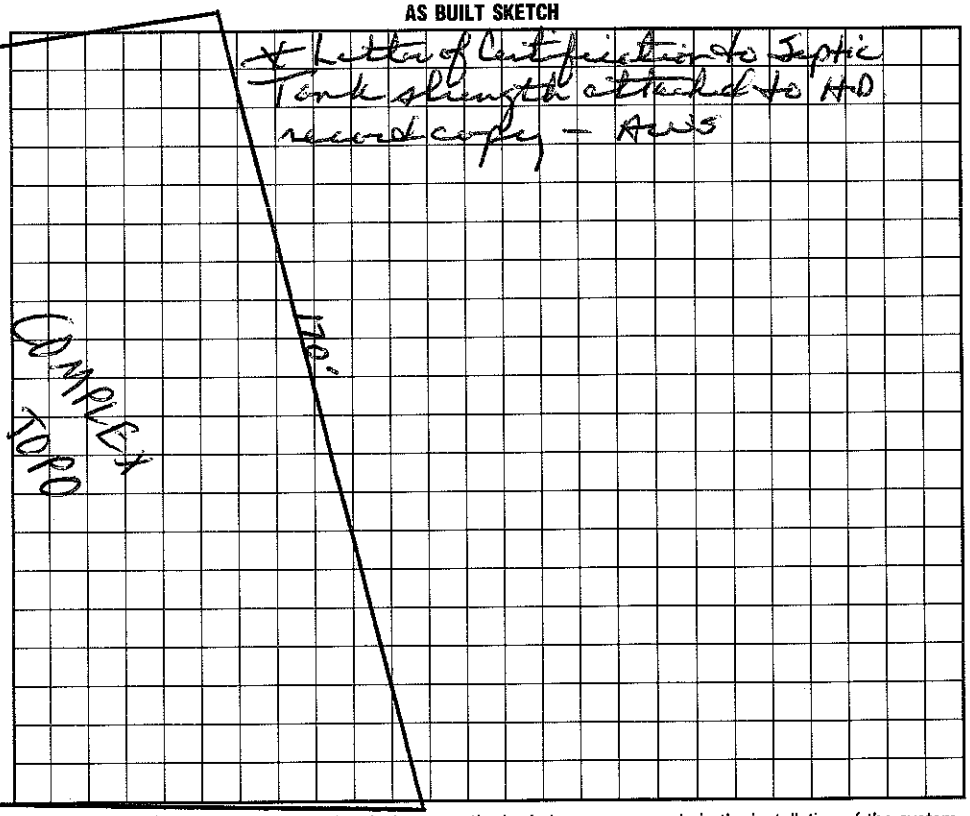

I understand that this permit can be suspended or revoked if any false information is supplied toward securing the permit/any unauthorized changes are made to the site/any unauthorized changes are made in the installation of the system. Improvement ~~Permit~~ is valid ~~for 60~~ months from date of issuance.

Signed: ____

Improvement Permit by: C. Ray Kerr DAVID HINSON date 4/10/95

Existing System Inspection by: C. Ray Kerr date 3/4/97

Installed by: R L MacLeod

Certificate of Completion by: Wesley Sparks RS date 6/30/97

Operation Permit by: Wesley Sparks RS date 6/30/97

HEALTH DEPT. COPY: WHITE INSPECTION COPY (FINAL): GREEN OWNER COPY (FINAL): YELLOW INSPECTION COPY (INITIAL): PINK OWNER COPY (INITIAL): GOLD