IREDELL COUNTY HEALTH DEPARTMENT

Construction

STATESVILLE 704-878-5305 MOORESVILLE 704-664-5281

IMPROVEMENT PERMIT / ~~CERTIFICATE OF COMPLETION~~ / OPERATION PERMIT / EXISTING SYSTEM INSPECTION

PROPERTY DESCRIPTION NO. 18997 DATE 10/8/96 TAX MAP NO. 2C A 3 Pt of Watershed: X Yes ☐ No

OWNER OR CONTRACTOR MI Homes PHONE: Business 572-6514 Home 4625 58 0820

ADDRESS 1043 E Morehead St. #105

LOCATION Sunrise Circle - Brunswick TR Bay Harbour TL Lake Mist TR Sunrise Circle TL Sunrise on (L)

SUBDIVISION Harbour BLOCK / SECTION 1 LOT 32 LOT AREA ~ 25,000 FT² SITE CLASS. PS DESIGN FLOW 480 L.T.A.R. .25

Septic Tank: 1000 Gallons; STB 794 Date 11/21/96

Pump Tank: 1000 Gallons; PT 29 Date 11/22/96

Pump Make: Liberty Model LE-71A2 Serial No.

Nitrification Field: No Fields 1 Square Feet 1920 Linear Feet ±350

No Lines 5 Trench Width 24" Max Trench Bottom Depth 36" Gravel Depth SAND

X New System ☐ Repair System Type: I, II, (III), IV, V, VI

System Description: Pressure Manifold - 4" PVC

Repair System Description: Same

Maintenance Agreement Required: ☐ Yes X No

X House/Mod. Home ☐ Mobile Home ☐ Business ☐ Other

No. Bedrooms 4 No. Bathrooms 4 No. Employees


☐ Slab X Crawl Space ☐ Basement w/plumbing ☐ Basement wo/plumbing

Water Supply: ☐ Individual X Community ☐ Public


Comments: H2O lines and power lines along left side of driveway.

Comments:

INITIAL SITE SKETCH

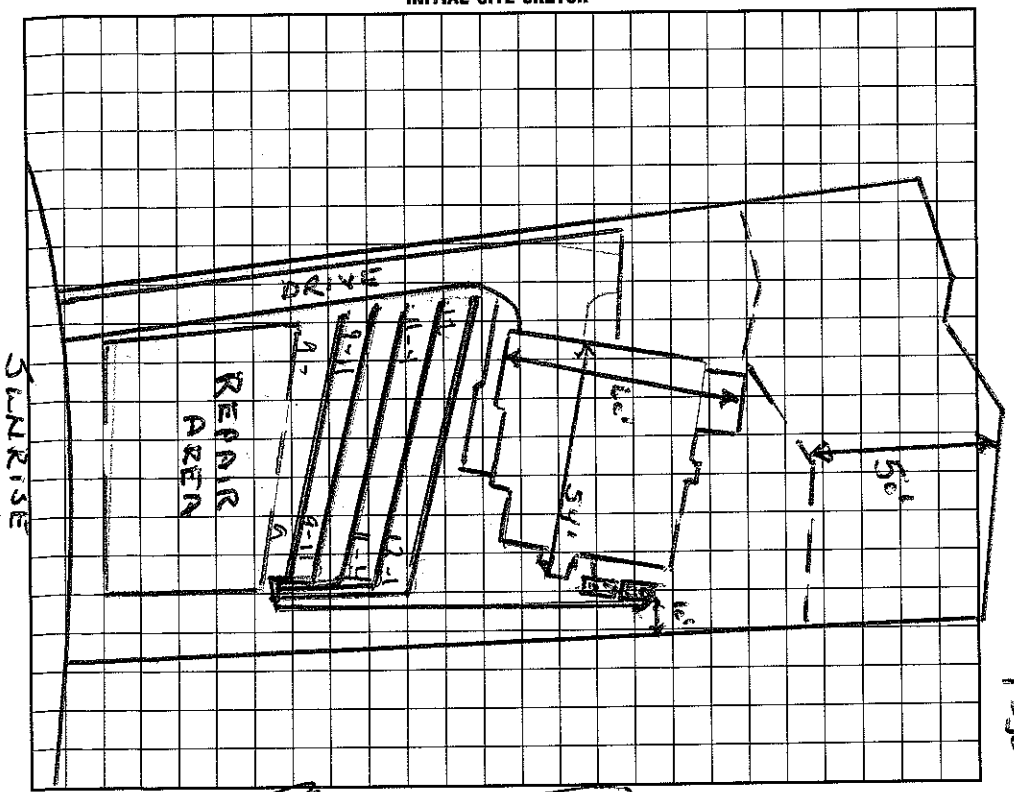

AS BUILT SKETCH

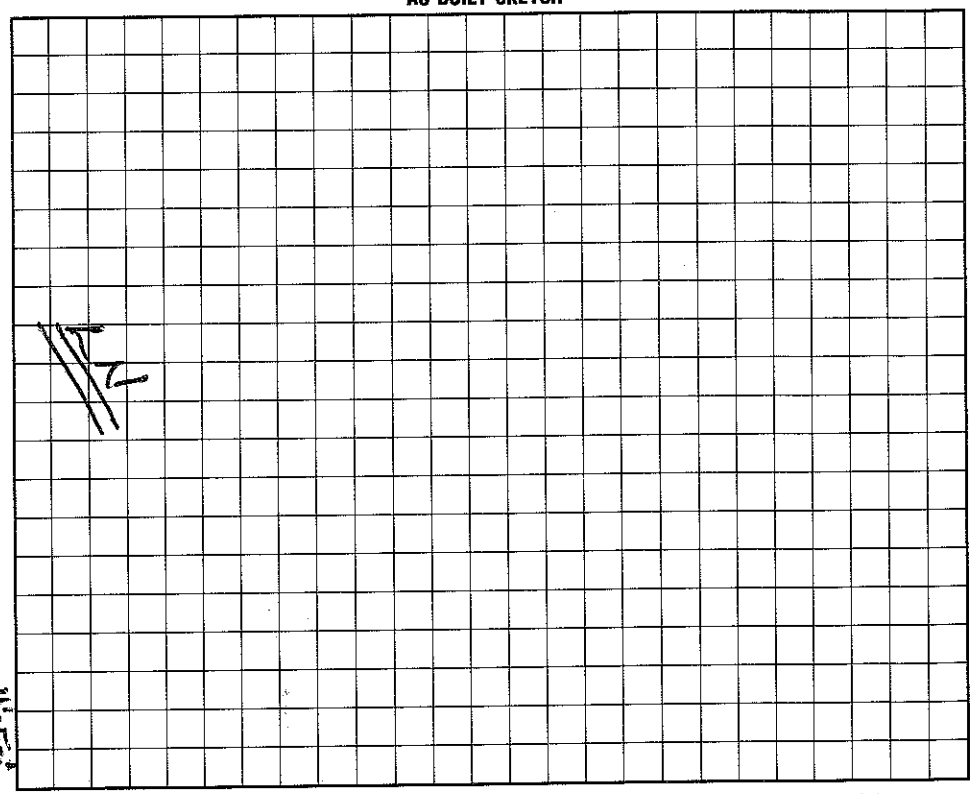

I understand that this permit can be suspended or revoked if any false information is supplied toward securing the permit/any unauthorized changes are made to the site/any unauthorized changes are made in the installation of the system.

Signed: X

Improvement Permit by: Wesley Sparks R.S. date 10/8/96

Existing System Inspection by: Wesley Sparks R.S. date 10/8/96

Installed by: MacLeod Const.

Certificate of Completion by: date

Operation Permit by: Wesley Sparks R.S. date 3/13/97

HEALTH DEPT. COPY: WHITE INSPECTION COPY (FINAL): GREEN OWNER COPY (FINAL): YELLOW INSPECTION COPY (INITIAL): PINK OWNER COPY (INITIAL): GOLD