IREDELL COUNTY HEALTH DEPARTMENT

AUTHORIZATION TO CONSTRUCT

STATESVILLE 704-878-5305 MOORESVILLE 704-664-5281

IMPROVEMENT PERMIT / ~~CERTIFICATE OF COMPLETION~~ / OPERATION PERMIT / EXISTING SYSTEM INSPECTION

4183-3570

PROPERTY DESCRIPTION NO. 25423 DATE 11/25/96 TAX MAP NO. 2F-12-A-41 4625 58 1030 Watershed: ☑ Yes ☐ No

OWNER OR CONTRACTOR MI HOMES PHONE: Business 376-4500 Home

ADDRESS 1043 E MOREHEAD ST. CHARLOTTE 28204

LOCATION BRAWLEY SCHOOL - TR BAY HARBOUR - TL LAKE MIST - TL HUNTER SPRINT - 2ND ON RT

SUBDIVISION HARBOUR BLOCK / SECTION II LOT 41 LOT AREA SITE CLASS. PS DESIGN FLOW 450 GPD L.T.A.R. .36 PD /FT²

Septic Tank: 1000 Gallons; STB 794 Date 3/6/97

Pump Tank: 1000 Gallons; PT 27 Date 3/21/97

Pump Make: HYDROMATIC Model 5K50M1 Serial No. 51454-0007

Nitrification Field: No Fields 1 Square Feet 1200 Linear Feet 400

No Lines 4 Trench Width 36" Max Trench Bottom Depth 36" Gravel Depth N/A

☑ New System ☐ Repair System Type: I, II, III, IV, V, VI

System Description: PUMP CHAMBER OR SIMILAR TYPE

Repair System Description: PUMP PANEL

Maintenance Agreement Required: ☐ Yes ☑ No

☑ House/Mod. Home ☐ Mobile Home ☐ Business ☐ Other

No. Bedrooms 4 No. Bathrooms 4 No. Employees

☐ Slab ☑ Crawl Space ☐ Basement w/plumbing ☐ Basement wo/plumbing


Water Supply: ☐ Individual ☑ Community ☐ Public

Comments:


Proposed Deck w/ Roof

Comments: Hand wire electrical + alarm
Run Pump set pressure on Manifold
7/16/97 No water in pump tank

INITIAL SITE SKETCH

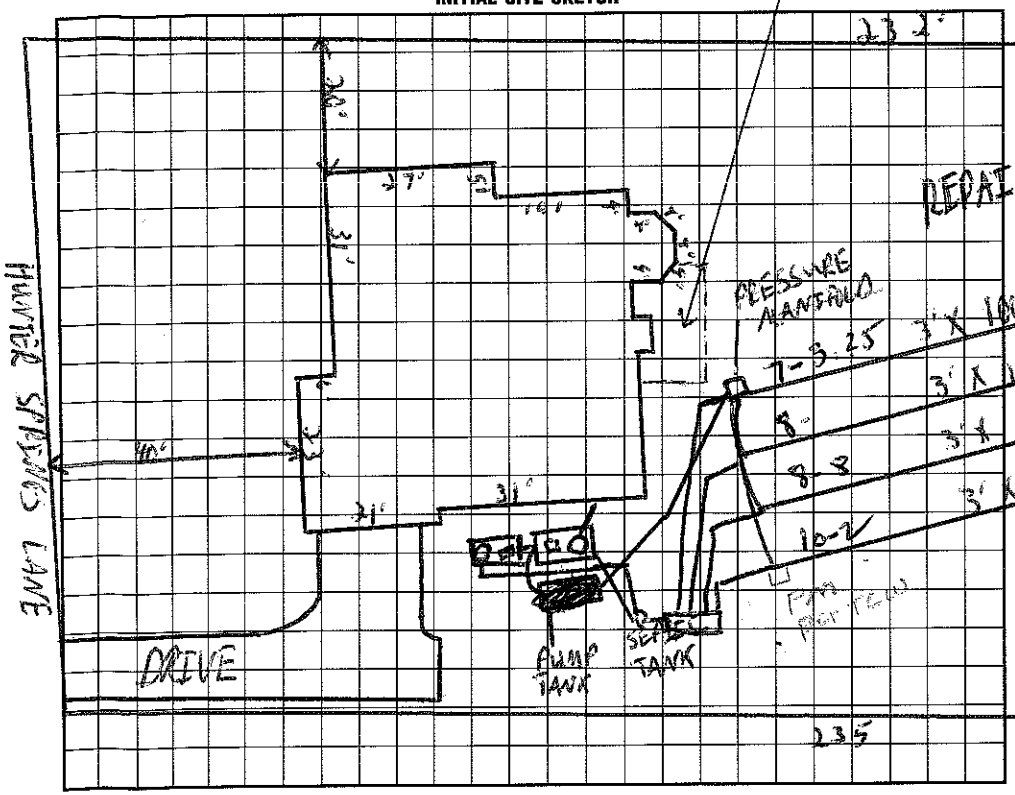

AS BUILT SKETCH

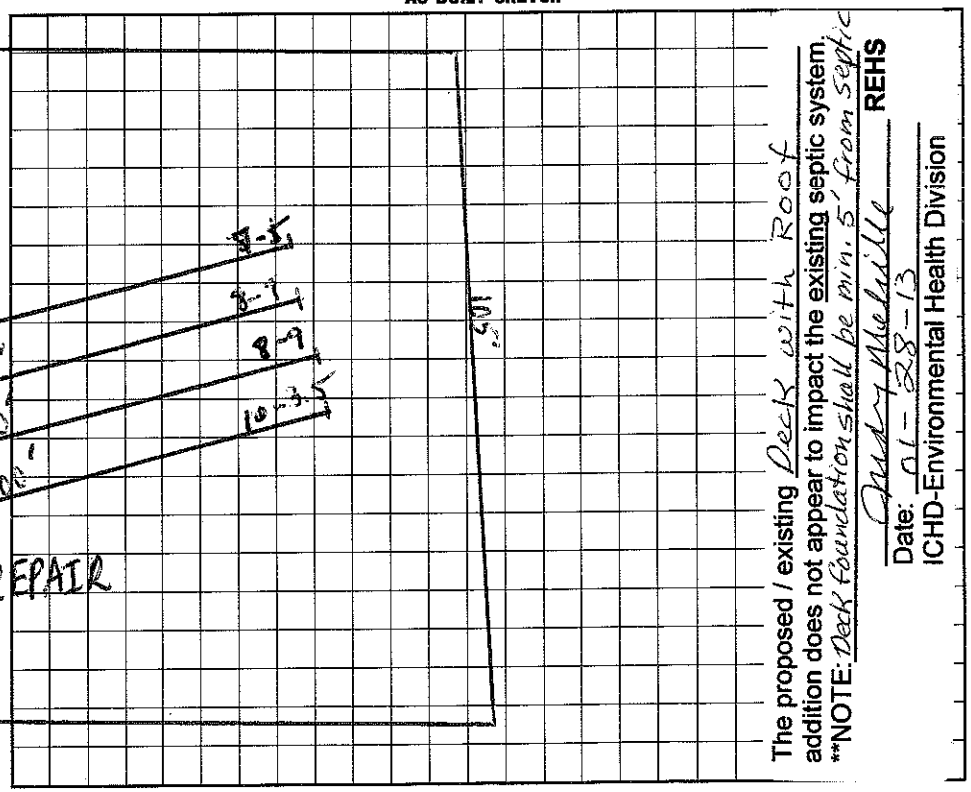

The proposed / existing Deck with Roof addition does not appear to impact the existing septic system.
**NOTE: Deck foundation shall be min. 5' from septic

Date: 01-28-13 REHS
ICHD-Environmental Health Division

I understand ~~that this~~ permit can be ~~suspended~~ or revoked if any false information is supplied toward securing the permit/any unauthorized changes are made to the site/any unauthorized changes are made in the installation of the system.

Signed: [signature] (agent)

Improvement Permit by: C. Ray Lam EHST date 11/25/96

~~Existing System Inspection~~ AUTHORIZATION TO CONSTRUCT by: C. Ray Lam EHST date 11/25/96

Installed by: R L MacLeod

Certificate of Completion by: Wesley Sparks RS. date 8/15/97

Operation Permit by: Wesley Sparks RS. date 8/15/97

HEALTH DEPT. COPY: WHITE INSPECTION COPY (FINAL): GREEN OWNER COPY (FINAL): YELLOW INSPECTION COPY (INITIAL): PINK OWNER COPY (INITIAL): GOLD