# IREDELL COUNTY HEALTH DEPARTMENT / Authorization to Construct

STATESVILLE 704-878-5305 MOORESVILLE 704-664-5281

## IMPROVEMENT PERMIT / ~~CERTIFICATE OF COMPLETION~~ / OPERATION PERMIT / EXISTING SYSTEM INSPECTION

PROPERTY DESCRIPTION NO. 2689 DATE 5/9/97 TAX MAP NO. ~~2F 12A 49~~ 4625581960 Watershed: [X] Yes [ ] No

OWNER OR CONTRACTOR MI Homes PHONE: Business 376-9800 Home WS4

ADDRESS 1043 E. Morehead St. Charlotte, NC. 28204

LOCATION Brawley Sch TR Bay Harbour TL Lake Mist TR Cypress Cove, straight off cul de sac

SUBDIVISION Harbour BLOCK / SECTION II LOT 47 LOT AREA 36,000SF SITE CLASS. PS DESIGN FLOW 480 L.T.A.R. .3

Septic Tank: 1000 Gallons; STB 794 Date 12/31/96
Pump Tank: 1000 Gallons; PT 27 Date 2/19/97
Pump Make: HYDROMATIC Model SKHD 150 M2 Serial No. 5175E-014-T
Nitrification Field: No Fields 1 Square Feet ~~534~~ Linear Feet 267*
No Lines 4 Trench Width 24" Max Trench Bottom Depth 30" Gravel Depth SAND

[X] New System [ ] Repair System Type: I, II, III, [IV], V, VI
System Description: Pres-ized PBS
Repair System Description: SAME
Maintenance Agreement Required: [ ] Yes [ ] No

[X] House/Mod. Home No. Bedrooms 4
[ ] Mobile Home No. Bathrooms 4
[ ] Business No. Employees
[ ] Other


[ ] Slab [X] Crawl Space [ ] Basement w/plumbing [ ] Basement wo/plumbing

Water Supply: [ ] Individual [X] Community [ ] Public


Comments:

Comments:

**INITIAL SITE SKETCH**

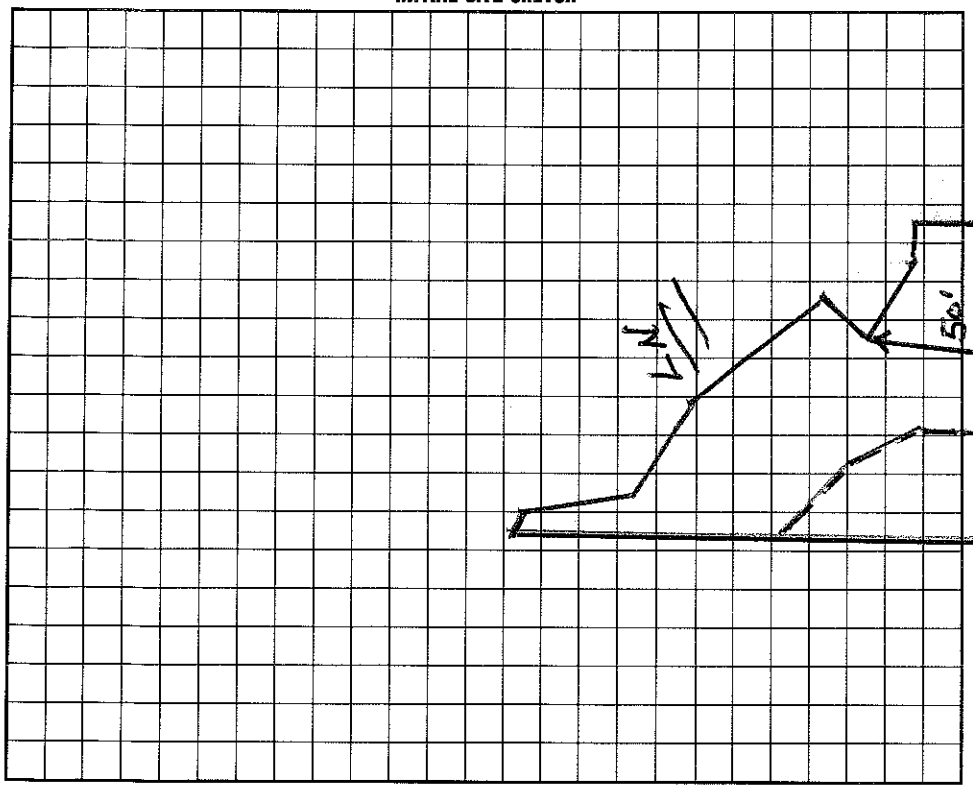


**AS BUILT SKETCH**

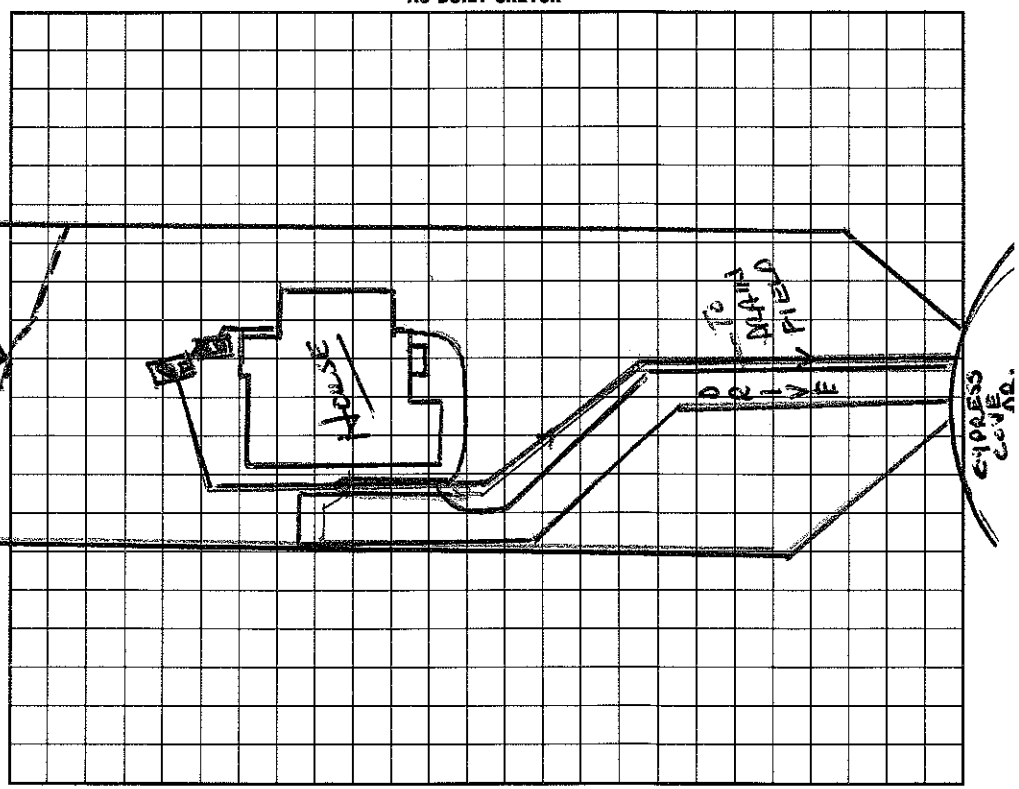


I understand that this permit can be suspended or revoked if any false information is supplied toward securing the permit/any unauthorized changes are made to the site/any unauthorized changes are made in the installation of the system. Improvement Permit is valid for 60 months from date of issuance.

Signed: _____

Improvement Permit by: _____ date _____

Existing System Inspection by: _____ date _____

Installed by: MacLeod Const. Co.

Certificate of Completion by: Wesley Sparks R.S. date 5/9/97

Operation Permit by: Wesley Sparks R.S. date 5/9/97

HEALTH DEPT. COPY: WHITE INSPECTION COPY (FINAL): GREEN OWNER COPY (FINAL): YELLOW INSPECTION COPY (INITIAL): PINK OWNER COPY (INITIAL): GOLD