IREDELL COUNTY HEALTH DEPARTMENT

AUTHORIZATION TO CONSTRUCT

STATESVILLE 704-878-5305 MOORESVILLE 704-664-5281

IMPROVEMENT PERMIT / ~~CERTIFICATE OF COMPLETION~~ / OPERATION PERMIT / EXISTING SYSTEM INSPECTION

PROPERTY DESCRIPTION NO. 18996 DATE 3/5/97 TAX MAP NO. pt of 2CA3 Watershed: ☐ Yes ☐ No

OWNER OR CONTRACTOR MI HOMES PHONE: Business 663-6405 - T. JACOBS Home

ADDRESS CR CLT - PO Box 1003 CHARLOTTE

LOCATION BRAMLEY SCHOOL - TL LAKE MESS - TR SUNRISE CIRCLE

SUBDIVISION HARBOUR BLOCK / SECTION MAP D LOT 31 LOT AREA 24,000 FT² SITE CLASS. RS DESIGN FLOW 460 GPD L.T.A.R. .3 GPD/FT²

Septic Tank: 1000 Gallons; STB 794 Date 5/22/97

Pump Tank: Gallons; PT Date

Pump Make: Model Serial No.

Nitrification Field: No Fields 1 Square Feet 900 Linear Feet 300

No Lines 5@38' Trench Width 24" Max Trench Bottom Depth 30" Gravel Depth N/A

☑ New System ☐ Repair System Type: I, II, III, IV, V, VI

System Description: GRAVITY PANEL

Repair System Description: OFF SITE PUMP PANEL

Maintenance Agreement Required: ☐ Yes ☑ No

☑ House/Mod. Home ☐ Mobile Home ☐ Business ☐ Other

No. Bedrooms 4 No. Bathrooms 4 No. Employees


☐ Slab ☐ Crawl Space ☑ Basement w/plumbing ☑ Basement wo/plumbing

Water Supply: ☐ Individual ☑ Community ☐ Public


Comments:

Comments:

INITIAL SITE SKETCH

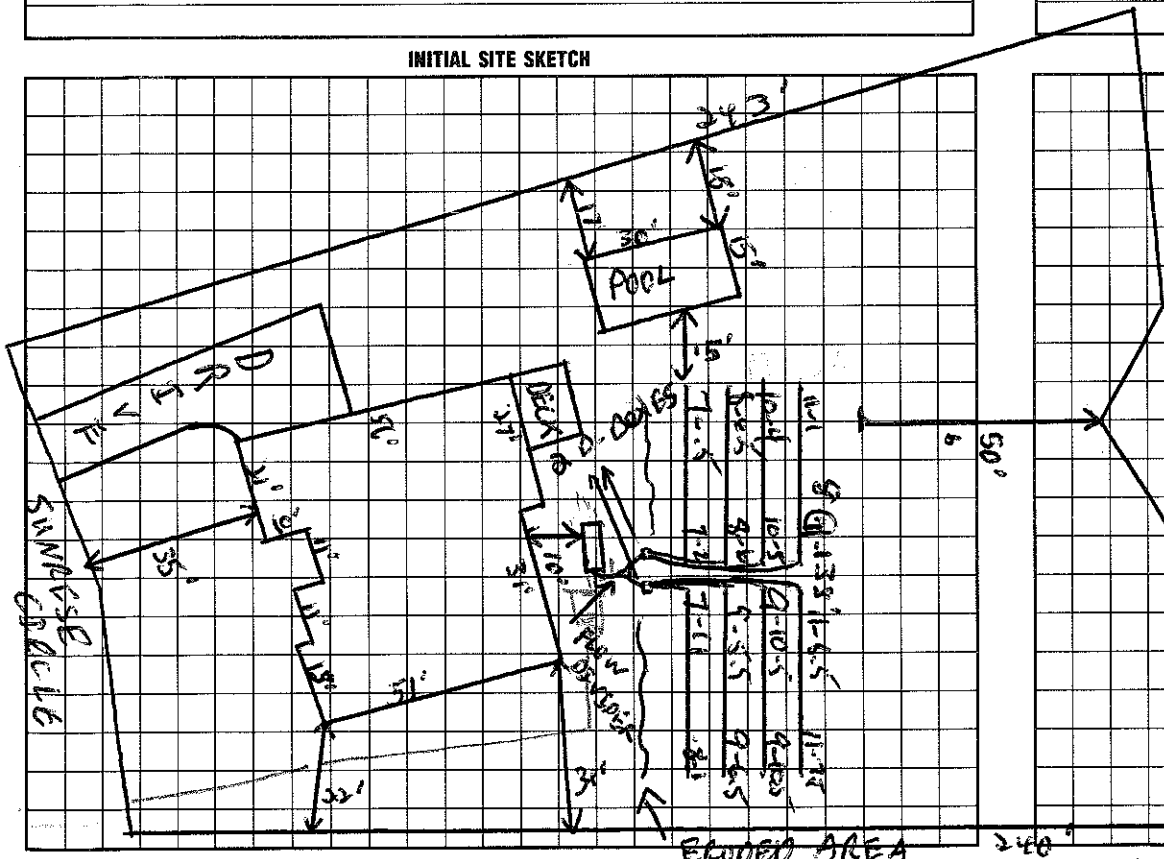

AS BUILT SKETCH

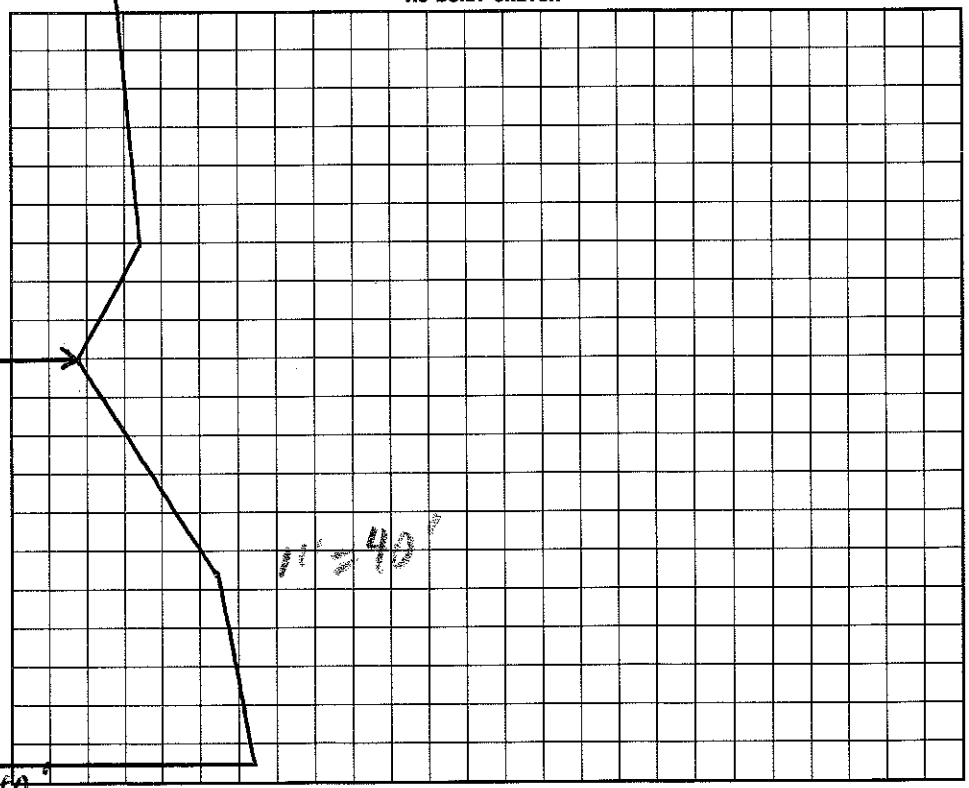

I understand that this permit can be suspended or revoked if any false information is supplied toward securing the permit/any unauthorized changes are made to the site/any unauthorized changes are made in the installation of the system. Improvement Permit is valid for ~~60~~ months from date of issuance.

Signed:

Improvement Permit by: C. Bly Thomas EHSP date 3/5/97

~~Authorization to Construct~~ Existing System Inspection by: C. Bly Thomas EHSP date 3/5/97

Installed by: Macheod

Certificate of Completion by: Wesley Sparks RS. date 8/12/97

Operation Permit by: Wesley Sparks RS. date 8/12/97

HEALTH DEPT. COPY: WHITE INSPECTION COPY (FINAL): GREEN OWNER COPY (FINAL): YELLOW INSPECTION COPY (INITIAL): PINK OWNER COPY (INITIAL): GOLD