IREDELL COUNTY HEALTH DEPARTMENT

STATESVILLE 704-878-5305 MOORESVILLE 704-664-5281

IMPROVEMENT PERMIT / CERTIFICATE OF COMPLETION / OPERATION PERMIT / EXISTING SYSTEM INSPECTION

PROPERTY DESCRIPTION NO. 21690 DATE Nov. 2, '95 TAX MAP NO. part of 2CA3 4625 58 2447 Watershed: ☑ Yes ☐ No

OWNER OR CONTRACTOR ~~Liscomb Properties Inc~~ MI HOMES PHONE: Business _____ Home _____ WS4CA

ADDRESS P.O Box 1003, Charlotte

LOCATION Brawley Sch Rd. TR Bay Harbour TL Lake Mist TR Cypress Cove Lane

SUBDIVISION The Harbour BLOCK / SECTION F LOT 48, 48A LOT AREA > 20,000 ft² SITE CLASS ~~PSpt.195~~ DESIGN FLOW ~~480~~ gpd L.T.A.R. .3

Septic Tank: 1000 Gallons; STB 794 Date 9/27/95

Pump Tank: 1000 Gallons; PT 27 Date 9/3/98

Pump Make: ~~HYDROMATIC~~ Model SKHD 150M2 Serial No. 6-98

Nitrification Field: No. Fields 1 Square Feet 1200 Linear Feet 400

No. Lines 5 @ 80' Trench Width 36" Max Trench Bottom Depth 36" Gravel Depth N/A

☑ New System ☐ Repair System Type: I, II, ☑ III, IV, V, VI

System Description: pumped pressure to Harbour (48A)

Repair System Description: ~~LPPPBPS~~ (48A)

Maintenance Agreement Required: ☐ Yes ☑ No

☑ House/Mod. Home ☐ Mobile Home ☐ Business ☐ Other

No. Bedrooms 4 No. Bathrooms 4 No. Employees ____

☐ Slab ☐ Crawl Space ☑ Basement w/plumbing ☐ Basement wo/plumbing


Water Supply: ☐ Individual ☑ ~~Community~~ ☐ Public

Comments: All water line and Irrigation supply lines cross, they must do so with the wastewater line below with 18" min. separation


Comments: ~~X~~ HOUSE MOVED TO 90' OFF WATER. ~~X~~

INITIAL SITE SKETCH

1" = 100'

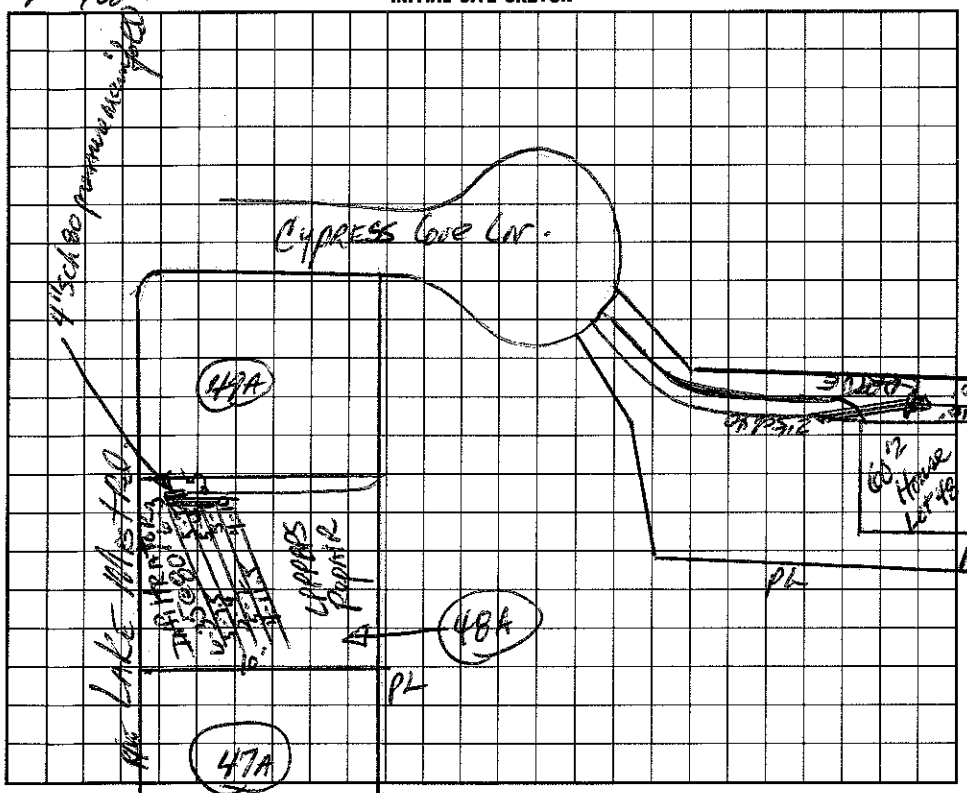

AS BUILT SKETCH

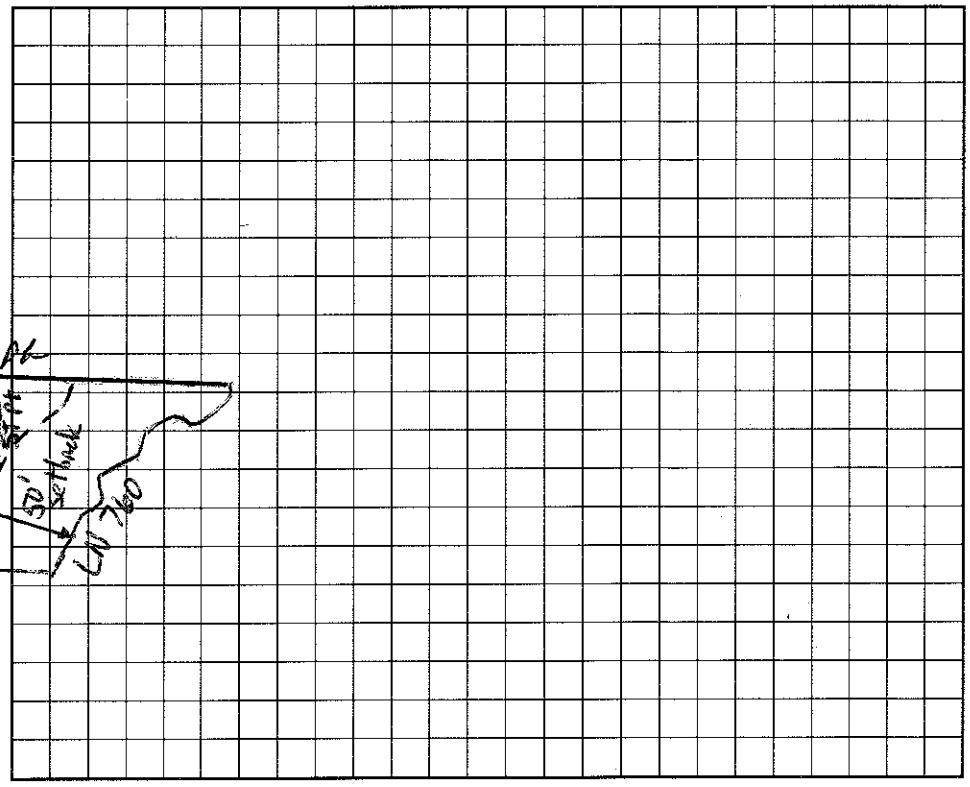

I understand that this permit can be suspended or revoked if any false information is supplied toward securing the permit/any unauthorized changes are made to the site/any unauthorized changes are made in the installation of the system.

Signed: ~~X~~ Tony Beard CPSS (SI) Installed by: Machine Const.

Improvement Permit by: David Thomas RS date 11-2-95 Certificate of Completion by: _____ date _____

Existing System Inspection by: C. Beard date 2/24/97 Operation Permit by: Wesley Sparks RS. date 12/7/98

HEALTH DEPT. COPY: WHITE INSPECTION COPY (FINAL): GREEN OWNER COPY (FINAL): YELLOW INSPECTION COPY (INITIAL): PINK OWNER COPY (INITIAL): GOLD