IREDELL COUNTY HEALTH DEPARTMENT

704-878-5305 MOORESVILLE 704-664-5281

IMPROVEMENT PERMIT / ~~CERTIFICATE OF COMPLETION~~ / OPERATION PERMIT / EXISTING SYSTEM INSPECTION

PROPERTY DESCRIPTION NO. ~~5945~~ 22996 DATE 2/20/95 TAX MAP NO. pt. of 2CA3 Watershed: X Yes ☐ No

OWNER OR CONTRACTOR M I Homes PHONE: Business 376-9800 ~~Home~~ 4625-58-2957

ADDRESS 1043 E. Morehead St. Charlotte, NC.

LOCATION Sunrise Cir - Brawley Sch TR Bay Harbour TL Lake Mist TL Sunshine Cir, lot on (6)

SUBDIVISION Harbour BLOCK / SECTION MAP D LOT 30 LOT AREA ~34,000 FT² SITE CLASS PS DESIGN FLOW 360 L.T.A.R. .3

Septic Tank: 1000 Gallons; STB 794 Date 4/18/96
Pump Tank: ____ Gallons; PT ____ Date ____
Pump Make: ____ Model ____ Serial No. ____
Nitrification Field: No Fields 1 Square Feet 1200 Linear Feet ~~X~~ 300
No Lines 3 Trench Width 36" Max Trench Bottom Depth 30" Gravel Depth 6" SAND

X New System ☐ Repair System Type: I. II (III) IV. V. VI
System Description: GRAV - CHAMBERED PLASTIC
Repair System Description: SAME
Maintenance Agreement Required: ☐ Yes X No


X House/Mod. Home No. Bedrooms 3
☐ Mobile Home No. Bathrooms 3
☐ Business No. Employees ____
☐ Other ____
☐ Slab X Crawl Space ☐ Basement w/plumbing ☐ Basement wo/plumbing

Water Supply:
☐ Individual
X Community
☐ Public

Comments: ~~X~~ CHAMBERED PLASTIC DOME 25% REDUCTION FOR THIS DRAINFIELD MATERIAL

Comments: Pump & Box & Ball Check Valve

INITIAL SITE SKETCH

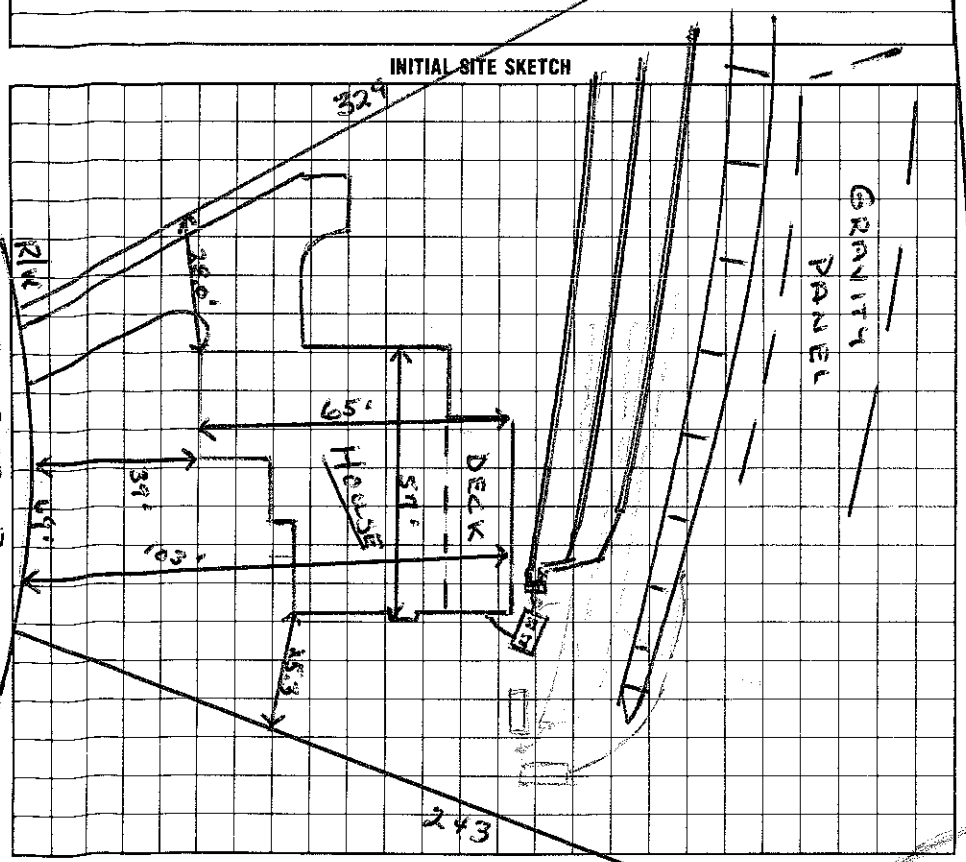

AS BUILT SKETCH

I understand that this permit can be suspended or revoked if any false information is supplied toward securing the permit/any unauthorized changes are made to the site/any unauthorized changes are made in the installation of the system.

Signed: X Marvin O. Arnar Installed by: R L MacLeod

Improvement Permit by: Wesley Sparks RS. date 2/20/96 Certificate of Completion by: ____ date ____

Existing system inspection by/not Wesley Sparks RS. date 2/20/96 Operation Permit by: Wesley Sparks RS. date 9/12/96

HEALTH DEPT. COPY: WHITE INSPECTION COPY (FINAL): GREEN OWNER COPY (FINAL): YELLOW INSPECTION COPY (INITIAL): PINK OWNER COPY (INITIAL): GOLD