IREDELL COUNTY HEALTH DEPARTMENT

AUTHORIZATION TO CONSTRUCT

STATESVILLE 704-878-5305 MOORESVILLE 704-664-5281

IMPROVEMENT PERMIT / ~~CERTIFICATE OF COMPLETION~~ / OPERATION PERMIT / EXISTING SYSTEM INSPECTION

PROPERTY DESCRIPTION NO. 25335 DATE 10/22/96 TAX MAP NO. ~~2614-3 60~~ 4625583210 Watershed: ☑ Yes ☐ No

OWNER OR CONTRACTOR M/I HOMES PHONE: Business 376-9800 Home

ADDRESS 1043 E. MOREHEAD CHARLOTTE NC 28204

LOCATION BRAWLEY SCHOOL RD - TR CHUCKWOOD - TR LAKE MIST - TL CYPRESS COVE - 2ND LOT ON LEFT

SUBDIVISION HARBOUR BLOCK / SECTION # LOT 44 LOT AREA — SITE CLASS. PS DESIGN FLOW 480GAD L.T.A.R. .3 GPD/FT²

Septic Tank: 1000 Gallons; STB 794 Date 11/9/96

Pump Tank: ____ Gallons; PT ____ Date ____

Pump Make: ____ Model ____ Serial No. ____

Nitrification Field: No Fields 1 Square Feet 90 Linear Feet 270

No Lines 6 @ 45' Trench Width 24" Max Trench Bottom Depth 36" Gravel Depth N/A

☑ New System ☐ Repair System Type: I, II, III, IV, V, VI

System Description: GRAVITY PANEL

Repair System Description: SAME

Maintenance Agreement Required: ☐ Yes ☑ No

☑ House/Mod. Home No. Bedrooms 4

☐ Mobile Home No. Bathrooms 4

☐ Business No. Employees ____

☐ Other ____


☐ Slab ☑ Crawl Space ☐ Basement w/plumbing ☐ Basement wo/plumbing

Water Supply: ☐ Individual ☑ Community ☐ Public

Comments:

Comments:

INITIAL SITE SKETCH 1"=50'

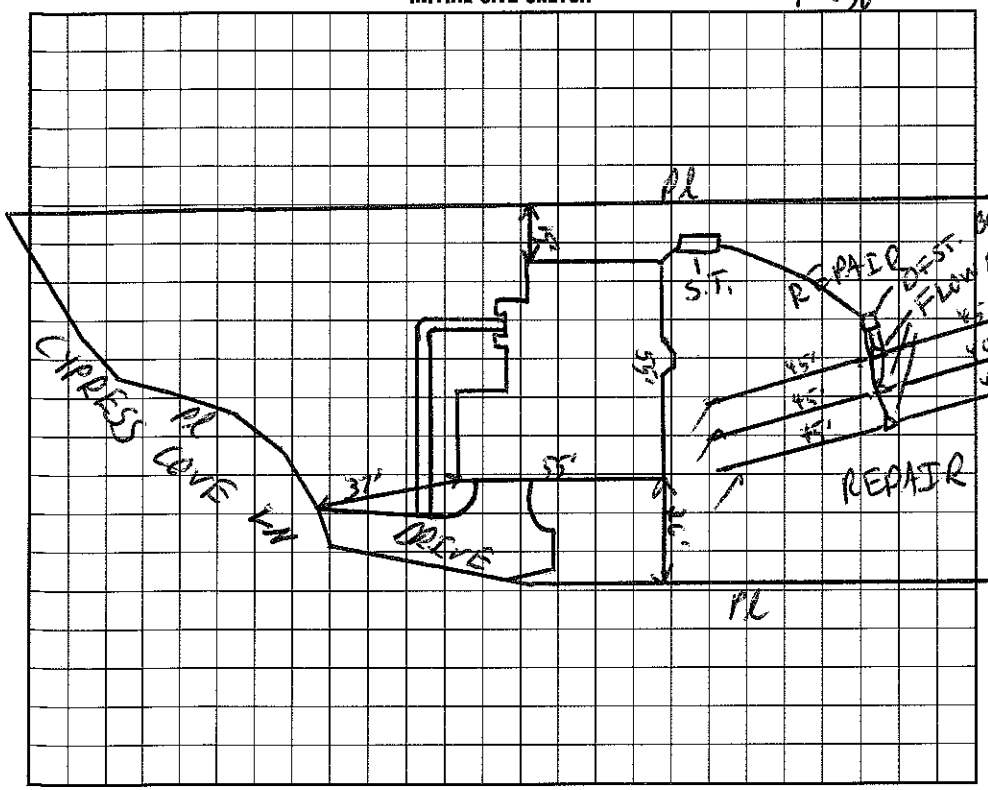

AS BUILT SKETCH

I understand that this permit can be suspended or revoked if any false information is supplied toward securing the permit/any unauthorized changes are made to the site/any unauthorized changes are made in the installation of the system.

Signed: Phil G. Pennington

Improvement Permit by: C. Ray Freeman EHSI date 10/22/96

AUTHORIZATION TO CONSTRUCT

~~Existing System Inspection by:~~ C. Ray Freeman EHSI date 10/22/96

Installed by: MacLeod Const Co.

Certificate of Completion by: Wesley Sparks R.S. date 4/2/97

Operation Permit by: Wesley Sparks R.S. date 4/2/97

HEALTH DEPT. COPY: WHITE INSPECTION COPY (FINAL): GREEN OWNER COPY (FINAL): YELLOW INSPECTION COPY (INITIAL): PINK OWNER COPY (INITIAL): GOLD