2nd

IREDELL COUNTY HEALTH DEPARTMENT

STATESVILLE 704-878-5305 MOORESVILLE 704-664-5281

IMPROVEMENT PERMIT / AUTHORIZATION TO CONSTRUCT / OPERATION PERMIT / EXISTING SYSTEM INSPECTION

PERMIT# 21687 PIN# ~~pt of~~ JCA 3 4614558 4125 DATE 6/18/98

OWNER OR CONTRACTOR MI HOMES PHONE: Business 663-6905-T JACOBS Home

ADDRESS CLT - PO BOX 1003 CHARLOTTE

LOCATION BRAWLEY SCHOOL RD - TR BAY HARBOUR - TL LATE MOST - ON CORNER OF CYPRESS COVE LN

SUBDIVISION HARBOUR BLOCK / SECTION II LOT 43 LOT AREA SITE CLASS. PS DESIGN FLOW 600 GPD L.T.A.R. .25 GPD/FT2

Septic Tank: 1000 Gallons; STB 794 Date 8/3/98

Pump Tank: 1000 Gallons; PT 27 Date 9/26/98

Pump Make: HYDROMATIC Model SK50A1 Serial No. 6198

Nitrification Field: No Fields 1 Square Feet 800 Linear Feet 400

No Lines 7 Trench Width 24" Max Trench Bottom Depth 36" Gravel Depth N/A

☑ New System ☐ Repair System Type: I, II, III (IV) V, VI

System Description: PUMP PANEL

Repair System Description: SAME

Maintenance Agreement Required: ☑ Yes ☐ No

☑ House/Mod. Home No. Bedrooms 5

☐ Mobile Home No. Bathrooms 4

☐ Business No. Employees

☐ Other

☐ Slab ☑ Crawl Space ☐ Basement w/plumbing ☐ Basement wo/plumbing


Water Supply: ☐ Individual ☐ Public ☑ Community

Comments:/Conditions: * ~~RECOMD~~ RECOMMEND BY HEALTH DEPT. TO INSTALL A BARRICADE FENCE TO PROTECT SYSTEM AND REPAIR FROM STORAGE AND TRAFFIC. IF AREAS ARE DESTROYED THEN PERMIT (WILL) BE VOID!!


Comments:/Conditions:

1"=50'

INITIAL SITE SKETCH

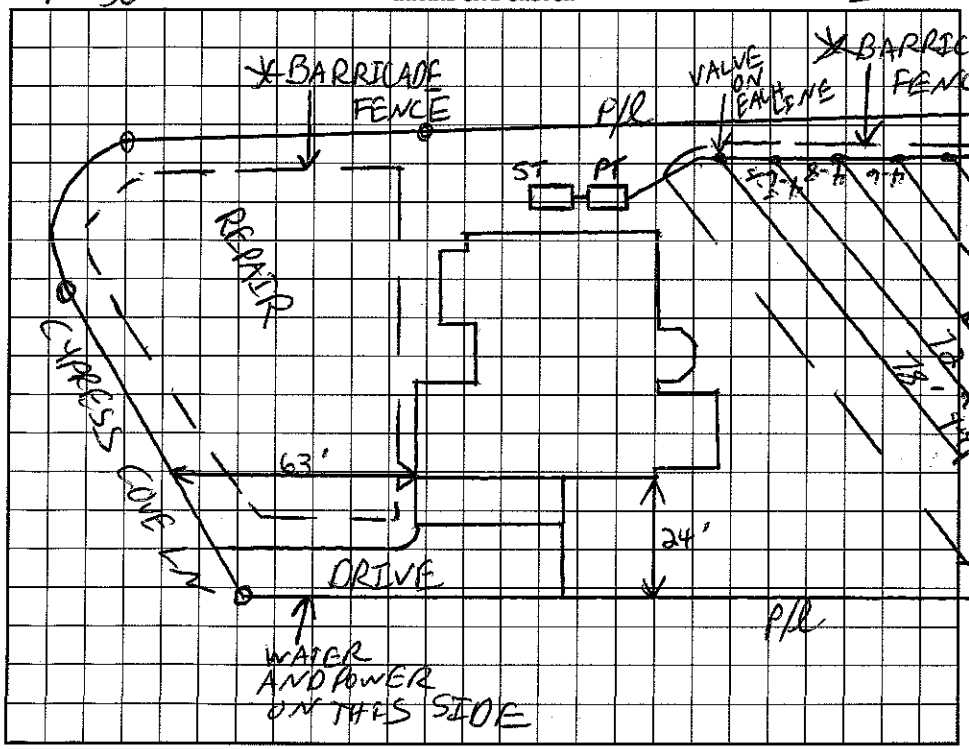

AS BUILT SKETCH

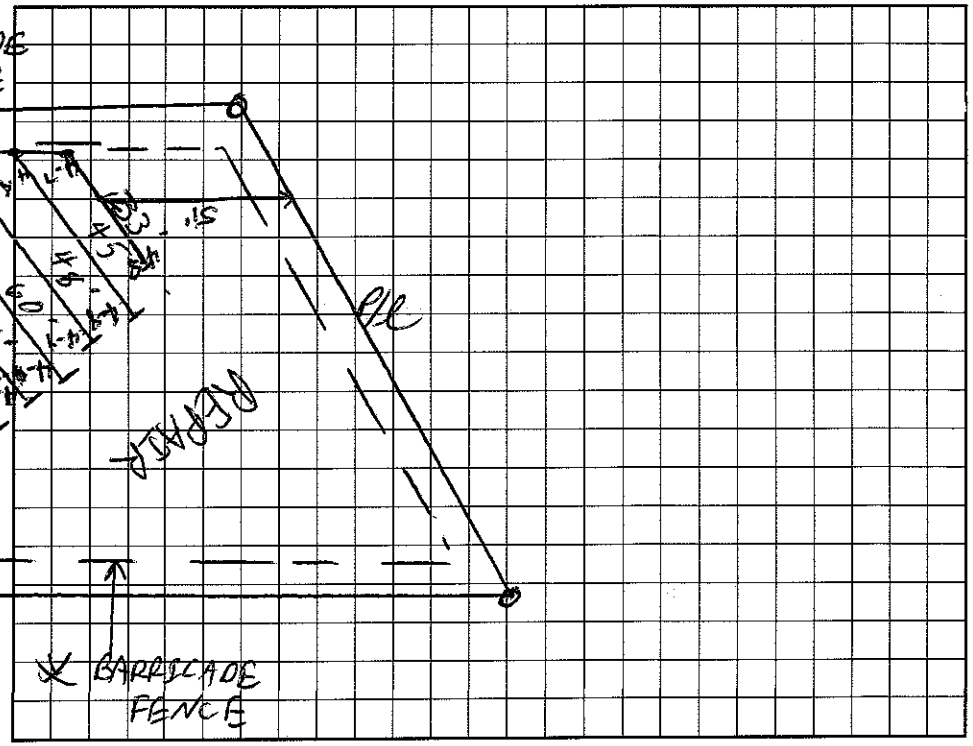

I understand that this permit can be suspended or revoked if any false information is supplied toward securing the permit/any unauthorized changes are made to the site/any unauthorized changes are made in the installation of the system. Improvement Permit with plat valid without expiration. Improvement Permit with site plan valid for sixty months. Authorization to Construct is valid for a period equal to that of Improvement Permit – not to exceed sixty months.

Signed: Paul F. Pennington date 6-19-98

Improvement Permit by: C. Ray Teem RS date 6/18/98

Authorization to Construct by: C. Ray Teem RS date 6/18/98

Installed by: Macleod Construction

Operation Permit by: Wesley Sparks R.S. date 11/12/98

Existing System Inspection by: date

HEALTH DEPT. COPY: WHITE INSPECTION COPY (FINAL): GREEN OWNER COPY (FINAL): YELLOW INSPECTION COPY (INITIAL): PINK OWNER COPY (INITIAL): GOLD