IREDELL COUNTY HEALTH DEPARTMENT

AUTHORIZATION TO CONSTRUCT

STATESVILLE 704-878-5305 MOORESVILLE 704-664-5281

IMPROVEMENT PERMIT / ~~CERTIFICATE OF COMPLETION~~ / OPERATION PERMIT / EXISTING SYSTEM INSPECT

PROPERTY DESCRIPTION NO. 25420 DATE 3/10/97 TAX MAP NO. 2F-12-A-50 Watershed: ☑ Yes ☐

OWNER OR CONTRACTOR MI HOMES PHONE: Business 663-6905 ~~Home~~ 4625-58-4457

ADDRESS 1043 E. MOREHEAD ST CHARLOTTE 28204

LOCATION BRAWLEY SCHOOL RD - TR BAY HARBOUR - TL LAKE MIST - TR CYPRESS LANE - 2nd LOT ON RT

SUBDIVISION HARBOUR BLOCK / SECTION D LOT 50 LOT AREA _____ SITE CLASS. PS DESIGN FLOW 450GPD L.T.A.R. .3 GPD/FT²

Septic Tank: 1000 Gallons; STB 794 Date 2/21/97
Pump Tank: _____ Gallons; PT _____ Date _____
Pump Make: _____ Model _____ Serial No. _____
Nitrification Field: No Fields 1 Square Feet 1200 Linear Feet 400
No Lines 5 @ 50 Trench Width 36" Max Trench Bottom Depth 36" Gravel Depth N/A

☑ New System ☐ Repair System Type: I, II, (III) IV, V, VI
System Description: GRAVITY CHAMBERED
Repair System Description: SAME
Maintenance Agreement Required: ☐ Yes ☑ No

☑ House/Mod. Home No. Bedrooms 4
☐ Mobile Home No. Bathrooms 3.5
☐ Business No. Employees ____
☐ Other _____
☐ Slab ☑ Crawl Space ☐ Basement w/plumbing ☐ Basement wo/plumbing


Water Supply:
☐ Individual
☑ Community
☐ Public

Comments:


Comments:

INITIAL SITE SKETCH

1" = 40'

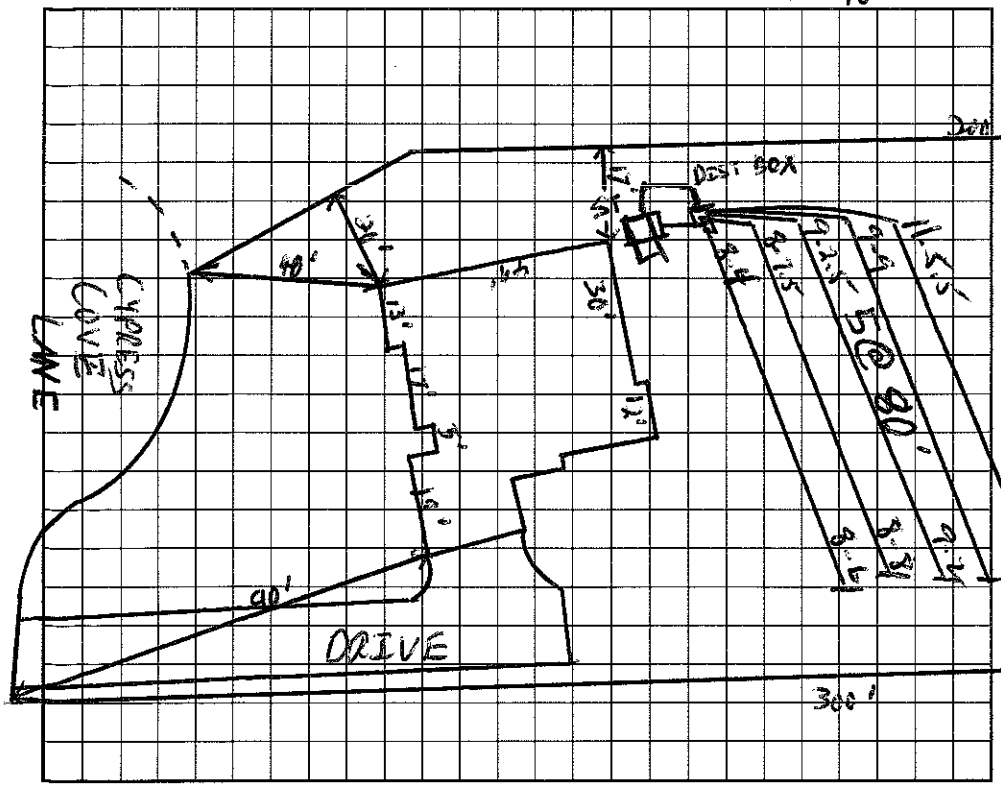

AS BUILT SKETCH

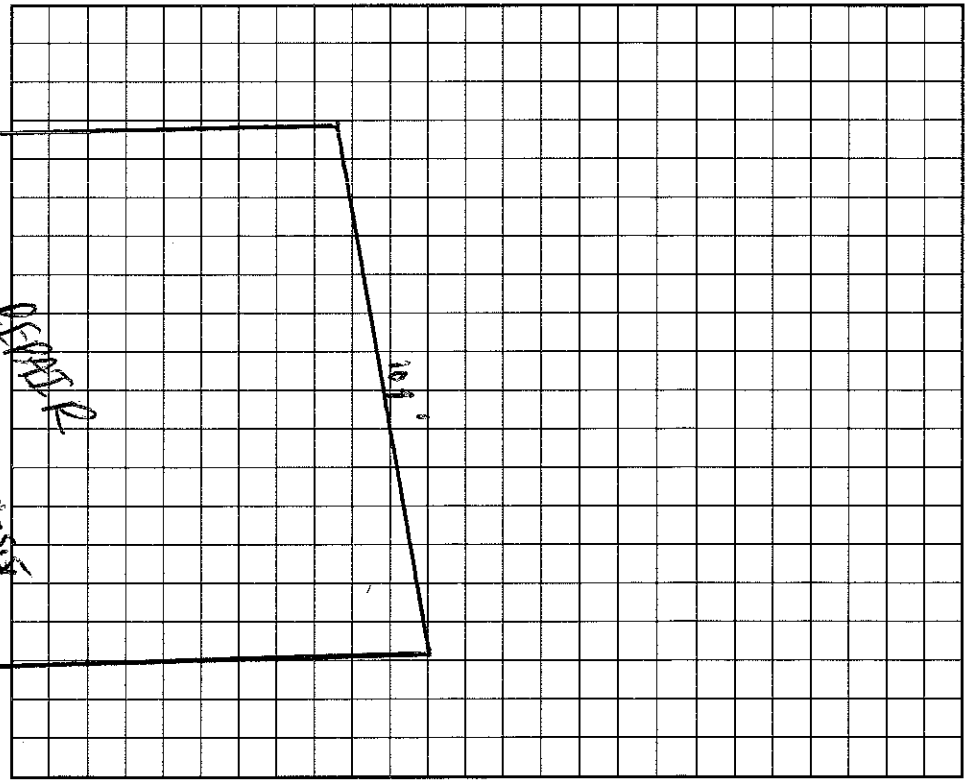

I understand that this permit can be suspended or revoked if any false information is supplied toward securing the permit/any unauthorized changes are made to the site/any unauthorized changes are made in the installation of the system. Improvement Permit is valid for 60 months from date of issuance.

Signed: _____

Improvement Permit by: _____ date 3/10/97

~~Existing System Inspection by:~~ _____ date 3/10/97

AUTHORIZATION TO CONSTRUCT

Installed by: MacLeod Const.

Certificate of Completion by: Wesley Sparks RS date 5/27/97

Operation Permit by: Wesley Sparks RS. date 5/27/97

HEALTH DEPT. COPY: WHITE INSPECTION COPY (FINAL): GREEN OWNER COPY (FINAL): YELLOW INSPECTION COPY (INITIAL): PINK OWNER COPY (INITIAL): GOLD