REDELL COUNTY HEALTH DEPARTMENT

AUTHORIZATION TO CONSTRUCT

~~STATESVILLE~~ 704-878-5305 MOORESVILLE 704-664-5281

IMPROVEMENT PERMIT / ~~CERTIFICATE OF COMPLETION~~ / OPERATION PERMIT / EXISTING SYSTEM INSPECTION

PROPERTY DESCRIPTION NO. 25419 DATE 12/6/96 TAX MAP NO. 2F-12-A-53 Watershed: ☑ Yes ☐ No

OWNER OR CONTRACTOR M I HOMES PHONE: Business 376-9800 Home

ADDRESS 1043 MOREHEAD ST. CHARLOTTE 28204

LOCATION BRAWLEY SCHOOL RD - TL BAY HARBOUR - TL LAKE MIST - 3RD LOT ON LEFT AFTER CYPRESS COVE

SUBDIVISION HARBOUR BLOCK / SECTION II LOT 53 LOT AREA SITE CLASS. PS DESIGN FLOW 480 GPD L.T.A.R. .36 GPD/FT²

Septic Tank: 1000 Gallons; STB 794 Date 2/19/97

Pump Tank: Gallons; PT Date

Pump Make: Model Serial No.

Nitrification Field: No Fields 2 Square Feet 1260 Linear Feet 420

No Lines 6 Trench Width 36" Max Trench Bottom Depth 36" Gravel Depth N/A

☑ New System ☐ Repair System Type: I, II, (III) IV, V, VI

System Description: GRAVITY CHAMBERED OR SIMILAR

Repair System Description: PUMP CHAMBERED OR SIMILAR

Maintenance Agreement Required: ☐ Yes ☑ No

☑ House/Mod. Home ☐ Mobile Home ☐ Business ☐ Other

No. Bedrooms 4 No. Bathrooms 4 No. Employees


☐ Slab ☑ Crawl Space ☐ Basement w/plumbing ☐ Basement wo/plumbing

Water Supply: ☐ Individual ☑ Community ☐ Public


Comments:

Comments:

INITIAL SITE SKETCH

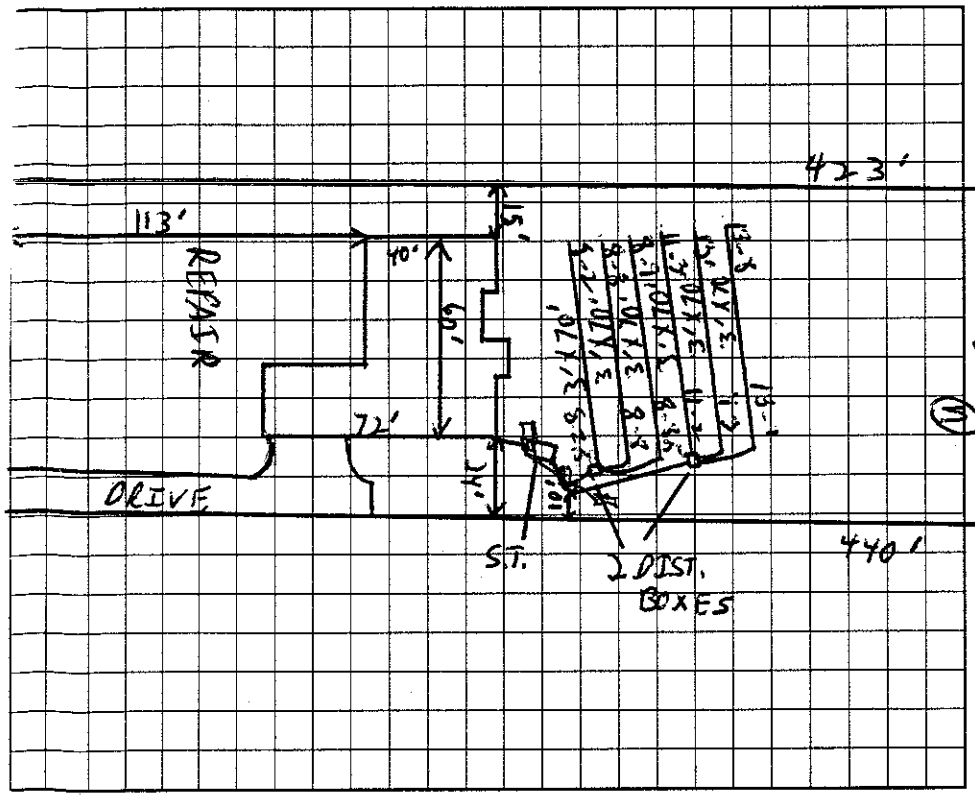

AS BUILT SKETCH

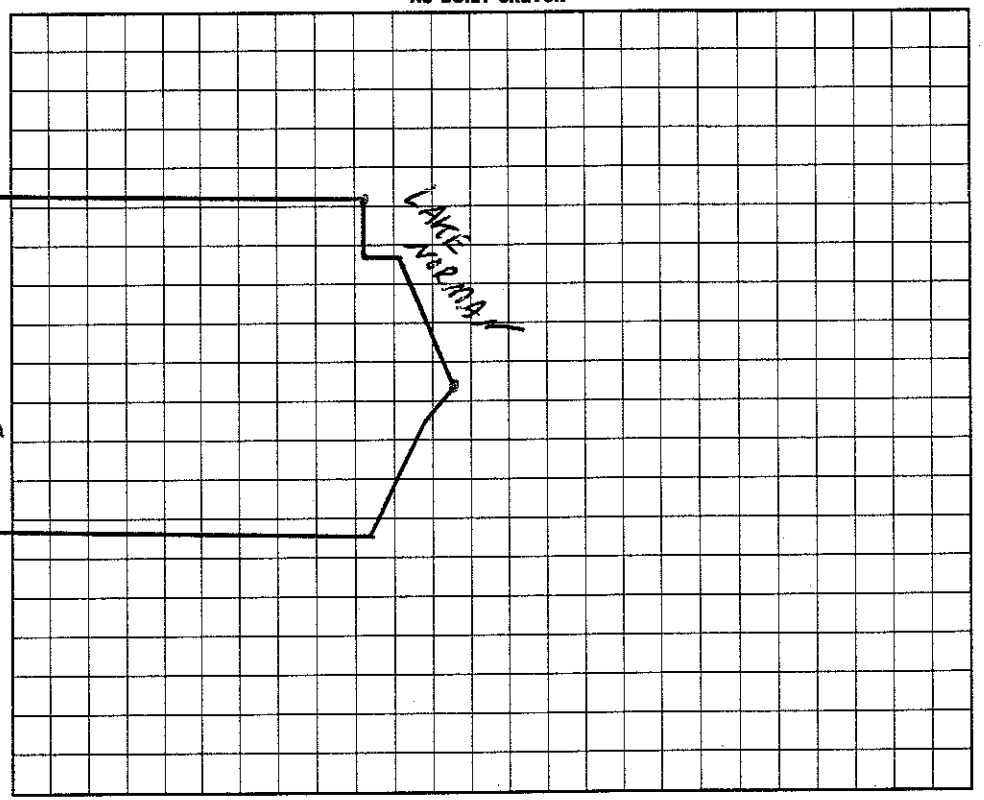

I understand that this permit can be suspended or revoked if any false information is supplied toward securing the permit/any unauthorized changes are made to the site/any unauthorized changes are made in the installation of the system.

Signed: Tonya C Jarvis CPSS (B) 12-6-96

Improvement Permit by: C. Ray Jarvis EHSE date 12/6/96

AUTHORIZATION

Existing System Inspection by: C. Ray Jarvis EHSE date 12/6/96

CONSTRUCTION

Installed by: Macleod Const Co.

Certificate of Completion by: Wesley Sparks RS date 4/18/97

Operation Permit by: Wesley Sparks RS date 4/18/97

HEALTH DEPT. COPY: WHITE INSPECTION COPY (FINAL): GREEN OWNER COPY (FINAL): YELLOW INSPECTION COPY (INITIAL): PINK OWNER COPY (INITIAL): GOLD