IREDELL COUNTY HEALTH DEPARTMENT

↑ AUTHORIZATION TO CONSTRUCT

STATESVILLE 704-878-5305 MOORESVILLE 704-664-5281

IMPROVEMENT PERMIT / ~~CERTIFICATE OF COMPLETION~~ / OPERATION PERMIT / EXISTING SYSTEM INSPECTION

PROPERTY DESCRIPTION NO. 25419 DATE 12/6/96 TAX MAP NO. 2F-12-A-53 Watershed: ☑ Yes ☐ No

OWNER OR CONTRACTOR NI HOMES PHONE: Business 376-9800 ~~Home~~ 4625-58-5705

ADDRESS 1043 MOREHEAD ST. CHARLOTTE 28204

LOCATION BRAWLEY SCHOOL RD. TO BAY HARBOR - TO LAKE MIST - 3RD LOT ON LEFT AFTER CYPRESS COVE

SUBDIVISION HARBOR BLOCK / SECTION IV LOT 53 LOT AREA _____ SITE CLASS. PS DESIGN FLOW 480 GPD L.T.A.R. 1.36 GPD/FT²

Septic Tank: 1000 Gallons; STB 794 Date 2/19/97

Pump Tank: _____ Gallons; PT _____ Date _____

Pump Make: _____ Model _____ Serial No. _____

Nitrification Field: No Fields 2 Square Feet 1260 Linear Feet 420

No Lines 6 Trench Width 36" Max Trench Bottom Depth 36" Gravel Depth N/A

☑ New System ☐ Repair System Type: I, II, (III) IV, V, VI

System Description: GRAVITY CHAMBERED OR SIMILAR

Repair System Description: PUMP CHAMBERED OR SIMILAR

Maintenance Agreement Required: ☐ Yes ☑ No

☑ House/Mod. Home ☐ Mobile Home ☐ Business ☐ Other

No. Bedrooms 4 No. Bathrooms 4 No. Employees ____


☐ Slab ☑ Crawl Space ☐ Basement w/plumbing ☐ Basement wo/plumbing

Water Supply: ☐ Individual ☑ Community ☐ Public


Comments:

Comments:

INITIAL SITE SKETCH

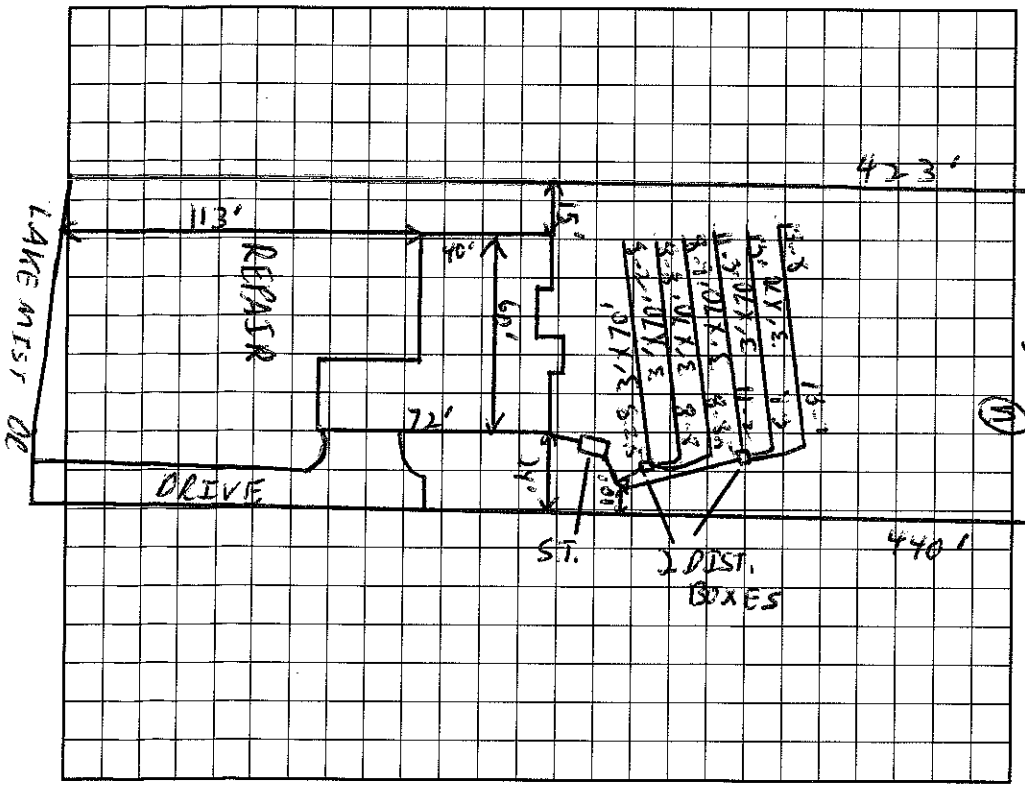

AS BUILT SKETCH

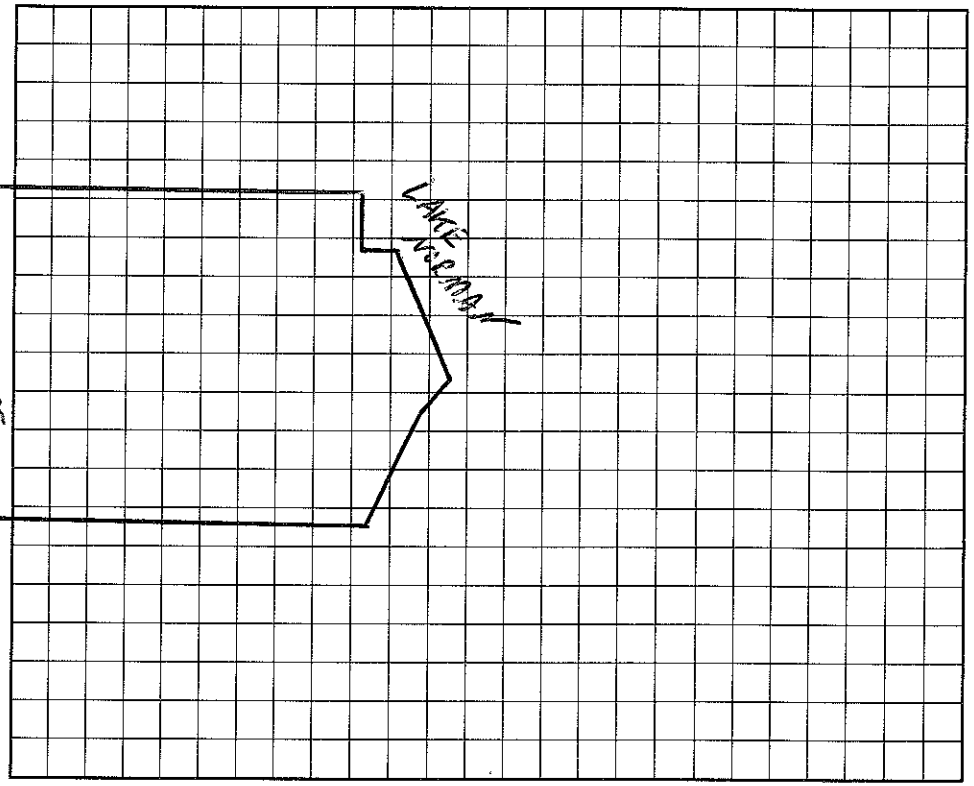

I understand that this permit can be suspended or revoked if any false information is supplied toward securing the permit/any unauthorized changes are made to the site/any unauthorized changes are made in the installation of the system.

Signed: Tony C Jarvis CPSS 12-6-96 Installed by: Macleod Const Co.

Improvement Permit by: C. Ray Tarr EHSI date 12/6/96 Certificate of Completion by: Wesley Speeds RS date 4/15/97

AUTHORIZATION TO CONSTRUCT ~~Existing System Inspection by:~~ C. Ray Tarr EHSI date 12/16/96 Operation Permit by: Wesley Speeds RS date 4/15/97

HEALTH DEPT. COPY: WHITE INSPECTION COPY (FINAL): GREEN OWNER COPY (FINAL): YELLOW INSPECTION COPY (INITIAL): PINK OWNER COPY (INITIAL): GOLD