IREDELL COUNTY HEALTH DEPARTMENT

TATESVILLE 704-878-5305 MOORESVILLE 704-664-5281

IMPROVEMENT PERMIT / AUTHORIZATION TO CONSTRUCT / OPERATION PERMIT / EXISTING SYSTEM INSPECTION

PERMIT# 25622 PIN# 2F-12-B-56 DATE 5/1/98

OWNER OR CONTRACTOR MI HOMES PHONE: Business 376-9800 ~~Home~~ 462-58-5965

ADDRESS 1043 E. MOREHEAD ST. CHARLOTTE 28204

LOCATION BRAWLEY SCHOOL - TR BAY HARBOUR RD - TL LAKE NEST ON RT

SUBDIVISION HARBOUR BLOCK / SECTION II LOT 56 LOT AREA SITE CLASS. PS DESIGN FLOW 500 GD L.T.A.R. .385 GAD/FT2

Septic Tank: 1500 Gallons; STB Date

Pump Tank: Gallons; PT Date

Pump Make: Model Serial No.

Nitrification Field: No Fields 1 Square Feet 1386 Linear Feet 462

No Lines 6 @ 77' Trench Width 36" Max Trench Bottom Depth 36" Gravel Depth MA

☑ New System ☐ Repair System Type: I, II, III, IV, V, VI

System Description: GRAVITY CHAMBERED OR HOS

Repair System Description: GRAVITY/PUMP PANEL

Maintenance Agreement Required: ☐ Yes ☑ No

☑ House/Mod. Home No. Bedrooms 5

☐ Mobile Home No. Bathrooms 4

☐ Business No. Employees

☐ Other


☐ Slab ☑ Crawl Space ☐ Basement w/plumbing ☐ Basement wo/plumbing

Water Supply: ☐ Individual ☐ Public ☑ Community


Comments:/Conditions:

Comments:/Conditions:
Single D/B with 6 outlets
No flow divider

INITIAL SITE SKETCH 1"=40'

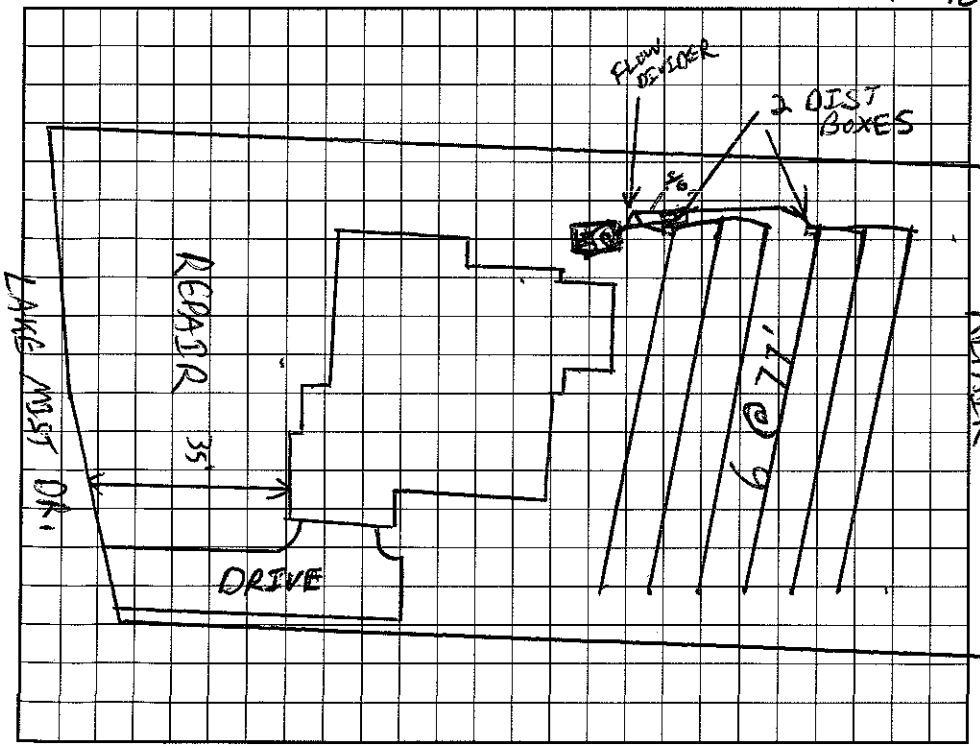

AS BUILT SKETCH

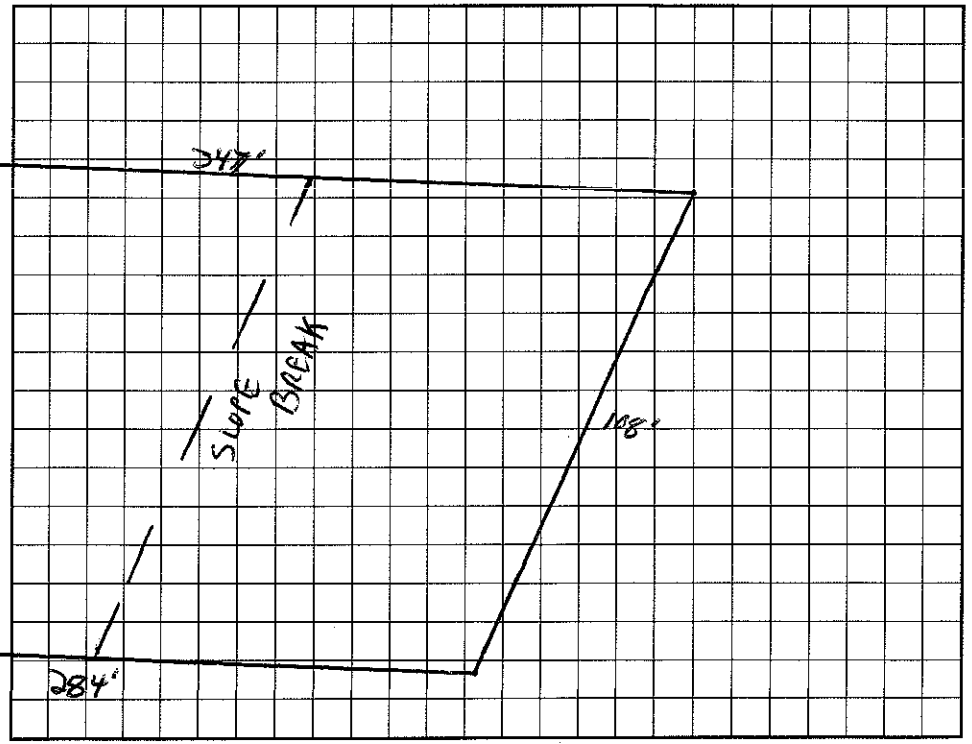

I understand that this permit can be suspended or revoked if any false information is supplied toward securing the permit/any unauthorized changes are made to the site/any unauthorized changes are made in the installation of the system. Improvement Permit with plat valid without expiration. Improvement Permit with site plan valid for sixty months. Authorization to Construct is valid for a period equal to that of Improvement Permit – not to exceed sixty months.

Signed: [signature] Agent date 5/4/98

Improvement Permit by: C. B. Freeman RS date 5/1/98

Authorization to Construct by: C. B. Freeman RS date 5/1/98

Installed by: Morehead Const.

Operation Permit by: Wesley Sparks RS date 10/28/98

Existing System Inspection by: date

HEALTH DEPT. COPY: WHITE INSPECTION COPY (FINAL): GREEN OWNER COPY (FINAL): YELLOW INSPECTION COPY (INITIAL): PINK OWNER COPY (INITIAL): GOLD