IREDELL COUNTY HEALTH DEPARTMENT

AUTHORIZATION TO CONSTRUCT

STATESVILLE 704-878-5305 MOORESVILLE 704-664-5281

IMPROVEMENT PERMIT / ~~CERTIFICATE OF COMPLETION~~ / OPERATION PERMIT / EXISTING SYSTEM INSPECTION

PROPERTY DESCRIPTION NO. 066521 DATE 6/10/97 TAX MAP NO. 4625585965 Watershed: ☑ Yes ☐ No

OWNER OR CONTRACTOR MI HOMES PHONE: Business 663-6405 - T JACOBS Home

ADDRESS PO BOX 1003 CHARLOTTE NC 28201

LOCATION BRAWLEY SCHOOL RD - TR BAY HARBOUR - TL LAKE WEST - 4TH LOT ON RT

SUBDIVISION HARBOUR BLOCK / SECTION II LOT 55 LOT AREA .86 AC SITE CLASS. PS DESIGN FLOW 480 GPD L.T.A.R. .36 GPD/FT2

Septic Tank: 1600 Gallons; STB 994 Date 6/30/97

Pump Tank: _____ Gallons; PT _____ Date _____

Pump Make: _____ Model _____ Serial No. _____

Nitrification Field: No Fields 1 Square Feet 1200 Linear Feet 400

No Lines 6@67' Trench Width 36" Max Trench Bottom Depth 36" Gravel Depth N/A

☑ New System ☐ Repair System Type: I, II, III, IV, V, VI

System Description: GRAVITY CHAMBERED OR SIMILAR

Repair System Description: GRAVITY PANEL

Maintenance Agreement Required: ☐ Yes ☑ No

☑ House/Mod. Home No. Bedrooms 4

☐ Mobile Home No. Bathrooms 4

☐ Business No. Employees _____

☐ Other _____


☐ Slab ☑ Crawl Space ☐ Basement w/plumbing ☐ Basement wo/plumbing

Water Supply: ☐ Individual ☑ Community ☐ Public


Comments:

Comments:

INITIAL SITE SKETCH 1" = 50'

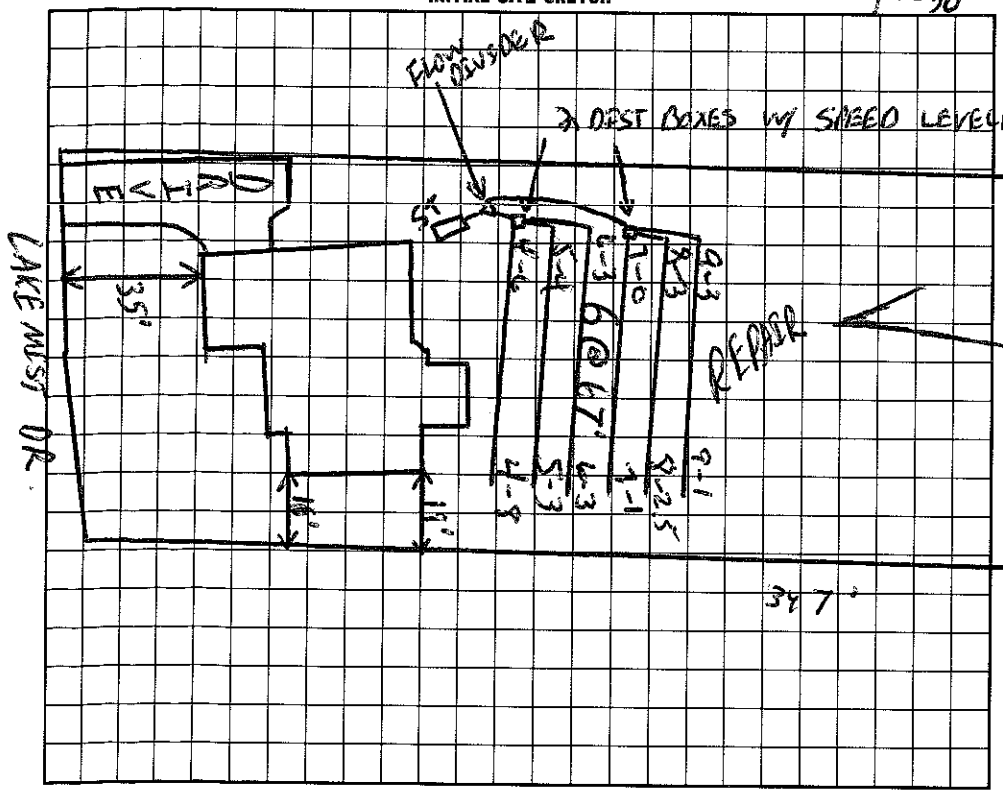

AS BUILT SKETCH

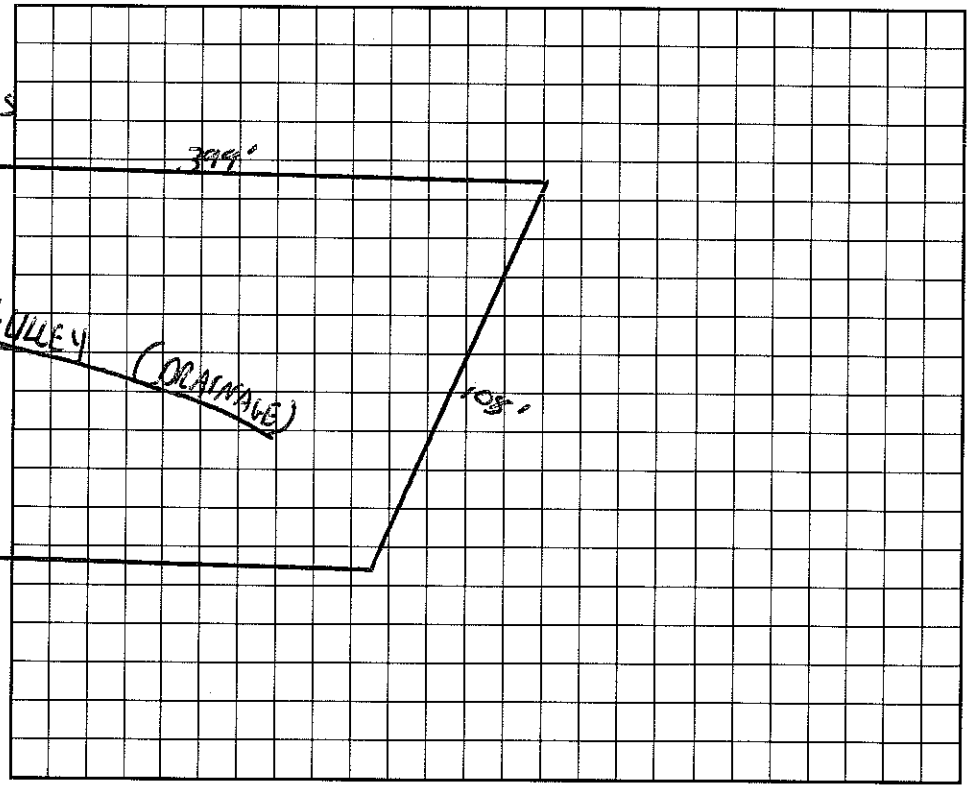

I understand that this permit can be suspended or revoked if any false information is supplied toward securing the permit/any unauthorized changes are made to the site/any unauthorized changes are made in the installation of the system. Improvement Permit is valid for 60 months from date of issuance.

Signed: _____

Improvement Permit by: _____ date 6/10/97

AUTHORIZATION TO CONSTRUCT ~~Existing System Inspection by:~~ _____ date 6/16/97

Installed by: Macleod Const.

Certificate of Completion by: Wesley Sparks RS. date 9/16/97

Operation Permit by: Wesley Sparks RS date 9/16/97

HEALTH DEPT. COPY: WHITE INSPECTION COPY (FINAL): GREEN OWNER COPY (FINAL): YELLOW INSPECTION COPY (INITIAL): PINK OWNER COPY (INITIAL): GOLD