IREDELL COUNTY HEALTH DEPARTMENT

AUTHORIZATION TO CONSTRUCT

STATESVILLE 704-878-5305 MOORESVILLE 704-664-5281

IMPROVEMENT PERMIT / ~~CERTIFICATE OF COMPLETION~~ / OPERATION PERMIT / EXISTING SYSTEM INSPECTION

PROPERTY DESCRIPTION NO. 24827 DATE 10/8/96 TAX MAP NO. ~~2C A 3 (PT of)~~ 4625589040 Watershed: ☑ Yes

OWNER OR CONTRACTOR JOHN WIELAND HOMES PHONE: Business 663-6905 Home

ADDRESS 8325 ARROWRIDGE BLVD. CHARLOTTE 28273

LOCATION BRAWLEY SCHOOL - TR BAY HARBOUR - TL LAKE MIST - TL ~~[illegible]~~ CHINOOK - 5TH LOT ON ~~[illegible]~~ LEFT

SUBDIVISION HARBOUR BLOCK / SECTION 2 LOT 13 LOT AREA 28,747 SITE CLASS. PS DESIGN FLOW 480 GPD L.T.A.R. .3 GPD/FT²

Septic Tank: 1000 Gallons; STB 794 Date 5-29-98

Pump Tank: 1000 Gallons; PT 27 Date 5-29-98

Pump Make: HYDROMATIC Model SK50A1 Serial No. 6-98

Nitrification Field: No Fields 1 Square Feet 840 Linear Feet 280

No Lines 4 Trench Width 24" Max Trench Bottom Depth 36" Gravel Depth N/A

☑ New System ☐ Repair System Type: I, II, III, (IV), V, VI

System Description: PRESSURE PANEL

Repair System Description: SAME

Maintenance Agreement Required: ☑ Yes ☐ No

☐ Slab ☐ Crawl Space ☑ Basement w/plumbing ☐ Basement wo/plumbing

☑ House/Mod. Home No. Bedrooms 4

☐ Mobile Home No. Bathrooms 4

☐ Business No. Employees

☐ Other

Water Supply:

☐ Individual


☑ Community

☐ Public

Comments:

Comments: Drainlines very muddy - flushed until clear.

INITIAL SITE SKETCH **AS BUILT SKETCH**

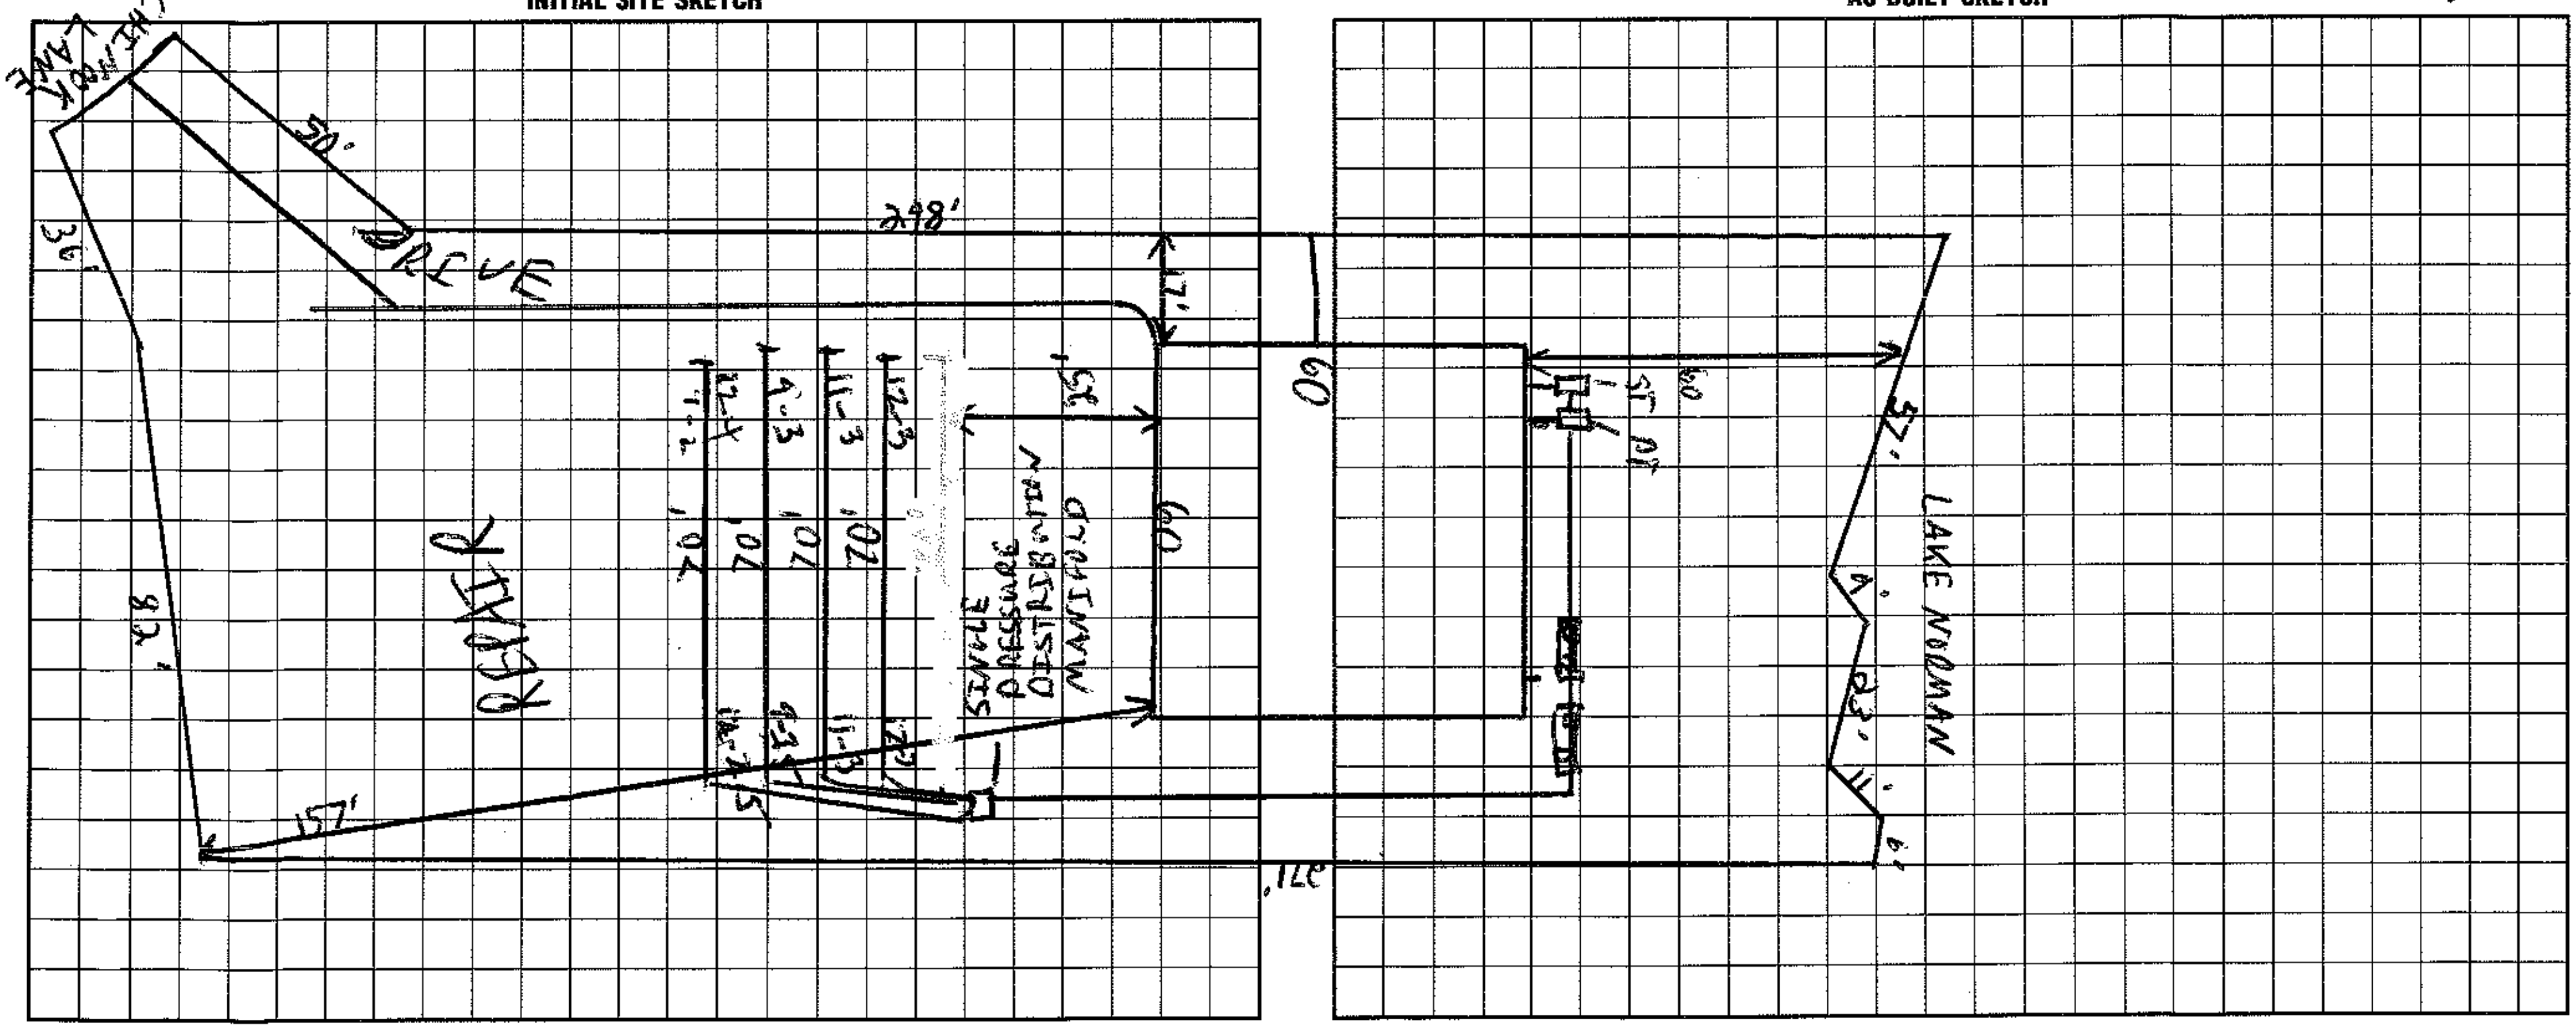

I understand that this permit can be suspended or revoked if any false information is supplied toward securing the permit/any unauthorized changes are made to the site/any unauthorized changes are made in the installation of the system.

Signed: [signature] CPSS (Agent)

Installed by: [signature]

Improvement Permit by: [signature] EHSP date 10/8/96

Certificate of Completion by: date

~~Existing System Inspection by:~~ AUTH. TO CONSTRUCT [signature] EHSI date 10/8/96

Operation Permit by: [signature] date 10/15/98

HEALTH DEPT. COPY: WHITE INSPECTION COPY (FINAL): GREEN OWNER COPY (FINAL): YELLOW INSPECTION COPY (INITIAL): PINK OWNER COPY (INITIAL): GOLD