IREDELL COUNTY HEALTH DEPARTMENT

STATESVILLE 704-878-5305 MOORESVILLE 704-664-5281

IMPROVEMENT PERMIT / AUTHORIZATION TO CONSTRUCT / OPERATION PERMIT / EXISTING SYSTEM INSPECTION

PERMIT# 2178 PIN# 4625 58 9149 WS IV CA DATE 12/19/97

OWNER OR CONTRACTOR John Wieland Homes PHONE: Business _____ Home _____

ADDRESS 8325 Renaissance Blvd. Charlotte, NC. 28273

LOCATION Brawley Sch TR Boy Heilmer TL Lake Mist TL Chuncok Ln. at cul-de-sac go straight

SUBDIVISION HARBOUR BLOCK / SECTION TT LOT 12 LOT AREA .65Ac SITE CLASS. PS DESIGN FLOW 480 L.T.A.R. .3

Septic Tank: 1000 Gallons; STB 794 Date 9/17/97
Pump Tank: 27 Gallons; PT 27 Date 11/2/97
Pump Make: HYDROMATIC Model _____ Serial No. _____
Nitrification Field: No Fields 1 Square Feet 809 Linear Feet 269
No Lines @5 Trench Width 36" Max Trench Bottom Depth 32" Gravel Depth SAND.

☒ New System ☐ Repair System Type: I, II, III, ☒ IV, V, VI
System Description: Pres Panel 16"
Repair System Description: Same
Maintenance Agreement Required: ☒ Yes ☐ No


☒ House/Mod. Home No. Bedrooms 4
☐ Mobile Home No. Bathrooms 4
☐ Business No. Employees _____
☐ Other _____
☐ Slab ☐ Crawl Space ☒ Basement w/plumbing ☐ Basement wo/plumbing

Water Supply:
☐ Individual
☐ Public
☒ Community


Comments:/Conditions:
16"PBS - 3' trench width, Lines on 9' centers
62 Panels - 167 GAL/DOSE

Comments:/Conditions:
1 Pump Tank Full - Pumpout - Top 2 lines have no caps
Dose Amt - Pes

INITIAL SITE SKETCH

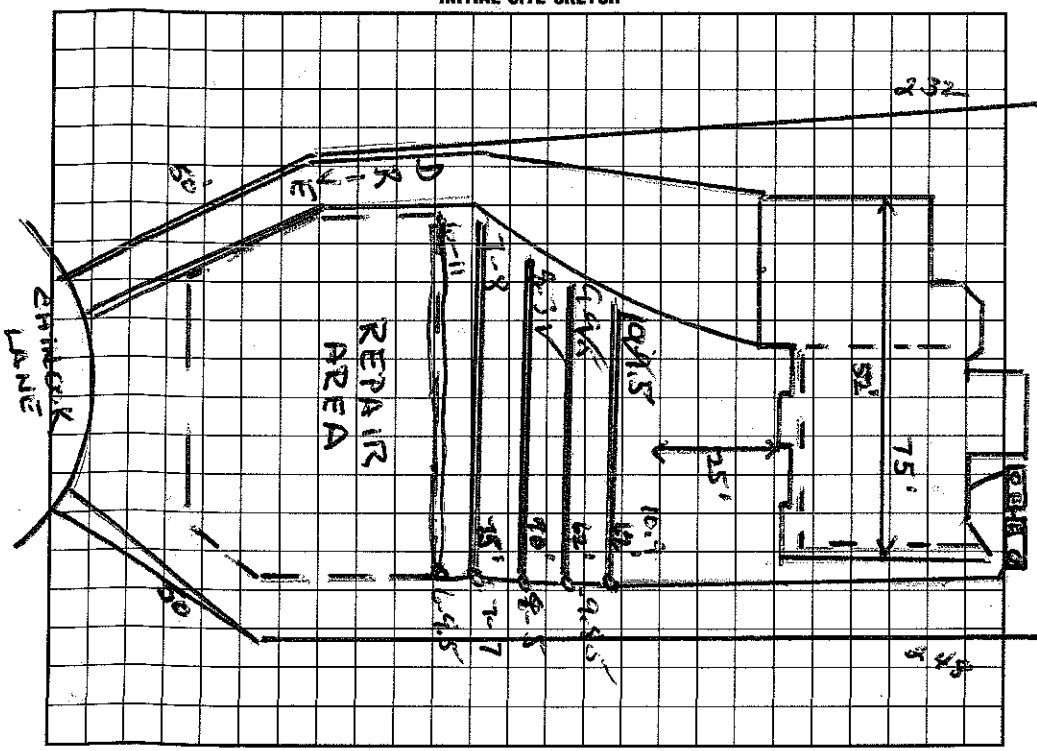

AS BUILT SKETCH

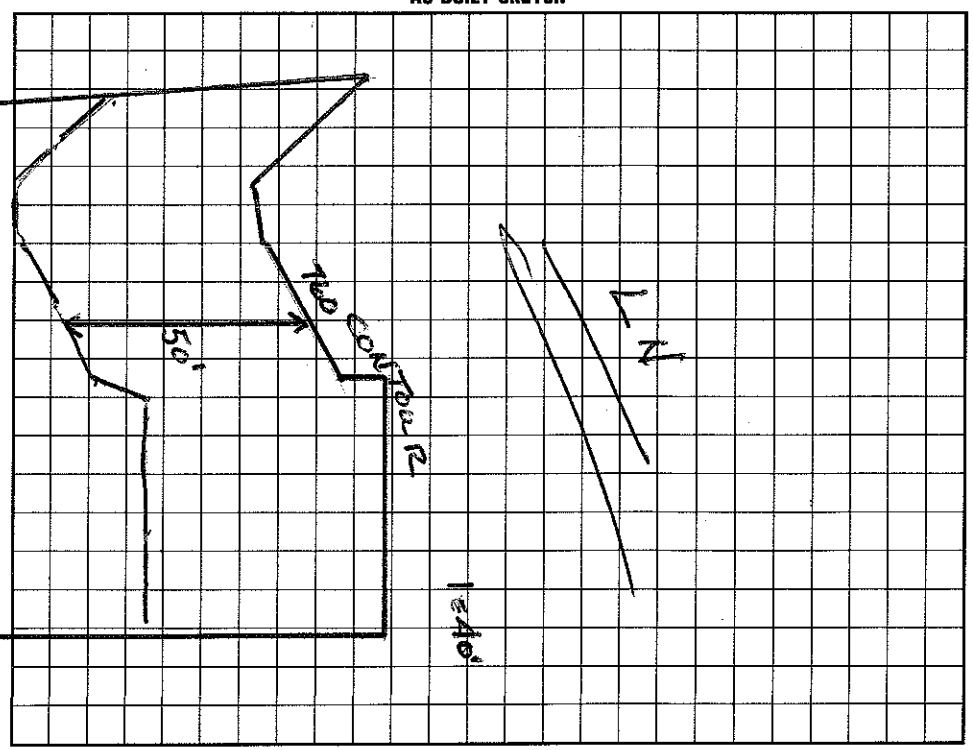

I understand that this permit can be suspended or revoked if any false information is supplied toward securing the permit/any unauthorized changes are made to the site/any unauthorized changes are made in the installation of the system. Improvement Permit with plat valid without expiration. Improvement Permit with site plan valid for sixty months. Authorization to Construct is valid for a period equal to that of Improvement Permit – not to exceed sixty months.

Signed: ✗ Joe W. date _____ Installed by: Macleod Const.

Improvement Permit by: Wesley Sparks RS. date 12/19/97 Operation Permit by: Wesley Sparks RS date 4/14/98

Authorization to Construct by: Wesley Sparks RS date 12/19/97 Existing System Inspection by: Wesley Sparks RS date 4/14/98

HEALTH DEPT. COPY: WHITE INSPECTION COPY (FINAL): GREEN OWNER COPY (FINAL): YELLOW INSPECTION COPY (INITIAL): PINK OWNER COPY (INITIAL): GOLD