IREDELL COUNTY HEALTH DEPARTMENT

Const Auth 4625 58 9269

STATESVILLE 704-878-5305 MOORESVILLE 704-664-5281

IMPROVEMENT PERMIT / ~~CERTIFICATE OF COMPLETION~~ / OPERATION PERMIT / EXISTING SYSTEM INSPECTION

PROPERTY DESCRIPTION NO. 21677 DATE Dec 11, '95 TAX MAP NO. part of 2CA3 Watershed: ☑ Yes ☐ No

OWNER OR CONTRACTOR Crescent Resources c/o Robert Wieland PHONE: Business _____ Home _____ WSHCA

ADDRESS PO Box 1003, Charlotte

LOCATION Brawley Sch Rd. TR Bay Harbour TL LAKE Mist TL ~~Ivy Way Lane~~ Chinook Ln. at end, (L) off Cul de sac.

SUBDIVISION Harbour BLOCK / SECTION 9E LOT 11 LOT AREA > 20,000 ft² SITE CLASS. PSpa, MSO DESIGN FLOW 480 gpd L.T.A.R. .13

Septic Tank: 1000 Gallons; STB 794 Date 1/8/97

Pump Tank: 1000 Gallons; PT 27 Date 8/18/97

Pump Make: _____ Model _____ Serial No. _____

Nitrification Field: No Fields 1 Square Feet _____ Linear Feet 270

No Lines 5 Trench Width 24" Max Trench Bottom Depth 36" Gravel Depth N/A

☑ New System ☐ Repair System Type: I, II, III, (IV) V, VI

System Description: LP Panel

Repair System Description: LP Panel

Maintenance Agreement Required: ☑ Yes ☐ No

☑ House/Mod. Home No. Bedrooms 4

☐ Mobile Home No. Bathrooms 4

☐ Business No. Employees _____

☐ Other _____

☐ Slab ☑ Crawl Space ☑ Basement w/plumbing ☐ Basement wo/plumbing


Water Supply: ☐ Individual ☑ Community ☐ Public

Comments: Drainageway must be "cleaned out and properly filled". Very complex site - Everything must be located exactly as shown. ONE GATE VALVE per LATERAL


Comments: PARTIAL 9/26/97

1"=50'

INITIAL SITE SKETCH

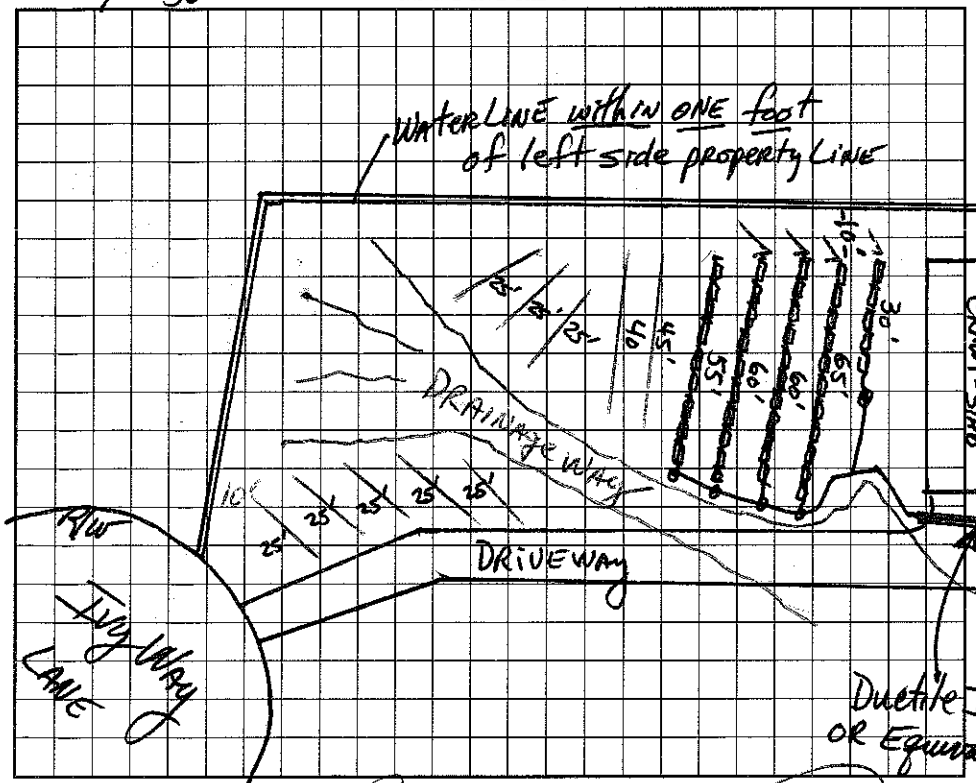

AS BUILT SKETCH

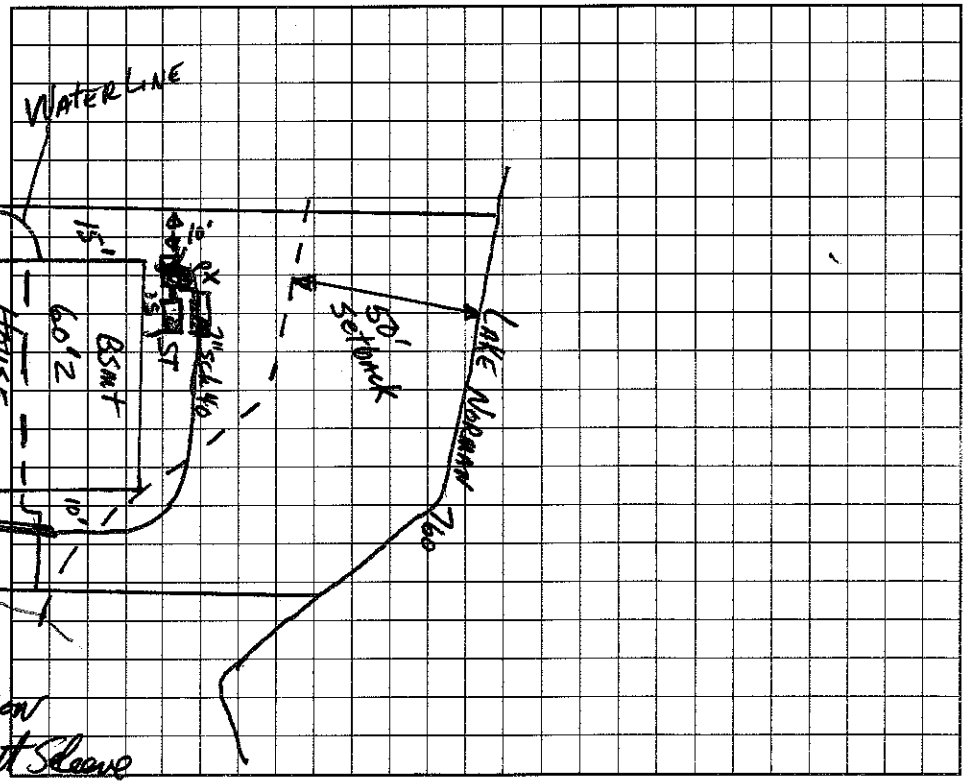

I understand that this permit can be suspended or revoked if any false information is supplied toward securing the permit/any unauthorized changes are made to the site/any unauthorized changes are made in the installation of the system.

Signed: _____

Improvement Permit by: _____, RS date 12-11-95

~~Existing System Inspection~~ CONSTRUCTION by: _____, RS date 2-19-97

Installed by: MacLeod Const.

Certificate of Completion by: Wesley Sparks RS. date 11/14/97

Operation Permit by: Wesley Sparks RS. date 11/14/97

HEALTH DEPT. COPY: WHITE INSPECTION COPY (FINAL): GREEN OWNER COPY (FINAL): YELLOW INSPECTION COPY (INITIAL): PINK OWNER COPY (INITIAL): GOLD