IREDELL COUNTY HEALTH DEPARTMENT ↓ AUTHORIZATION TO CONSTRUCT

STATESVILLE 704-878-5305 MOORESVILLE 704-664-5281

IMPROVEMENT PERMIT / CERTIFICATE OF COMPLETION / OPERATION PERMIT / EXISTING SYSTEM INSPECTI

PROPERTY DESCRIPTION NO. 24530 DATE 8/21/96

OWNER OR CONTRACTOR JOHN WIELAND HOMES TAX MAP NO. 2C-A-3 PT 4625 58 9406 Watershed: ☑ Yes

ADDRESS 400 S. TRYON ST CHARLOTTE NC 28201 PHONE: Business 525-6024 Home

LOCATION BRAWLEY SCHOOL - TL LAKE MIST - 8TH LOT ON LEFT

SUBDIVISION HARBOR BLOCK / SECTION II LOT 8 LOT AREA —

Septic Tank: 1500 Gallons; STB 797 Date 2/21/97

Pump Tank: 1500 Gallons; PT 797 Date 2/21/97

Pump Make: HYDROMATIC Model SHEF 100M3 Serial No. 51871-000

Nitrification Field: No. Fields 1 Square Feet 1512 Linear Feet 304

No. Lines 8 Trench Width 36" Max Trench Bottom Depth 8" Gravel Depth N/A

☑ New System ☐ Repair System Type: I, II, III, IV, V, VI

System Description: PUMP CHAMBERED

Repair System Description: PUMP CHAMBERED

Maintenance Agreement Required: ☐ Yes ☐ No

CLASS. V DESIGN FLOW 600GPD L.T.A.R. .36PD/FT

☑ House/Mod. Home ☐ Mobile Home ☐ Business ☐ Other

No. Bedrooms 5 No. Bathrooms 4 No. Employees


☐ Slab ☐ Crawl Space ☑ Basement w/plumbing ☐ Basement wo/plumbing

Water Sup ☐ Individu ☑ Commur ☐ Public


Comments:

Comments: Set pressure electrical pending 4/22/97
2 Manifold Boxes - 4 lines per box

INITIAL SITE SKETCH 1"=60'

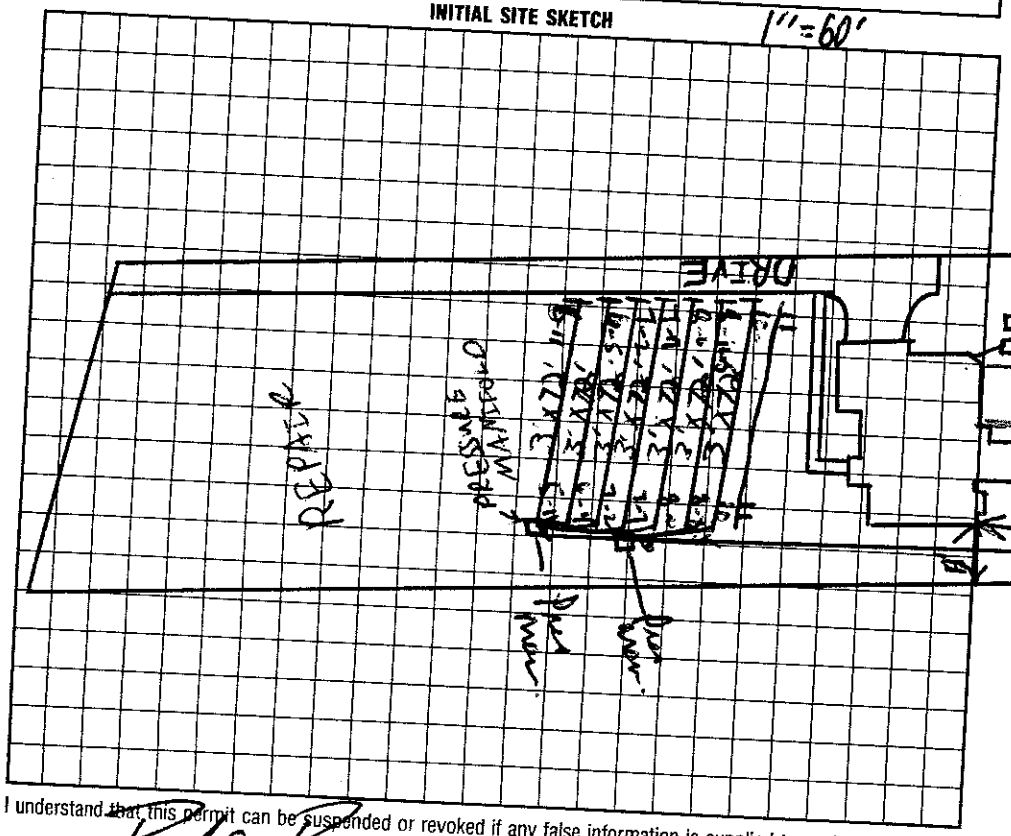

AS BUILT SKETCH

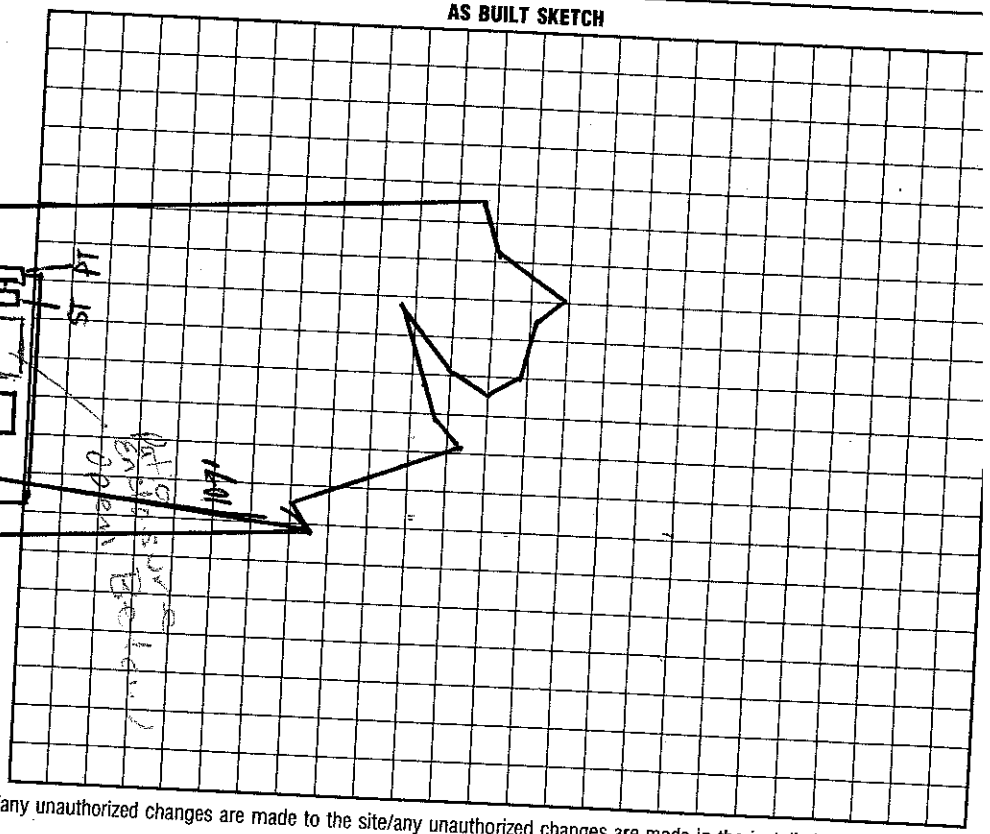

I understand that this permit can be suspended or revoked if any false information is supplied toward securing the permit/any unauthorized changes are made to the site/any unauthorized changes are made in the installation of the system.

Signed: Paul G. Young

Improvement Permit by: C. Ray Reeves EHSI date 8/21/96

4 WITH TO INSTRUCT Existing System Inspection by: C. Ray Reeves EHSI date 8/21/96

Installed by: Macleod Cons.

Certificate of Completion by: date

Operation Permit by: C. Ray Reeves date 7/25/97

HEALTH DEPT. COPY: WHITE INSPECTION COPY (FINAL): GREEN OWNER COPY (FINAL): YELLOW INSPECTION COPY (INITIAL): PINK OWNER COPY (INITIAL): GOLD