(3,00)

IREDELL COUNTY HEALTH DEPARTMENT

↑ AUTHORIZATION TO CONSTRUCT

STATESVILLE 704-878-5305 MOORESVILLE 704-664-5281

IMPROVEMENT PERMIT / ~~CERTIFICATE OF COMPLETION~~ / OPERATION PERMIT / EXISTING SYSTEM INSPECTION

PROPERTY DESCRIPTION NO. 24438 DATE 8/21/96 TAX MAP NO. PT OF 2C-A-3 Watershed: ☑ Yes ☐ No

OWNER OR CONTRACTOR JOHN WIELAND HOMES PHONE: Business 525-6024 Home 4625 58 9557

ADDRESS 400 S TRYON ST. CHARLOTTE, NC 28201

LOCATION BRAWLEY SCHOOL RD. - TR HARBOR - TL LAKE MIST LOT ON LEFT

SUBDIVISION HARBOR BLOCK / SECTION II LOT 7 LOT AREA — SITE CLASS. B DESIGN FLOW 600 GPD L.T.A.R. .36 PD/FT =

Septic Tank: 1500 Gallons; STB 797 Date 2/7/96

Pump Tank: 1500 Gallons; PT 794 Date 4/16/96

Pump Make: HYDROMATIC Model SHEF 100N2 Serial No.

Nitrification Field: No Fields 1 Square Feet 1512 Linear Feet (504)

No Lines 6 Trench Width 36" Max Trench Bottom Depth 36" Gravel Depth N/A

☑ New System ☐ Repair System Type: I, II, (III), IV, V, VI

System Description: PUMP CHAMBERED

Repair System Description: PUMP CHAMBERED

Maintenance Agreement Required: ☐ Yes ☑ No

☐ Slab ☑ Crawl Space ☑ Basement w/plumbing ☐ Basement wo/plumbing

☑ House/Mod. Home No. Bedrooms 5

☐ Mobile Home No. Bathrooms 4

☐ Business No. Employees

☐ Other

Water Supply: ☐ Individual ☑ Community ☐ Public


Comments:

Comments: TANKS - LINES CHECKED


MANIFOLD BUILD SYSTEM TO 2 @ 4 lines each

Electrical pending - 4/22/97

INITIAL SITE SKETCH 1"=60'

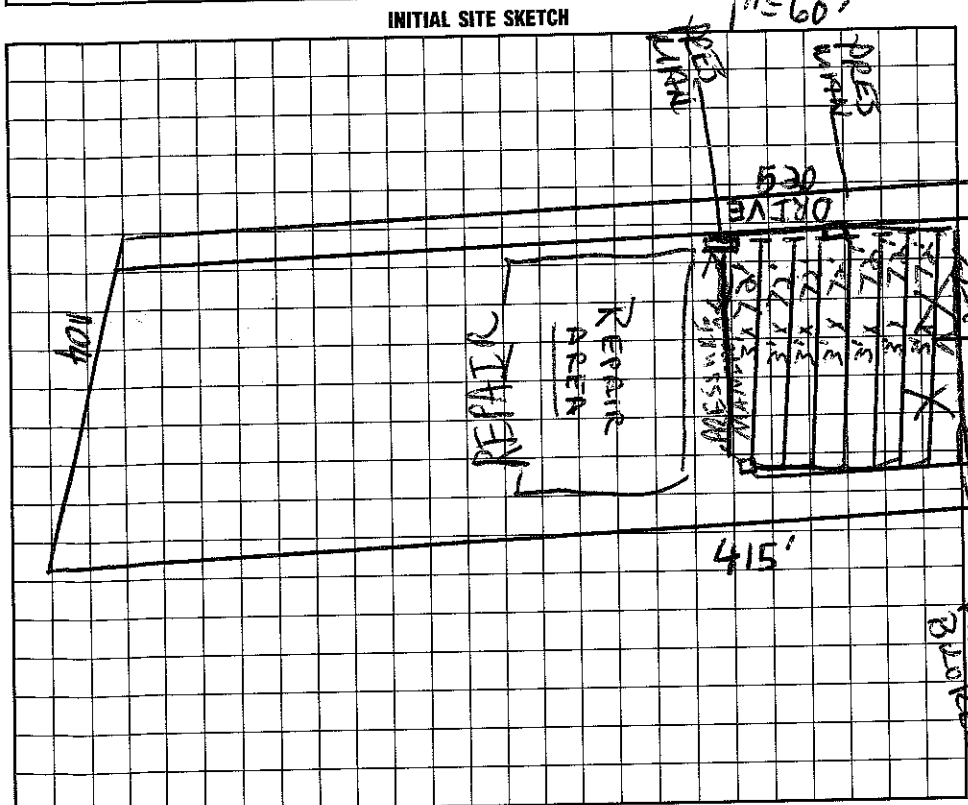

AS BUILT SKETCH

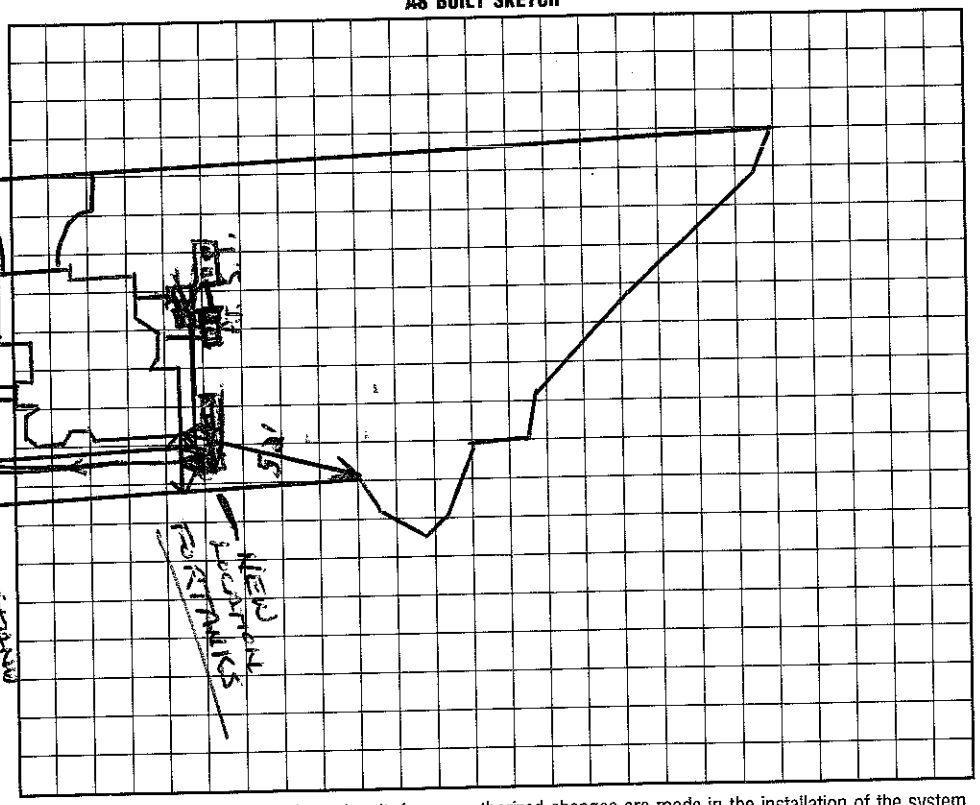

I understand ~~that this permit can be~~ Suspended or revoked if any false information is supplied toward securing the permit/any unauthorized changes are made to the site/any unauthorized changes are made in the installation of the system.

Signed: Kelly C. Penny

Installed by: MacLeod Const

Improvement Permit by: C. Bly Freeman EHSI date 8/21/96

Certificate of Completion by: Wesley Sparks RS. date 5/22/97

~~Existing System Inspection by:~~ AUTHORIZATION TO CONSTRUCT C. Bly Freeman EHSI date 8/21/96

Operation Permit by: Wesley Sparks RS. date 5/22/97

HEALTH DEPT. COPY: WHITE INSPECTION COPY (FINAL): GREEN OWNER COPY (FINAL): YELLOW INSPECTION COPY (INITIAL): PINK OWNER COPY (INITIAL): GOLD