IREDELL COUNTY HEALTH DEPARTMENT

Authorization to Construct

STATESVILLE 704-878-5305 MOORESVILLE 704-664-5281

IMPROVEMENT PERMIT / ~~CERTIFICATE OF COMPLETION~~ / OPERATION PERMIT / EXISTING SYSTEM INSPECTION

PROPERTY DESCRIPTION NO. 24427 DATE 2/26/97 TAX MAP NO. 2C A 3 Pt of 4625589697 Watershed: X Yes ☐ No

OWNER OR CONTRACTOR John Wieland Homes PHONE: Business 525-6024 Home

ADDRESS 400 S Tryon St. Charlotte, NC. 28201

LOCATION 1100 TR Bay Harbour Ln Lake West to 6th lot on (L)

SUBDIVISION Harbour BLOCK / SECTION II LOT 6 LOT AREA ≥1AC SITE CLASS. PS DESIGN FLOW 480 L.T.A.R. .3

Septic Tank: 1000 Gallons; STB 794 Date 12/3/96

Pump Tank: 1000 Gallons; PT 27 Date 1/25/97

Pump Make: HYDROMATIC Model SK50M1 Serial No. —

Nitrification Field: No Fields 1 Square Feet 1200* Linear Feet 400*

No Lines 6 Trench Width 36" Max Trench Bottom Depth 36" Gravel Depth SAND

X New System ☐ Repair System Type: I, II, III, IV, V, VI

System Description: PressMan-Ch. Plastic

Repair System Description: Same

Maintenance Agreement Required: ☐ Yes X No

X House/Mod. Home No. Bedrooms 4

☐ Mobile Home No. Bathrooms 3

☐ Business No. Employees

☐ Other


☐ Slab X Crawl Space ☐ Basement w/plumbing ☐ Basement wo/plumbing

Water Supply: ☐ Individual X Community ☐ Public


Comments: Ch. Plastic receives 25% reduction in square footage required

Comments:

INITIAL SITE SKETCH

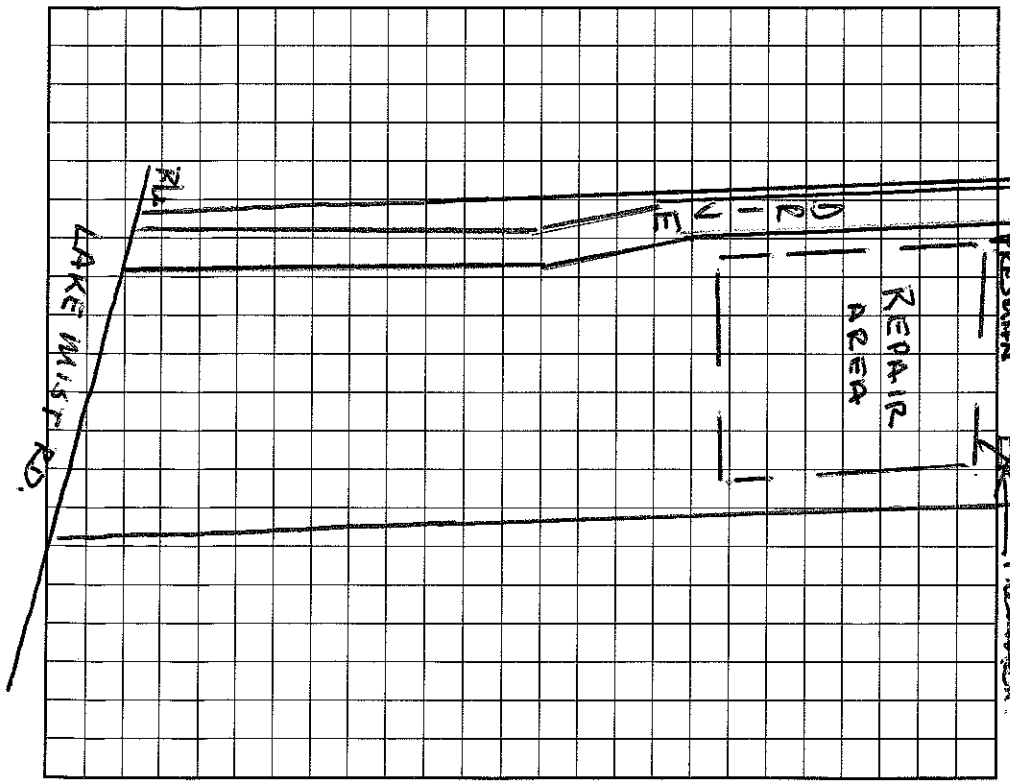

AS BUILT SKETCH

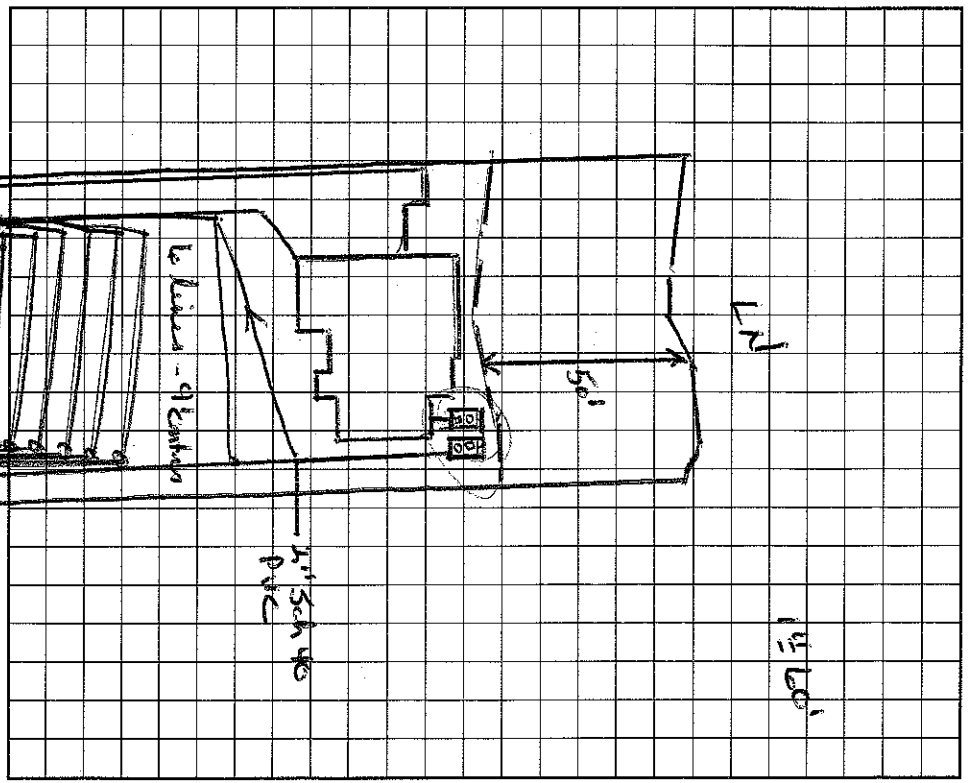

I understand that this permit can be suspended or revoked if any false information is supplied toward securing the permit/any unauthorized changes are made to the site/any unauthorized changes are made in the installation of the system.

Signed: * Copy given to Macleod Const.

Improvement Permit by: Wesley Sparks RS. date 2/26/97

Existing System Inspection by: Wesley Sparks RS date 2/26/97

Installed by: Macleod Const. Co.

Certificate of Completion by: Wesley Sparks RS date 4/10/97

Operation Permit by: Wesley Sparks RS. date 4/10/97

Authorization

HEALTH DEPT. COPY: WHITE INSPECTION COPY (FINAL): GREEN OWNER COPY (FINAL): YELLOW INSPECTION COPY (INITIAL): PINK OWNER COPY (INITIAL): GOLD