IREDELL COUNTY HEALTH DEPARTMENT

Authorization to construct

STATESVILLE 704-878-5305 MOORESVILLE 704-664-5281

IMPROVEMENT PERMIT / ~~CERTIFICATE OF COMPLETION~~ / OPERATION PERMIT / EXISTING SYSTEM INSPECTION

PROPERTY DESCRIPTION NO. 24825 DATE 10/6/97 TAX MAP NO. 2C-1-3 pt of 4625589997 Watershed: ☒ Yes ☐ No

OWNER OR CONTRACTOR JOHN WIELAND HOMES PHONE: Business 663-6405 T JACOBS Home

ADDRESS 8325 ARROWROCK BLVD. CHARLOTTE NC 28273

LOCATION BRAWLEY SCHOOL RD - TR BAY HARBOUR - TL LAKE MIST - 5TH LOT ON LT

SUBDIVISION HARBOUR BLOCK / SECTION II LOT 3 LOT AREA SITE CLASS. PS DESIGN FLOW 480 GPD L.T.A.R. .36 GPD/FT

Septic Tank: 1000 Gallons; STB 794 Date 12/5/97

Pump Tank: 1000 Gallons; PT 27 Date 1/5/97

Pump Make: ~~H4~~ ORENET Model SHEF50A Serial No. 1198

Nitrification Field: No Fields 1 Square Feet 1600 Linear Feet 533

No Lines 8 Trench Width 36" Max Trench Bottom Depth 36" Gravel Depth 12"

☒ New System ☐ Repair System Type: I, II, ☒ III, IV, V, VI

System Description: PUMP CONVENTIONAL

Repair System Description: PUMP PANEL

Maintenance Agreement Required: ☐ Yes ☒ No

☒ House/Mod. Home No. Bedrooms 4

☐ Mobile Home No. Bathrooms 4

☐ Business No. Employees

☐ Other

☐ Slab ☒ Crawl Space ☐ Basement w/plumbing ☐ Basement wo/plumbing


Water Supply: ☐ Individual ☒ Community ☐ Public

Comments: SYSTEM MAY GO CLOSER TO STREET.


Comments: 3/13/98 Fill material over top 3 trench lines ~3' deep

INITIAL SITE SKETCH

1" = 60'

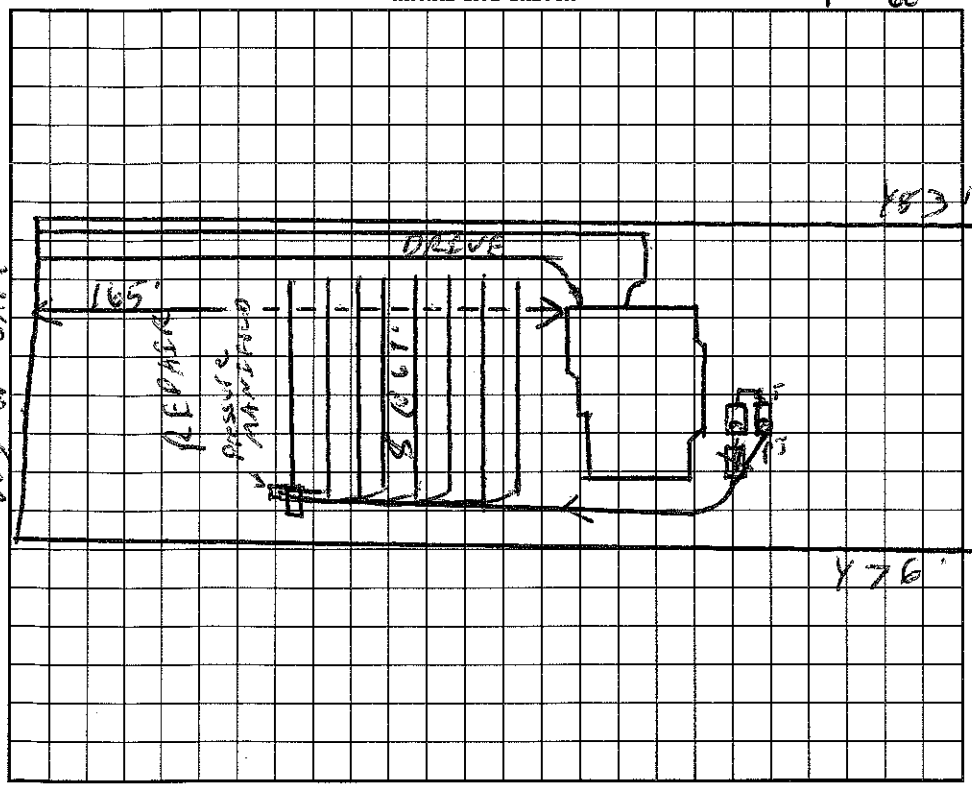

AS BUILT SKETCH

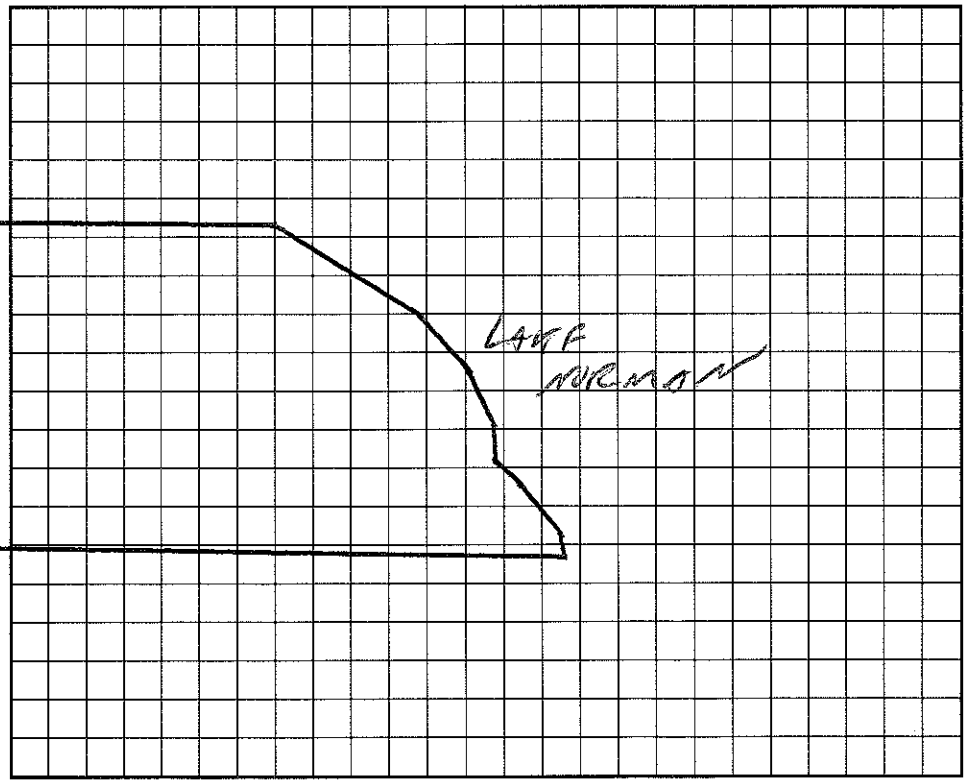

I understand that ~~this~~ permit can be suspended or revoked if any false information is supplied toward securing the permit/any unauthorized changes are made to the site/any unauthorized changes are made in the installation of the system. Improvement Permit is valid for ~~60~~ months from date of issuance.

Signed:

Improvement Permit by: C. [illegible] date 10/6/97

~~Existing System Inspection by:~~ Authorization to construct C. [illegible] date 10/6/97

Installed by: R L MacLeod

Certificate of Completion by: Wesley Sparks RS date 3/13/98

Operation Permit by: Wesley Sparks RS date 3/13/98

HEALTH DEPT. COPY: WHITE INSPECTION COPY (FINAL): GREEN OWNER COPY (FINAL): YELLOW INSPECTION COPY (INITIAL): PINK OWNER COPY (INITIAL): GOLD