IREDELL COUNTY HEALTH DEPARTMENT

Authorization to Construct

STATESVILLE 704-878-5305 MOORESVILLE 704-664-5281

IMPROVEMENT PERMIT / ~~CERTIFICATE OF COMPLETION~~ / OPERATION PERMIT / EXISTING SYSTEM INSPECTION

PROPERTY DESCRIPTION NO. 20260 DATE 10/8/96 TAX MAP NO. Pt of 2FC5 Watershed: X Yes ☐ No

OWNER OR CONTRACTOR ~~P.O. Box 100~~ M.I. Hoopes PHONE: Business 872-6714 ~~Home~~ 4623-59-0546

ADDRESS 1043 E. Morehead St. Mooresville, NC.

LOCATION Sunrise Cir. - Brunswick TR Bay Harbour TL Lake Mist TR Sunrise on (E)

SUBDIVISION HARBOUR BLOCK / SECTION 1 LOT 45 LOT AREA 25,000 FT² SITE CLASS. PS DESIGN FLOW 480 L.T.A.R. .3

Septic Tank: 1000 Gallons; STB 794 Date 8/2/96

Pump Tank: _____ Gallons; PT _____ Date _____

Pump Make: _____ Model _____ Serial No. _____

Nitrification Field: No Fields 1 Square Feet 1600 Linear Feet 400 *

No Lines 8 Trench Width 36" Max Trench Bottom Depth 36" Gravel Depth SAND

X New System ☐ Repair System Type: I, II, III, IV, V, VI

System Description: *Ch PLASTIC

Repair System Description: SAME

Maintenance Agreement Required: ☐ Yes X No

X House/Mod. Home No. Bedrooms 4

☐ Mobile Home No. Bathrooms 4

☐ Business No. Employees _____

☐ Other _____


☐ Slab X Crawl Space ☐ Basement w/plumbing ☐ Basement wo/plumbing

Water Supply: X Individual X Community ☐ Public


Comments: * 25% reduction

Comments: Repair

INITIAL SITE SKETCH

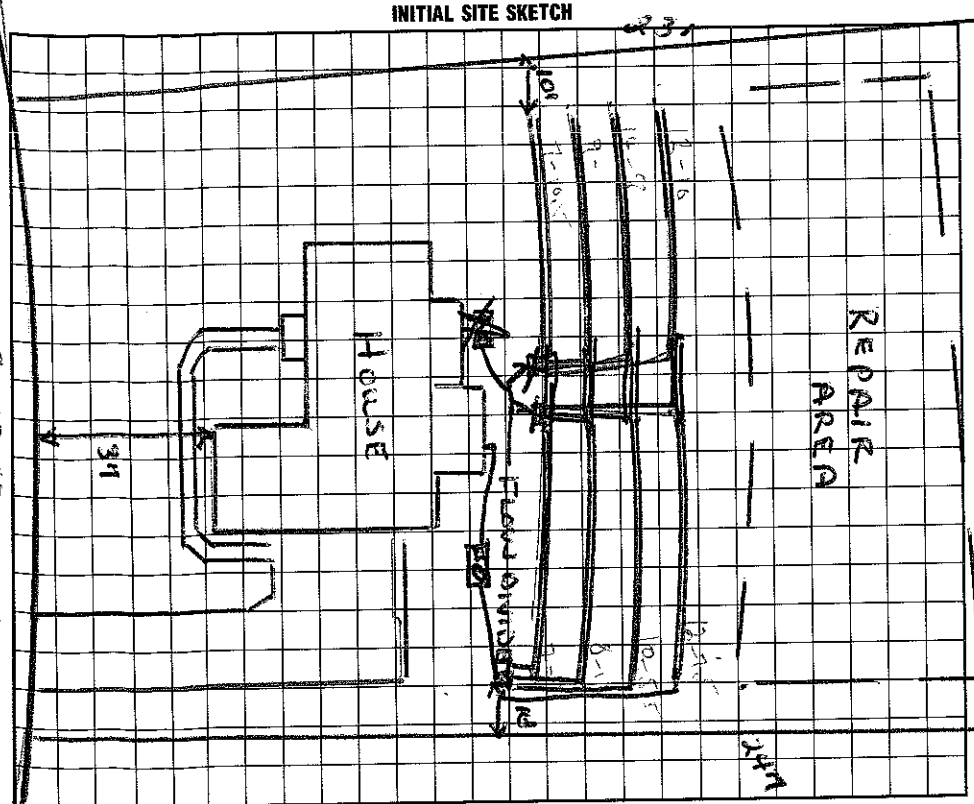

AS BUILT SKETCH

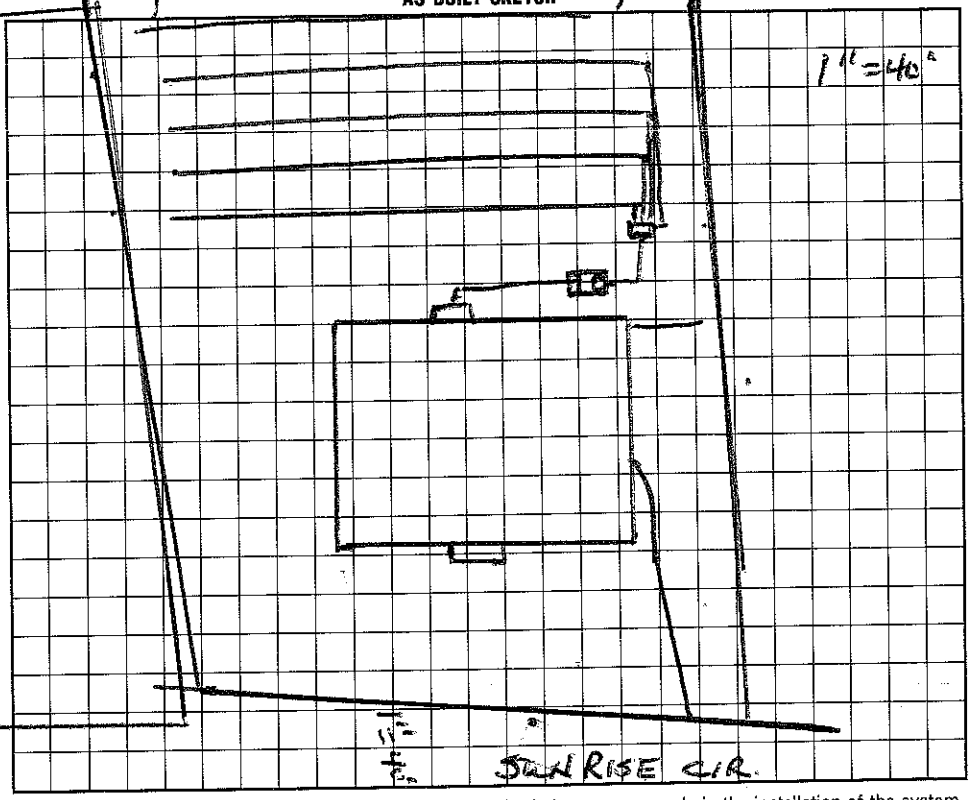

I understand that this permit can be suspended or ~~revoked~~ if any false information is supplied toward securing the permit/any unauthorized changes are made to the site/any unauthorized changes are made in the installation of the system.

Signed: *

Improvement Permit by: Wesley Sparks RS. date 10/8/96

Existing System Inspection by: Wesley Sparks RS. date 10/8/96

Installed by: Macleod Const.

Certificate of Completion by: _____ date _____

Operation Permit by: Wesley Sparks RS. date 10/22/96

HEALTH DEPT. COPY: WHITE INSPECTION COPY (FINAL): GREEN OWNER COPY (FINAL): YELLOW INSPECTION COPY (INITIAL): PINK OWNER COPY (INITIAL): GOLD