IREDELL COUNTY HEALTH DEPARTMENT

Authorization to Construct

STATESVILLE 704-878-5305 MOORESVILLE 704-664-5281

IMPROVEMENT PERMIT / ~~CERTIFICATE OF COMPLETION~~ / OPERATION PERMIT / EXISTING SYSTEM INSPECTION

PROPERTY DESCRIPTION NO. 18982 DATE April 4, 1996 TAX MAP NO. part of 2FC5 4625590855 Watershed: ☑ Yes ☐ No

OWNER OR CONTRACTOR Crescent Resources Inc SAWSSY Burdett PHONE: Business _____ Home _____

ADDRESS PO Box 1003, Charlotte

LOCATION 1100 Th Bay Harbour Dr. lot in cul-d-sac of Beach Fern Ct. - Sewer easement at corner of Bay Harbour & Beach Fern

SUBDIVISION The Harbour BLOCK / SECTION map C ① LOT 69, 69A LOT AREA ~1348/846' easement SITE CLASS. RSpec. 1996 DESIGN FLOW 480 gpd L.T.A.R. .3 (easement)

Septic Tank: 1000 Gallons; STB 794 Date 5/23/96

Pump Tank: 1000 Gallons; PT 27 Date 10/13/96

Pump Make: Norwesco Model Shef Sc A1 Serial No. _____

Nitrification Field: No Fields 1 Square Feet 1200 Linear Feet 400

No Lines 5 @ 80' Trench Width 36" Max Trench Bottom Depth ≈24" Gravel Depth N/A

☑ New System ☐ Repair System Type: I, II, III, IV, V, VI

System Description: pumped - pm - chambered

Repair System Description: LP PPBPS

Maintenance Agreement Required: ☐ Yes ☑ No initially

☑ House/Mod. Home No. Bedrooms 4

☐ Mobile Home No. Bathrooms 4

☐ Business No. Employees _____

☐ Other _____


☐ Slab ☑ Crawl Space ☐ Basement w/plumbing ☐ Basement wo/plumbing

Water Supply: ☐ Individual ☑ Community ☐ Public


Comments: Redraw of permit issued 1-6-95. Change from 3 bedrooms to 4 bedrooms / - manifold type changed from conventional to chambered.

Comments: 11/21/96 - Drainfield checked - AWS
11/22/96 - SIT PIT checked - AWS

INITIAL SITE SKETCH 1"=100'

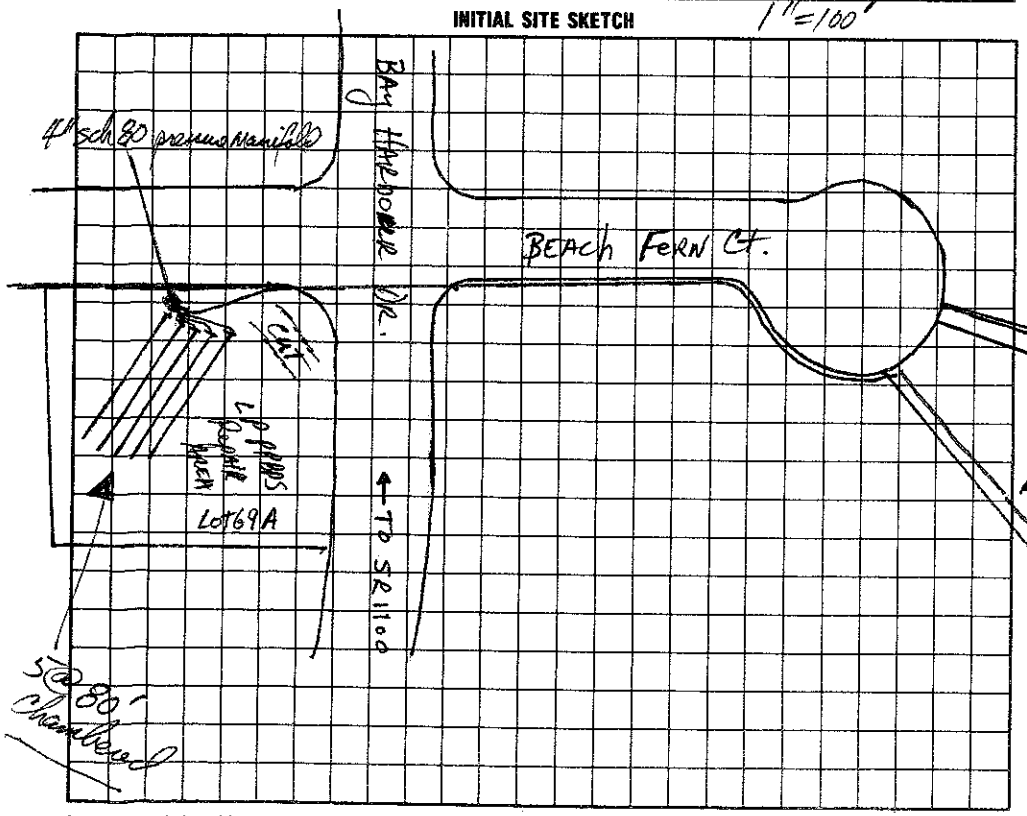

AS BUILT SKETCH

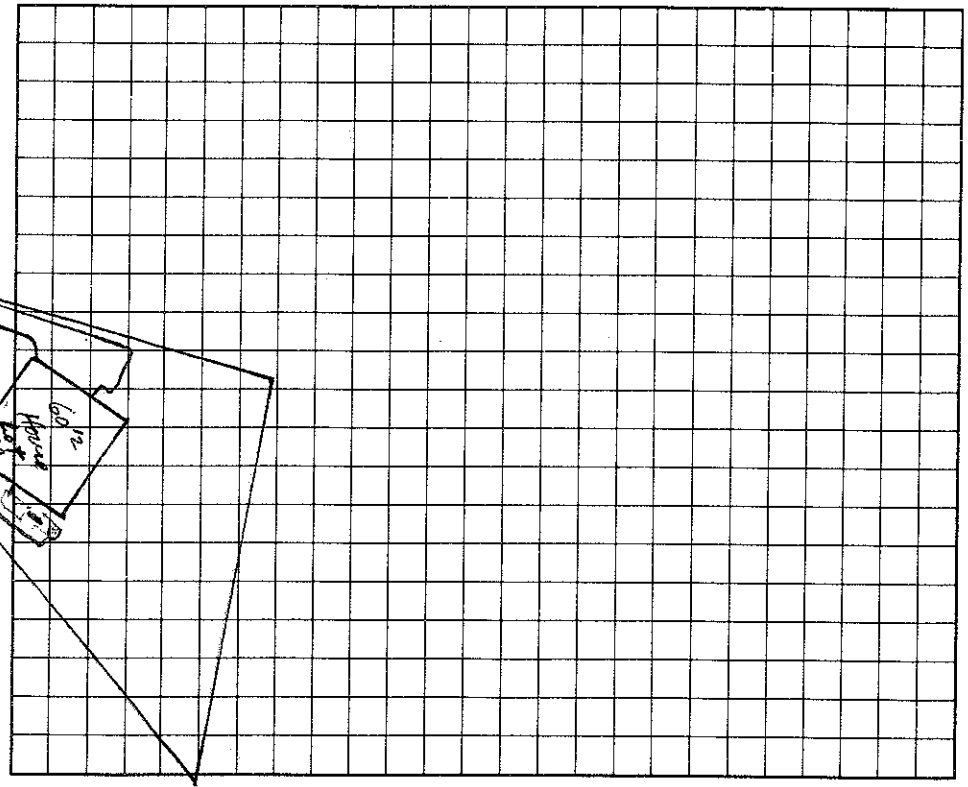

I understand that this permit can be suspended or revoked if any false information is supplied toward securing the permit/any unauthorized changes are made to the site/any unauthorized changes are made in the installation of the system.

Signed: Ellen Shore Authorization to construct valid 5 years.

Improvement Permit by: David R Hanson, RS date 4-4-96

~~Existing System Inspection by:~~ Construction Authorization by: Wesley Sparks RS. date 4/10/96

Installed by: Macleod Const.

Certificate of Completion by: Wesley Sparks RS. date 2/17/97

Operation Permit by: Wesley Sparks RS date 2/17/97

HEALTH DEPT. COPY: WHITE INSPECTION COPY (FINAL): GREEN OWNER COPY (FINAL): YELLOW INSPECTION COPY (INITIAL): PINK OWNER COPY (INITIAL): GOLD