# IREDELL COUNTY HEALTH DEPARTMENT

STATESVILLE 704-878-5305 MOORESVILLE 704-664-5281

## IMPROVEMENT PERMIT / CERTIFICATE OF COMPLETION / OPERATION PERMIT / EXISTING SYSTEM INSPECTION

PROPERTY DESCRIPTION NO. 20887 DATE May 19, '95 TAX MAP NO. 2CA3 4625 59 1375 Watershed: ☑ Yes ☐ No WS IV

OWNER OR CONTRACTOR MI Homes PHONE: Business Home

ADDRESS 1043 E. Morehead St, #105, Charlotte NC

LOCATION Grayson Rd. TR Bay Harbour TL Lake Mist TR Sunrise Circle

SUBDIVISION The Harbour BLOCK / SECTION 1 LOT 27 LOT AREA 29,568 ft² SITE CLASS. PS on 1956 DESIGN FLOW 480 gpd L.T.A.R. .3

Septic Tank: 1000 Gallons; STB 794 Date 7/6/95

Pump Tank: 1000 Gallons; PT 27 Date 8/16/95

Pump Make: Model Serial No.

Nitrification Field: No Fields 1 Square Feet 1200 Linear Feet 400

No Lines 5@80' Trench Width 36" Max Trench Bottom Depth 36" Gravel Depth N/A

☑ New System ☐ Repair System Type: I, II, III, IV, V, VI

System Description: pumped Infiltrator

Repair System Description: Same

Maintenance Agreement Required: ☐ Yes ☐ No

☑ House/Mod. Home No. Bedrooms 4

☐ Mobile Home No. Bathrooms 2.5

☐ Business No. Employees

☐ Other


☐ Slab ☑ Crawl Space ☐ Basement w/plumbing ☐ Basement wo/plumbing

Water Supply: ☐ Individual ☑ Community ☐ Public

Comments: Sch 80 pressure manifold w/ 5 (½") trips 6" o.c. SEE ME for details DRH

Comments:

**INITIAL SITE SKETCH**

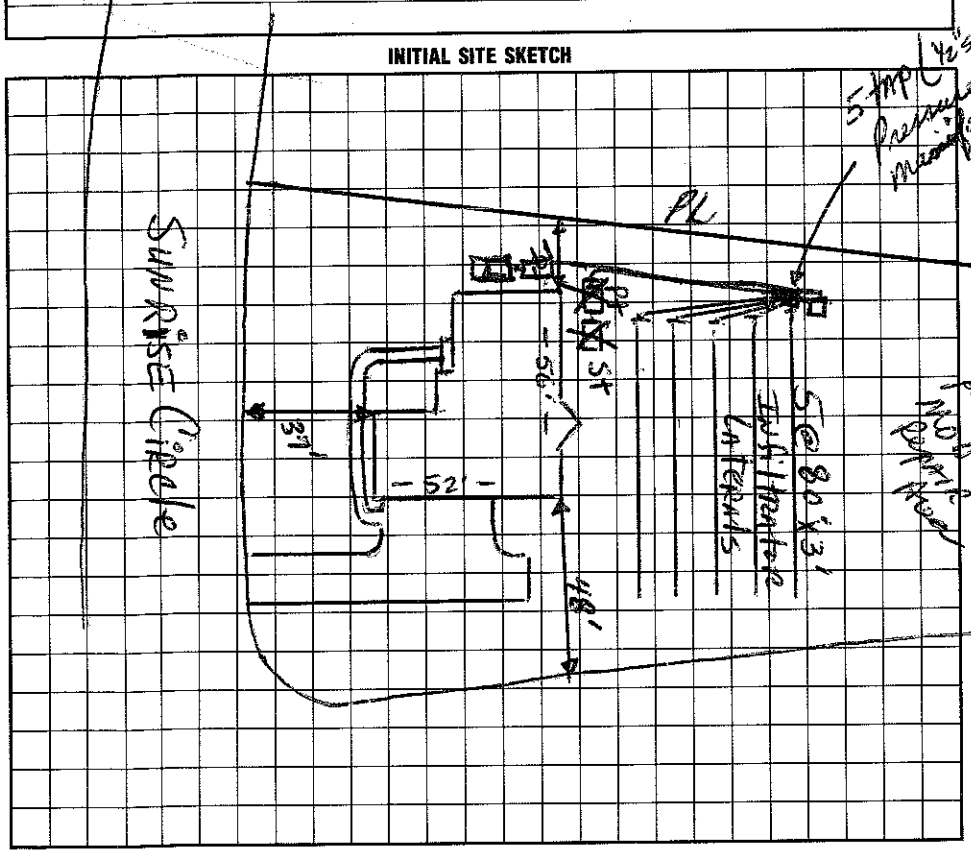


**AS BUILT SKETCH**

I understand that this permit can be suspended or revoked if any false information is supplied toward securing the permit/any unauthorized changes are made to the site/any unauthorized changes are made in the installation of the system. Improvement Permit is valid for 60 months from date of issuance.

Signed: MENCAC

Improvement Permit by: [signature] REHS date 5/19/95

Existing System Inspection by: date

Installed by: Macleod Const.

Certificate of Completion by: Wesley Sparks R.S. date 5/22/97

Operation Permit by: Wesley Sparks R.S. date 5/22/97

HEALTH DEPT. COPY: WHITE INSPECTION COPY (FINAL): GREEN OWNER COPY (FINAL): YELLOW INSPECTION COPY (INITIAL): PINK OWNER COPY (INITIAL): GOLD